


#22582
 APPROVED
 LORAIN CO.
 MAP DEPT.
 DATE 7/13/98
 PAGE 5-H
 BY TJS
 VOID AFTER 22582

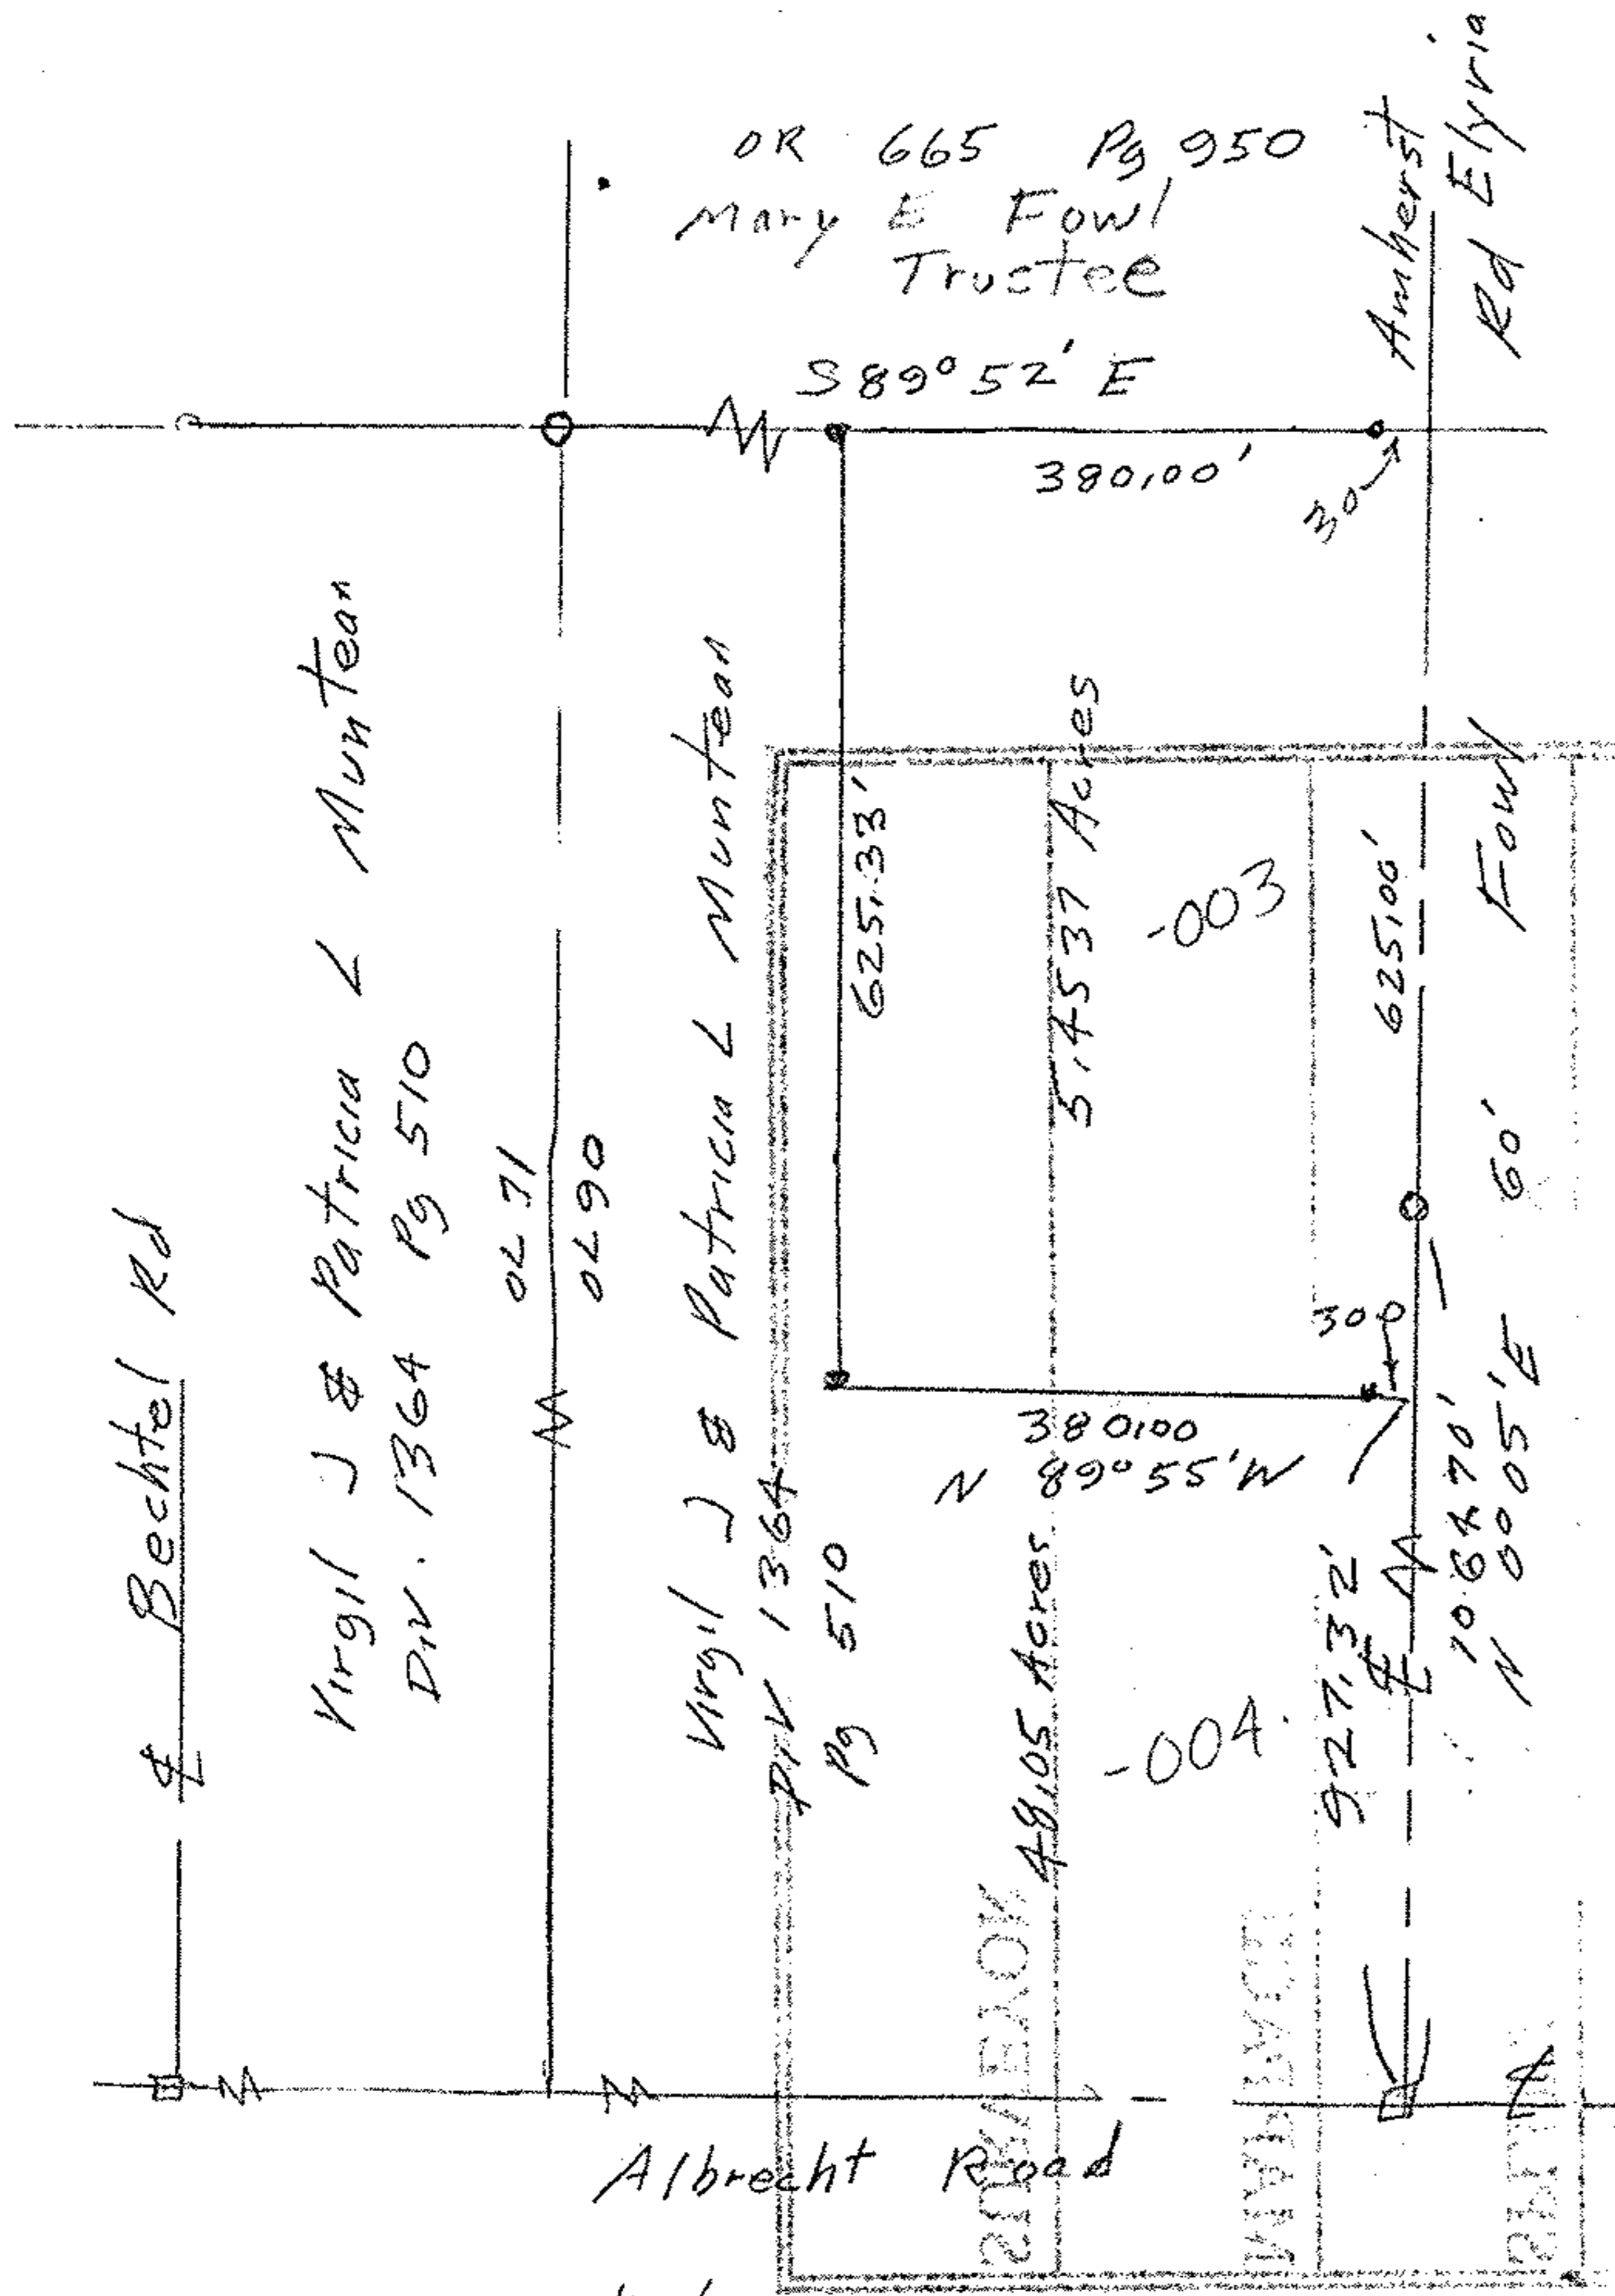

OR 665 Pg 950
 Mary E Fowl
 Trustee

Bechtel Rd
 Virgil J & Patricia L Muntean
 DIV. 1364 Pg 510

Virgil J & Patricia L Muntean
 DIV. 1364 Pg 510

Albrecht Road

Amherst Rd Elyria

Fowl

□ monument boxes
 ○ iron pins set
 STATE OF OHIO
 JOHN POZYWAK
 5292 REGISTERED SURVEYOR

Survey of a parcel split
 for
 Virgil Muntean
 Original Lot 90
 Amherst Township
 Lorain County Ohio
 Scale 1" = 200' May 1998
 John Pozywak
 Reg Surveyor 5292