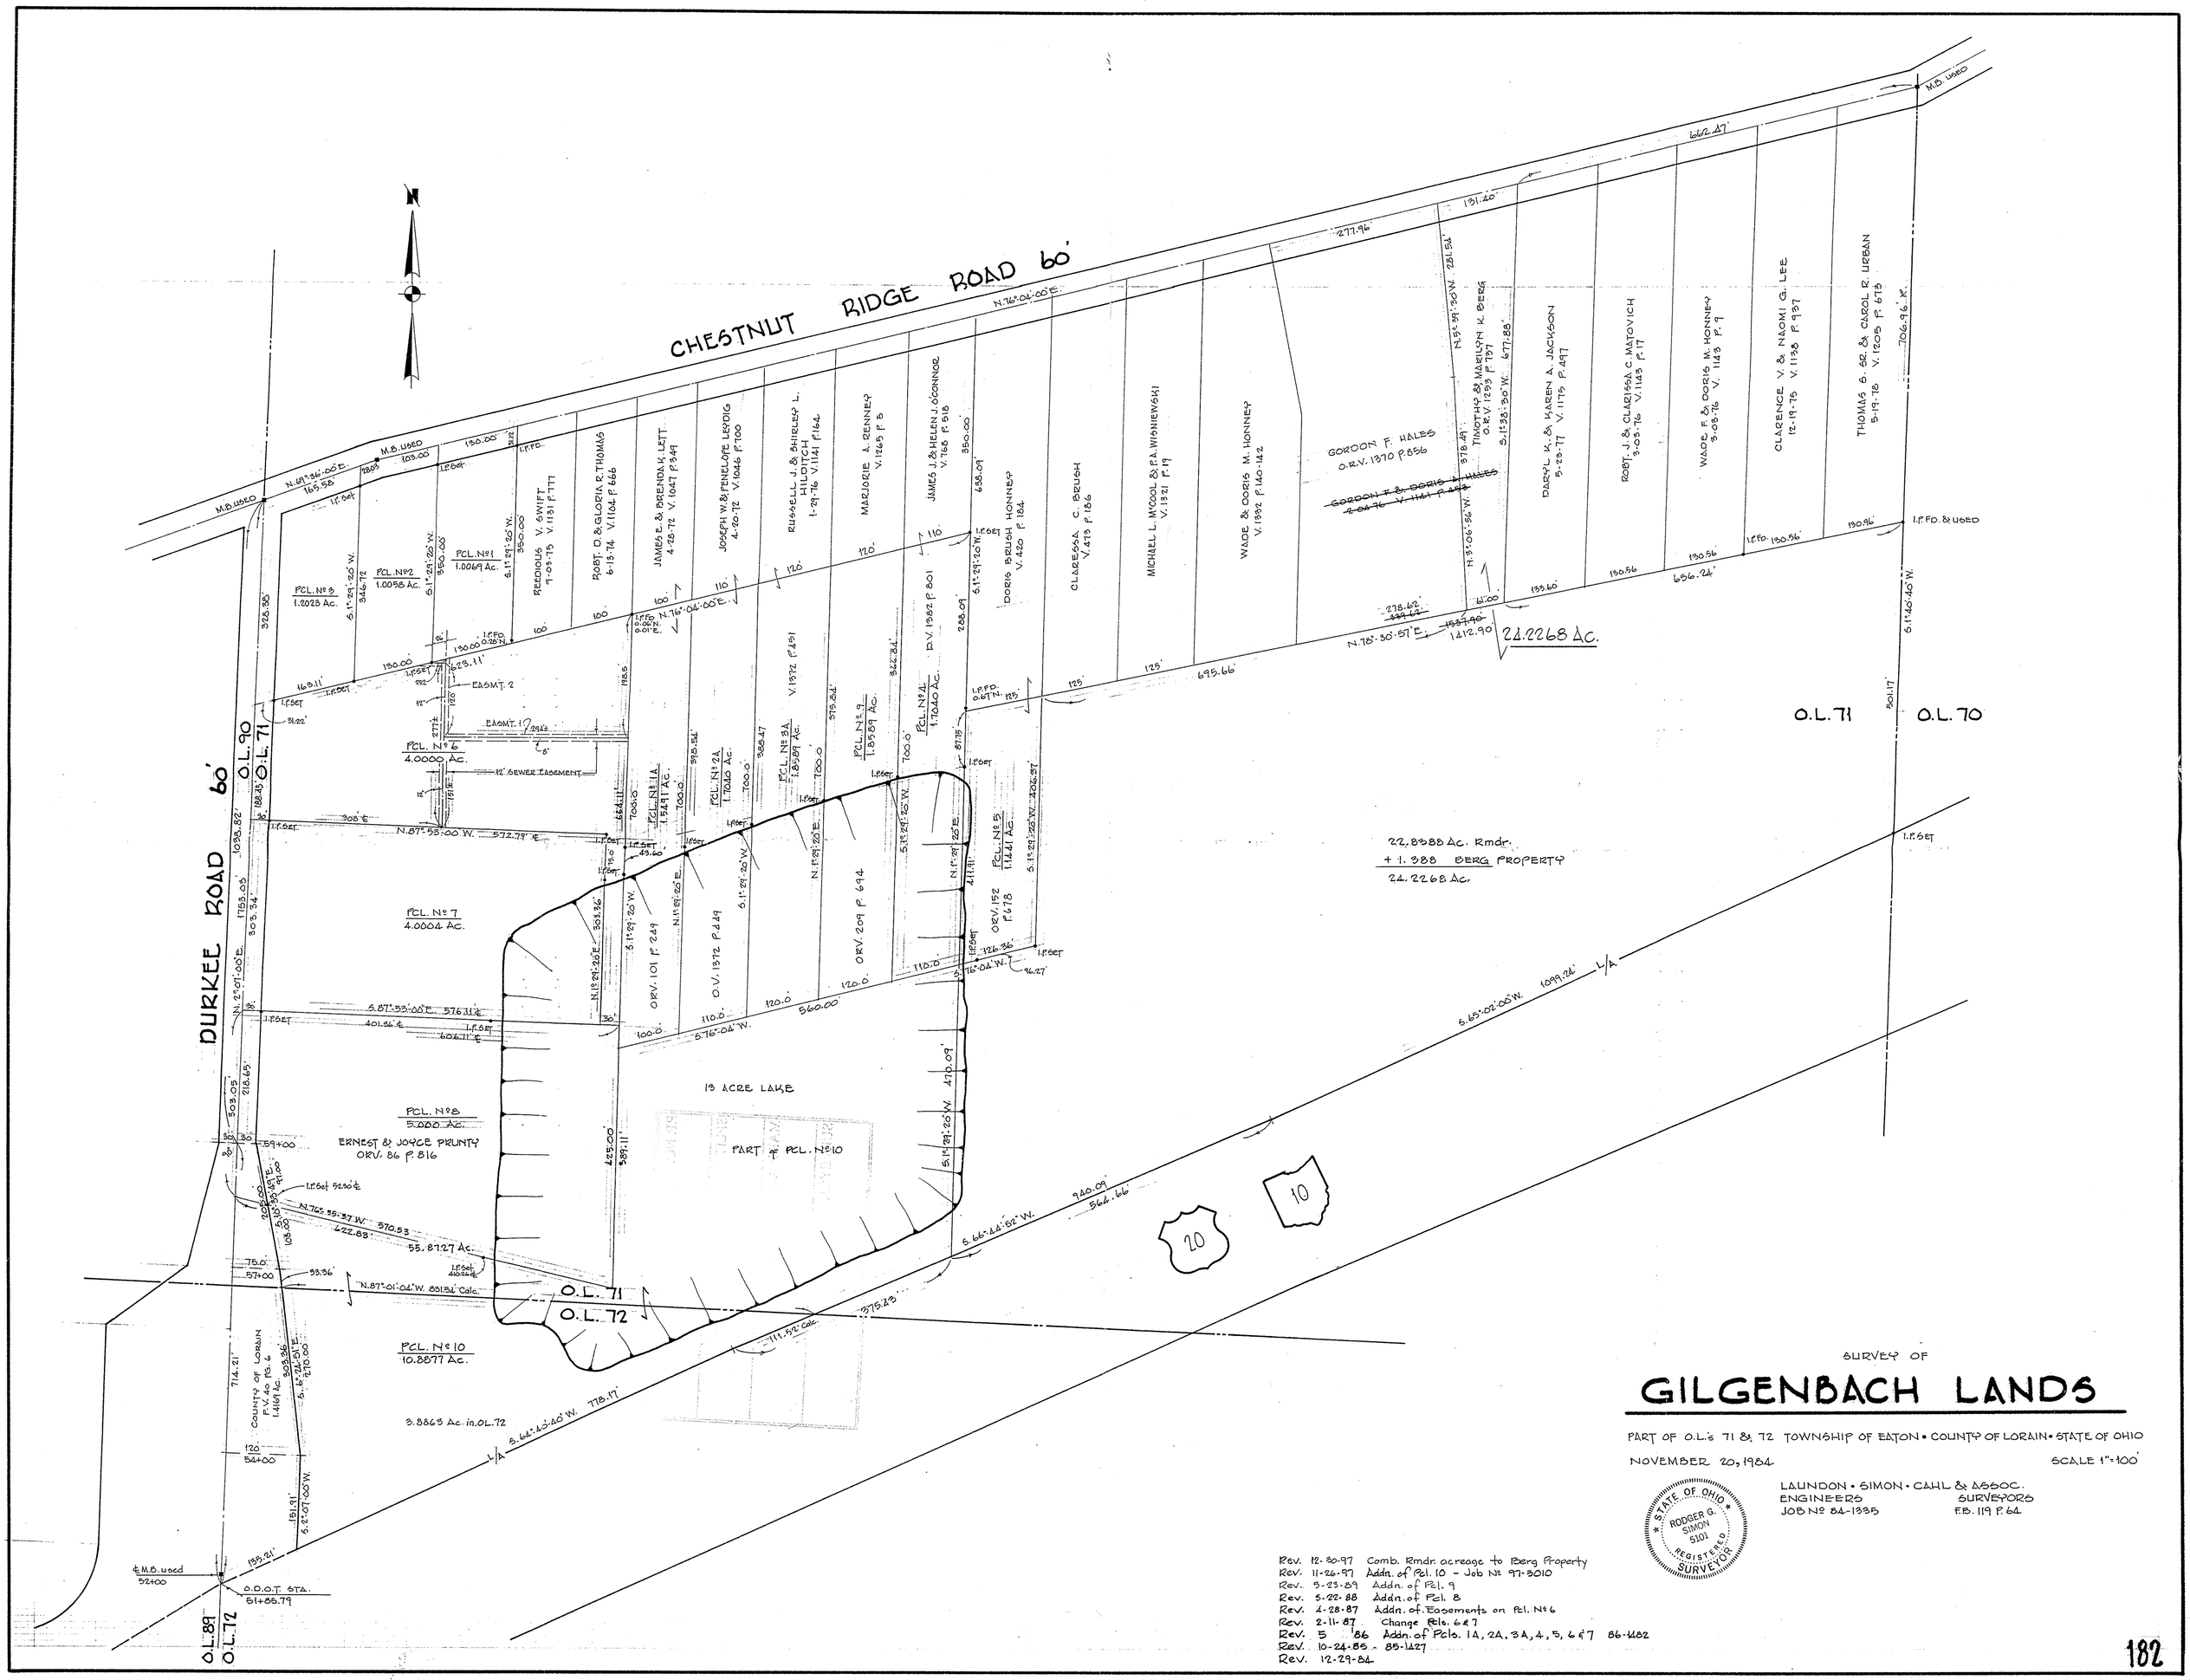

SURVEY OF

GILGENBACH LANDS

PART OF O.L.'s 71 & 72 TOWNSHIP OF EATON • COUNTY OF LORAIN • STATE OF OHIO

NOVEMBER 20, 1984 SCALE 1" = 100'

STATE OF OHIO
RODGER G. SIMON
5101
REGISTERED SURVEYOR

LAUNDON • SIMON • CAHL & ASSOC.
ENGINEERS SURVEYORS
JOB Nº 84-1335 F.B. 119 P. 64

Rev. 12-30-97 Comb. Rmdr. acreage to Berg Property
Rev. 11-26-97 Addn. of Pcl. 10 - Job Nº 97-3010
Rev. 5-23-89 Addn. of Pcl. 9
Rev. 5-22-88 Addn. of Pcl. 8
Rev. 4-28-87 Addn. of Easements on Pcl. Nº 6
Rev. 2-11-87 Change Pcls. 6 & 7
Rev. 5-'86 Addn. of Pcls. 1A, 2A, 3A, 4, 5, 6 & 7 86-1182
Rev. 10-24-85 - 85-1427
Rev. 12-29-84