SURVEY
OF PART OF
ORIGINAL RIDGEVILLE
TWP LOT 32

CITY OF N. RIDGEVILLE COUNTY OF LORAIN
STATE OF OHIO

DATE DEC 1995
SCALE 1"=100

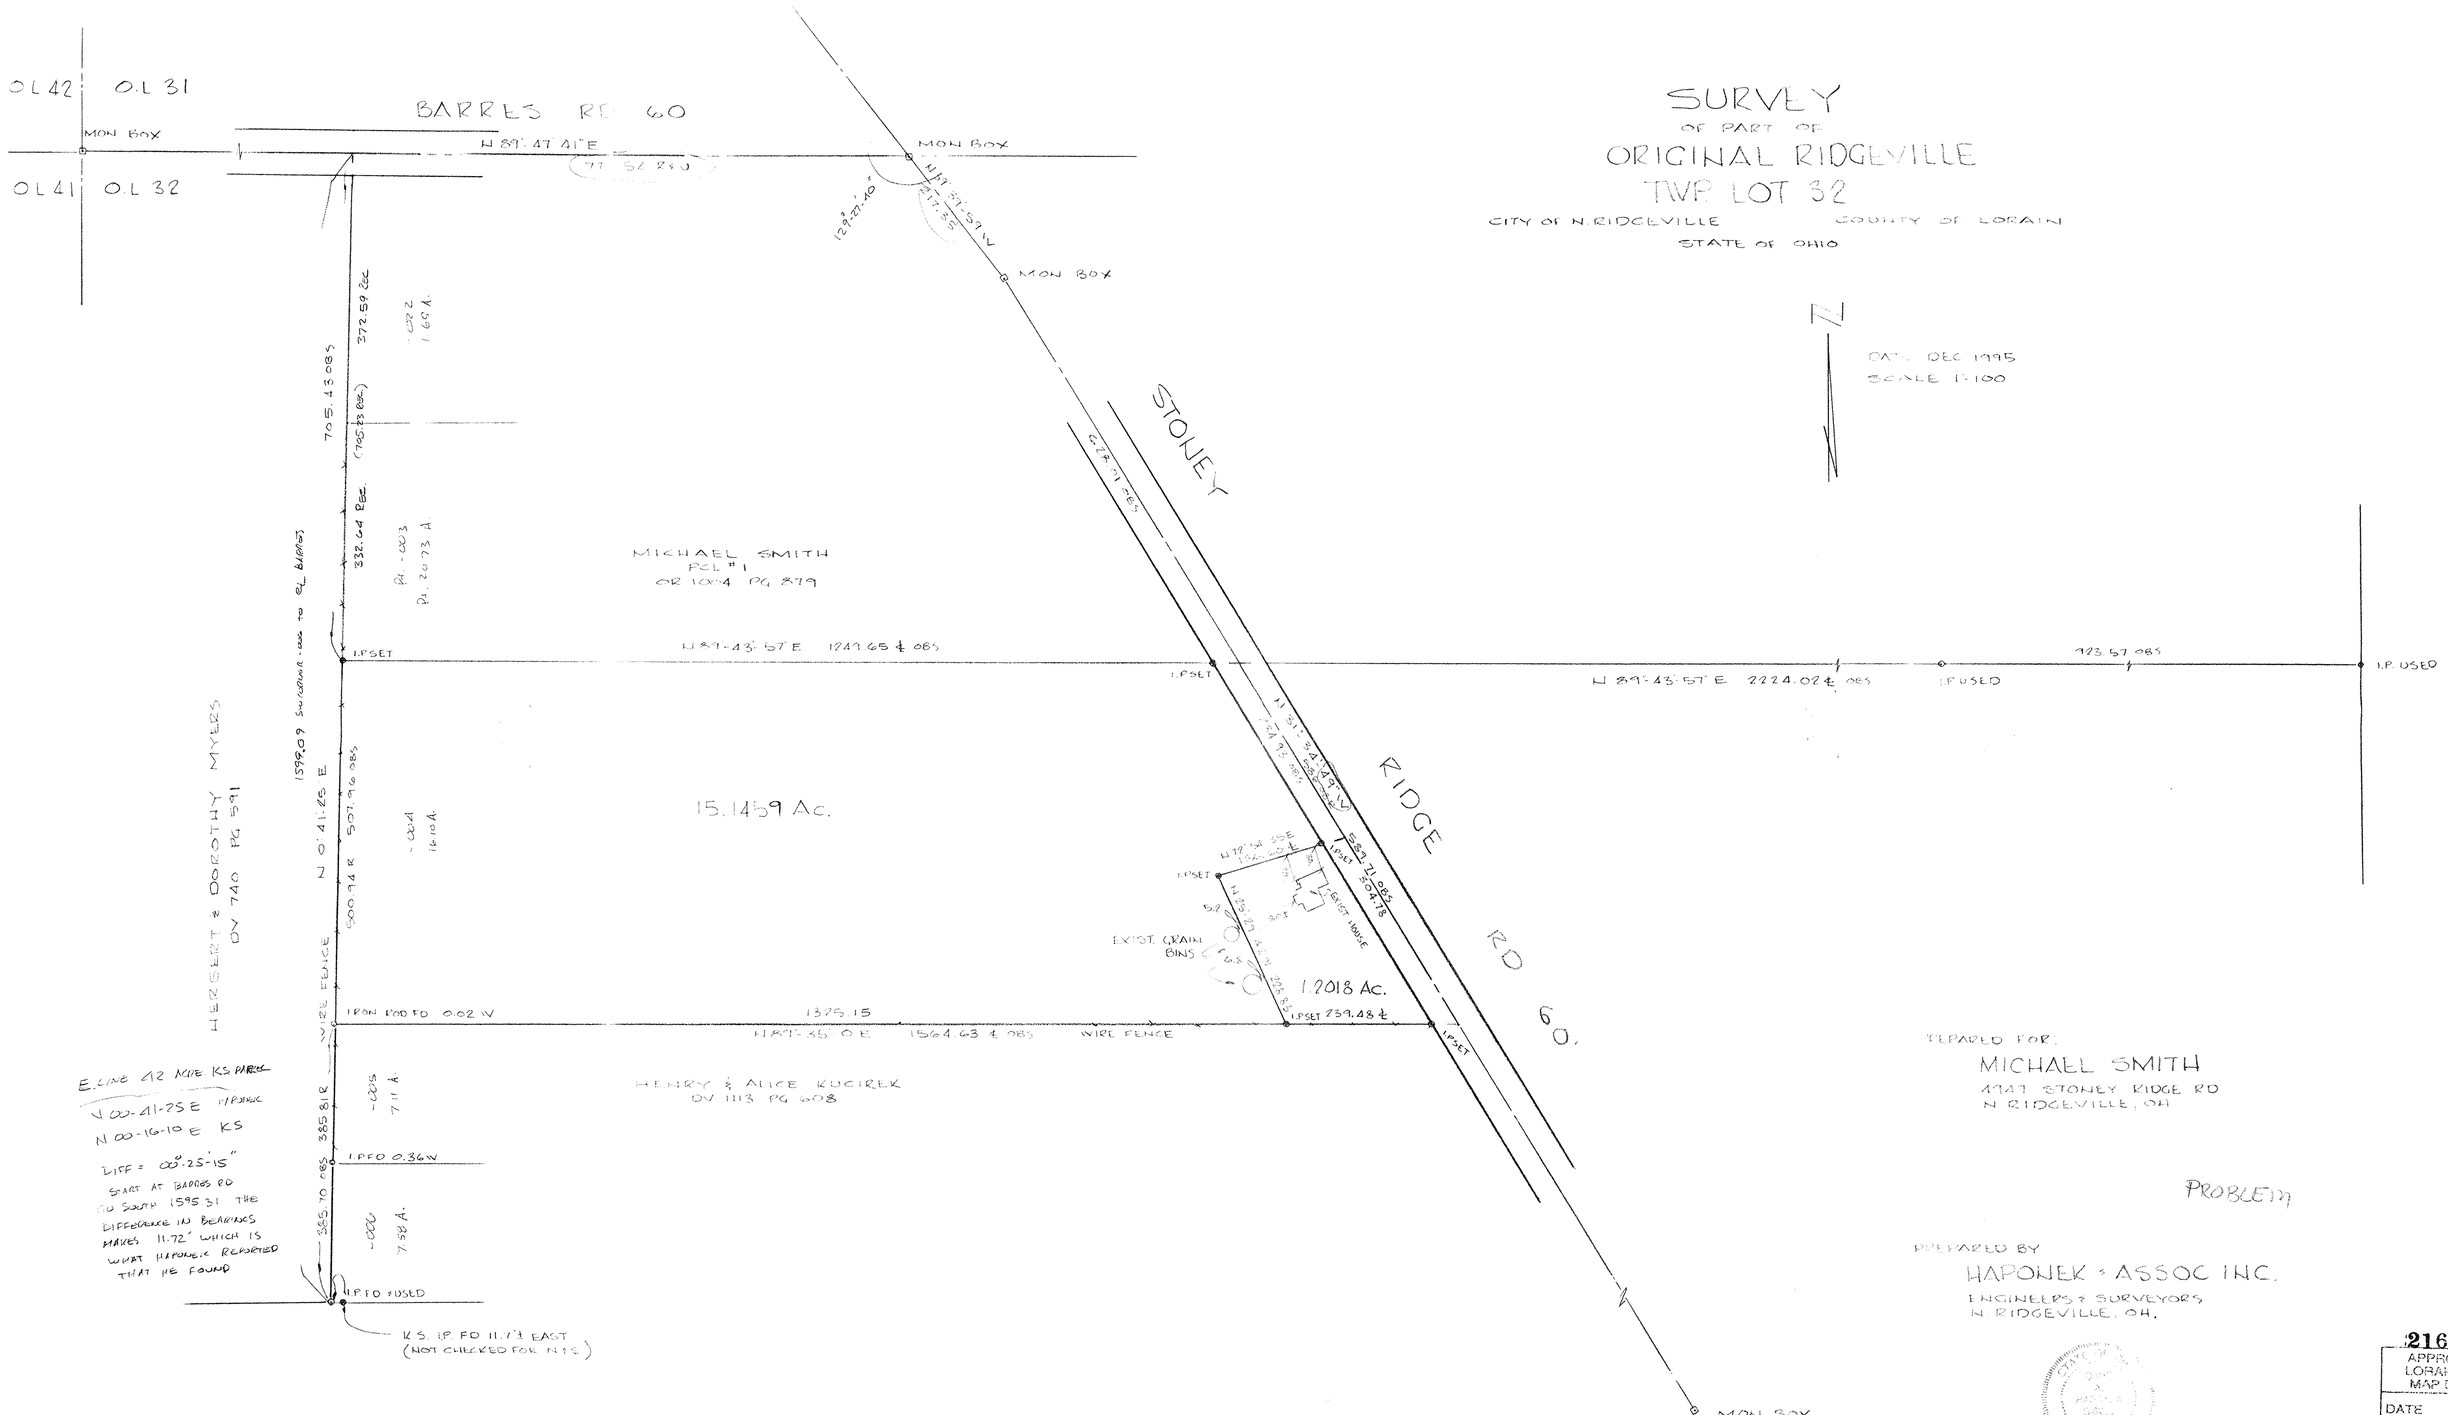

E. LINE 42 MPE KS PARCEL
N 00-41-25 E HAPONEK
N 00-16-10 E KS
DIFF = 00°-25'-15"
START AT BARRES RD GO SOUTH 1595.31 THE DIFFERENCE IN BEARINGS MAKES 11.72' WHICH IS WHAT HAPONEK REPORTED THAT HE FOUND

PREPARED FOR:
MICHAEL SMITH
4747 STONEY RIDGE RD
N RIDGEVILLE, OH

PROBLEM

PREPARED BY
HAPONEK & ASSOC INC.
ENGINEERS & SURVEYORS
N. RIDGEVILLE, OH.

STATE OF OHIO
HAPONEK
SURVEYOR

21662
APPROVED
LORAIN CO.
MAP DEPT
DATE
PAGE
BY

79-66