

STATE JOB NUMBER	F.H.W.A. DISTRICT	STATE	PROJECT
03452(0)	5	OHIO	M-9C00(1)

133  
142

LORAIN COUNTY  
CITY OF AVON LAKE  
AVON TOWNSHIP  
SECTION 19  
T-7N R-16W

9  
12




OVERLAPPED AREA SEE SHEET 8B

P.P.# 04-00-019-14-058 &  
-059  
-060  
-061

P.P.# 04-00-019-144-057

Existing Channel Easement as recorded in Vol. 1402, Page 96 of the Lorain Co. Records.

Anthony M. Pilla,  
Bishop of Cleveland

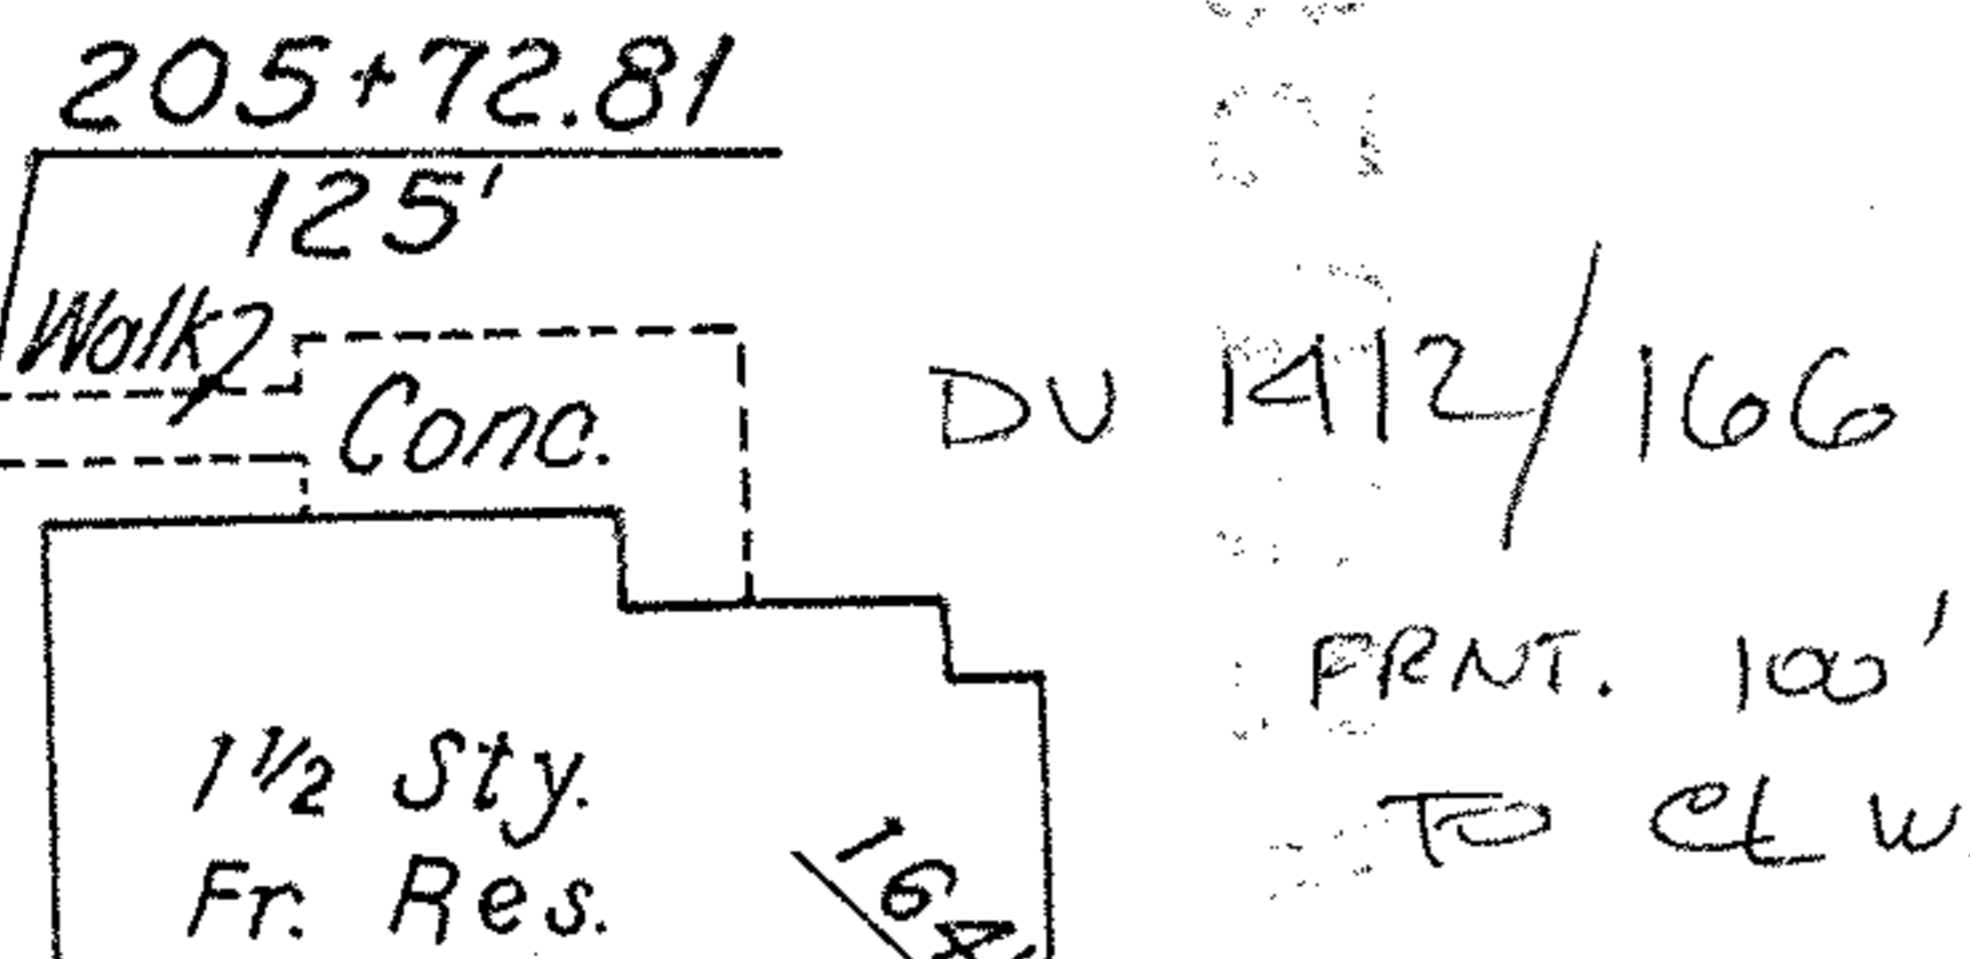

Diocese of Cleveland  
(Anthony M. Pilla, Bishop of Cleveland)


Cont. = 1,000 S.F.  
P.R.O. = 1,000 S.F.  
Total = 2,000 S.F.

Cont. = 2,504 S.F.  
P.R.O. = 2,504 S.F.  
Total = 5,008 S.F.

Cont. = 750 S.F.

Michael Liptak  
Cont. = 2,500 S.F.  
P.R.O. = 2,500 S.F.  
Total = 5,000 S.F.

Cont. = 1,664 S.F.

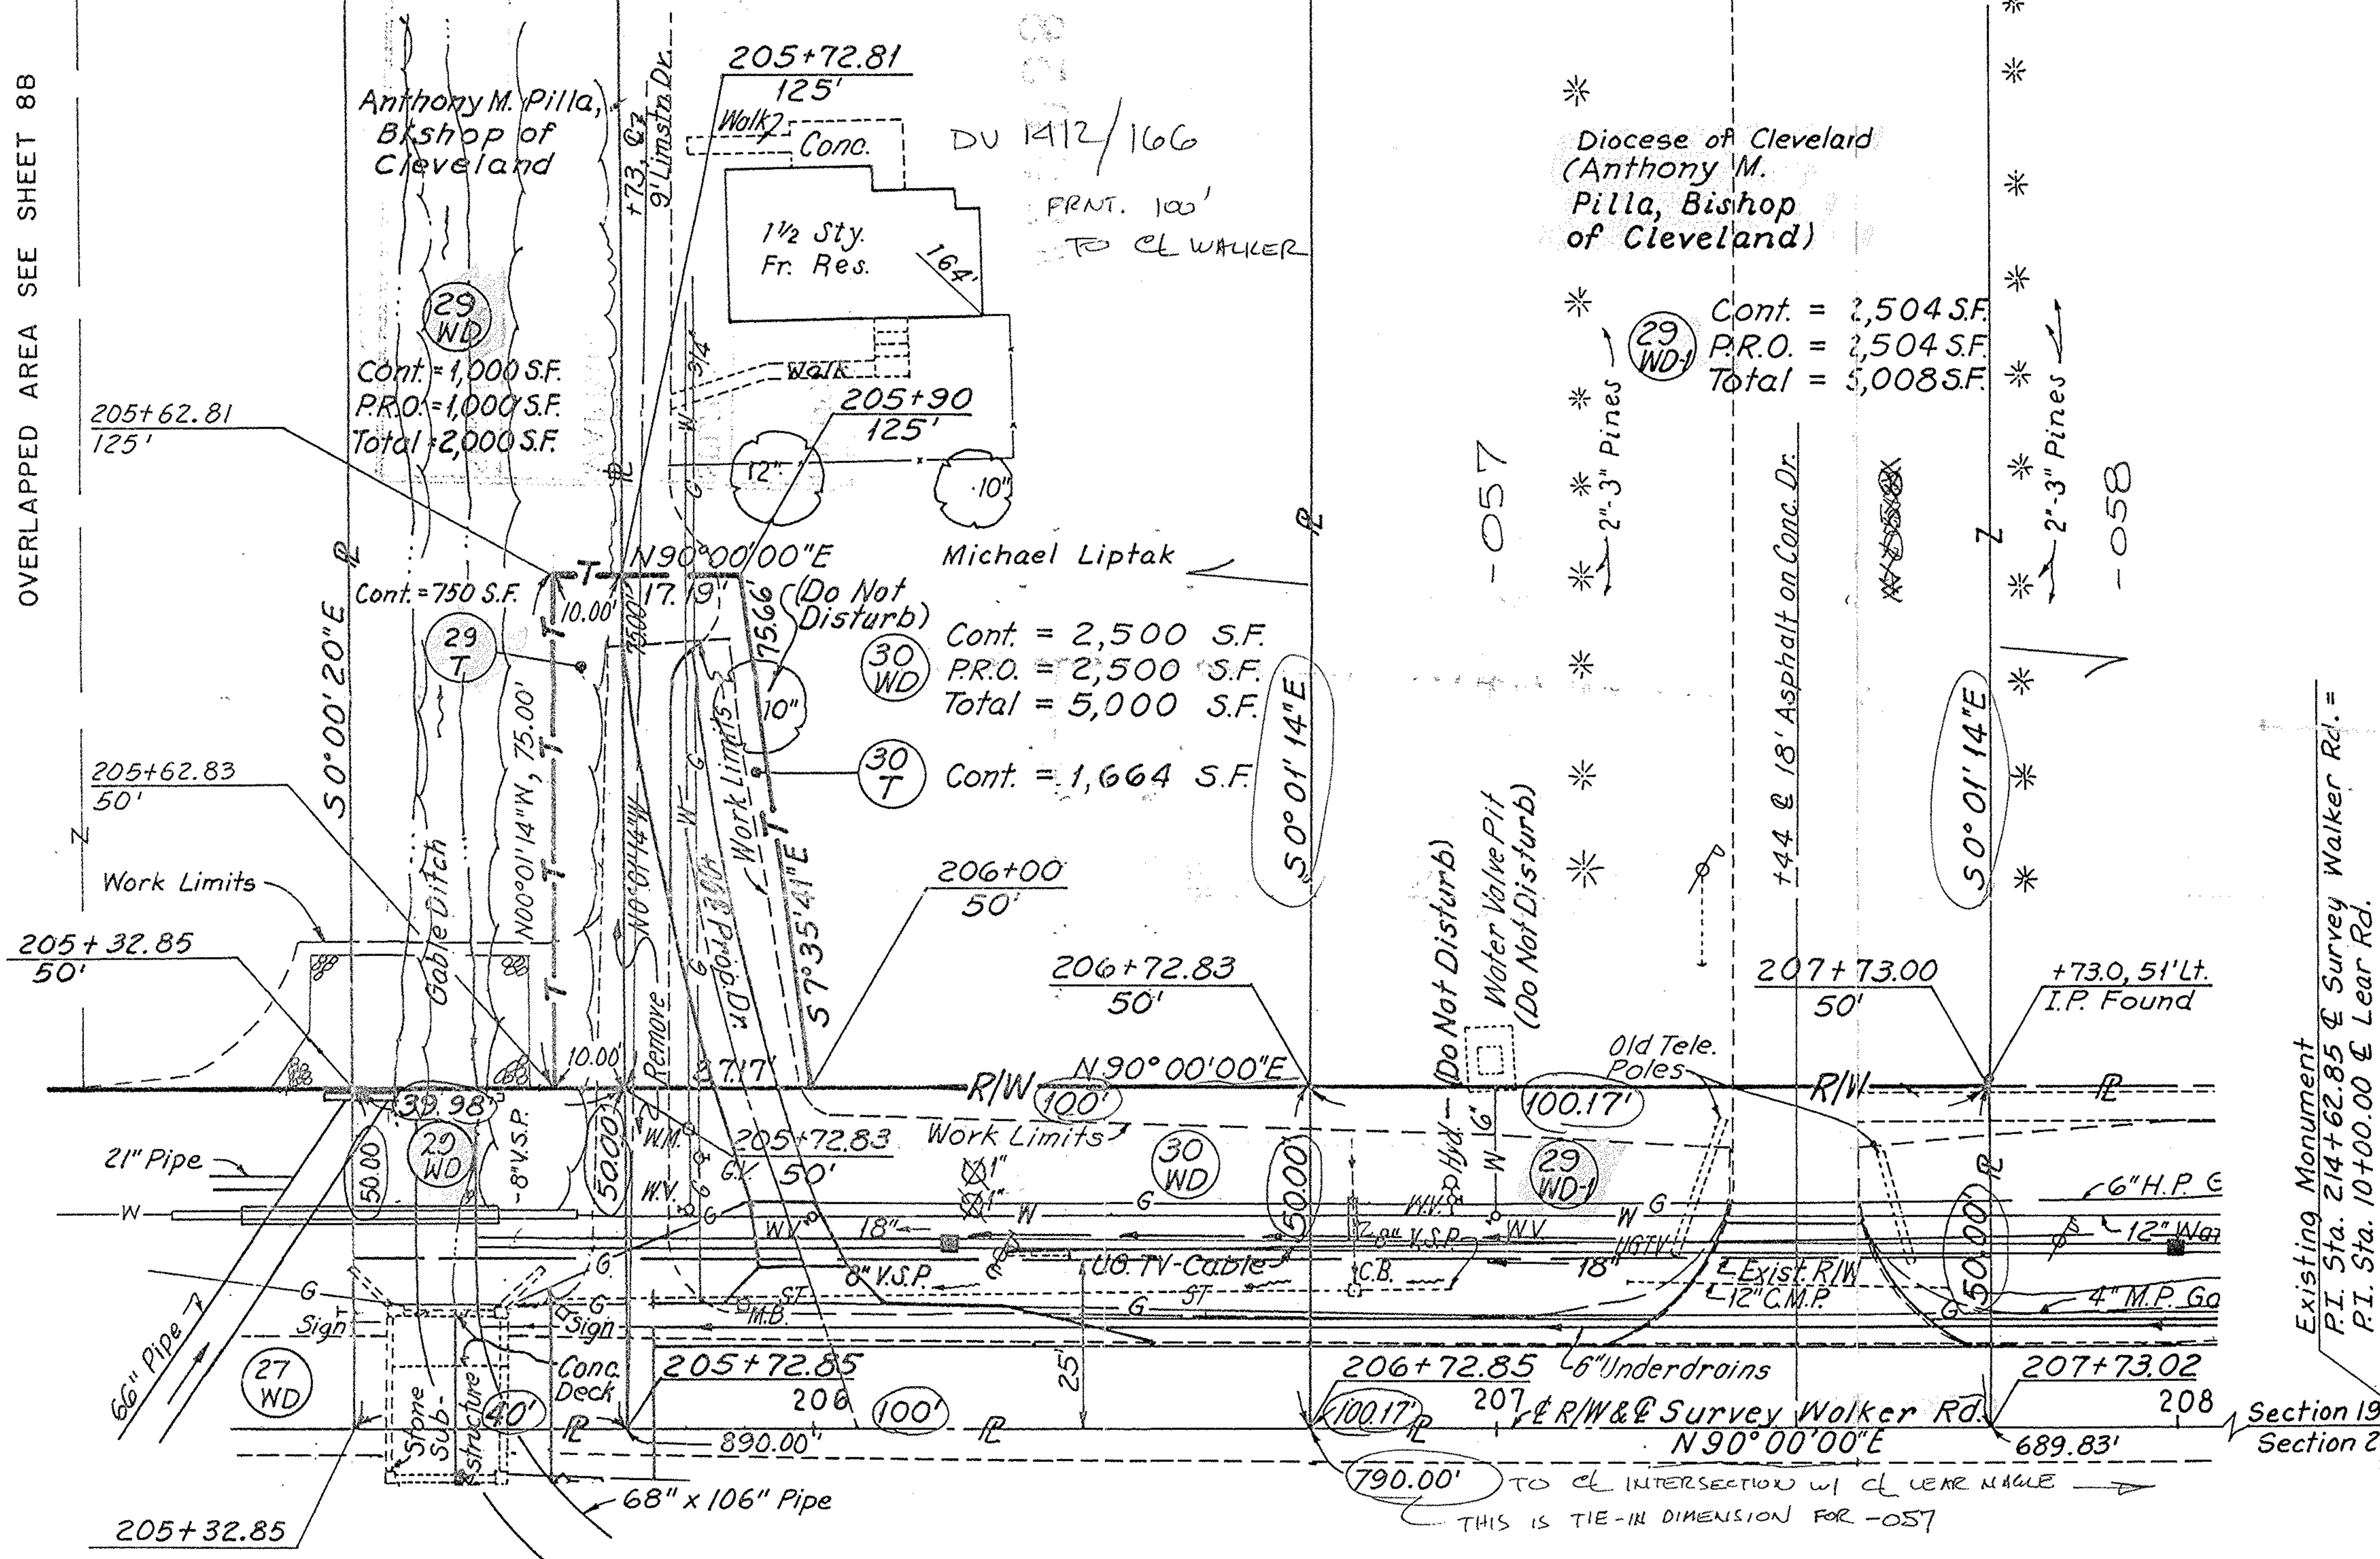

Existing Monument  
P.I. Sta. 214+62.85 & Survey Walker Rd. =  
P.I. Sta. 10+00.00 & Lear Rd.

Section 19  
Section 20  
Section 29  
Section 30

790.00' TO CL INTERSECTION W/ CL LEAR HAVLE  
THIS IS TIE-IN DIMENSION FOR -057