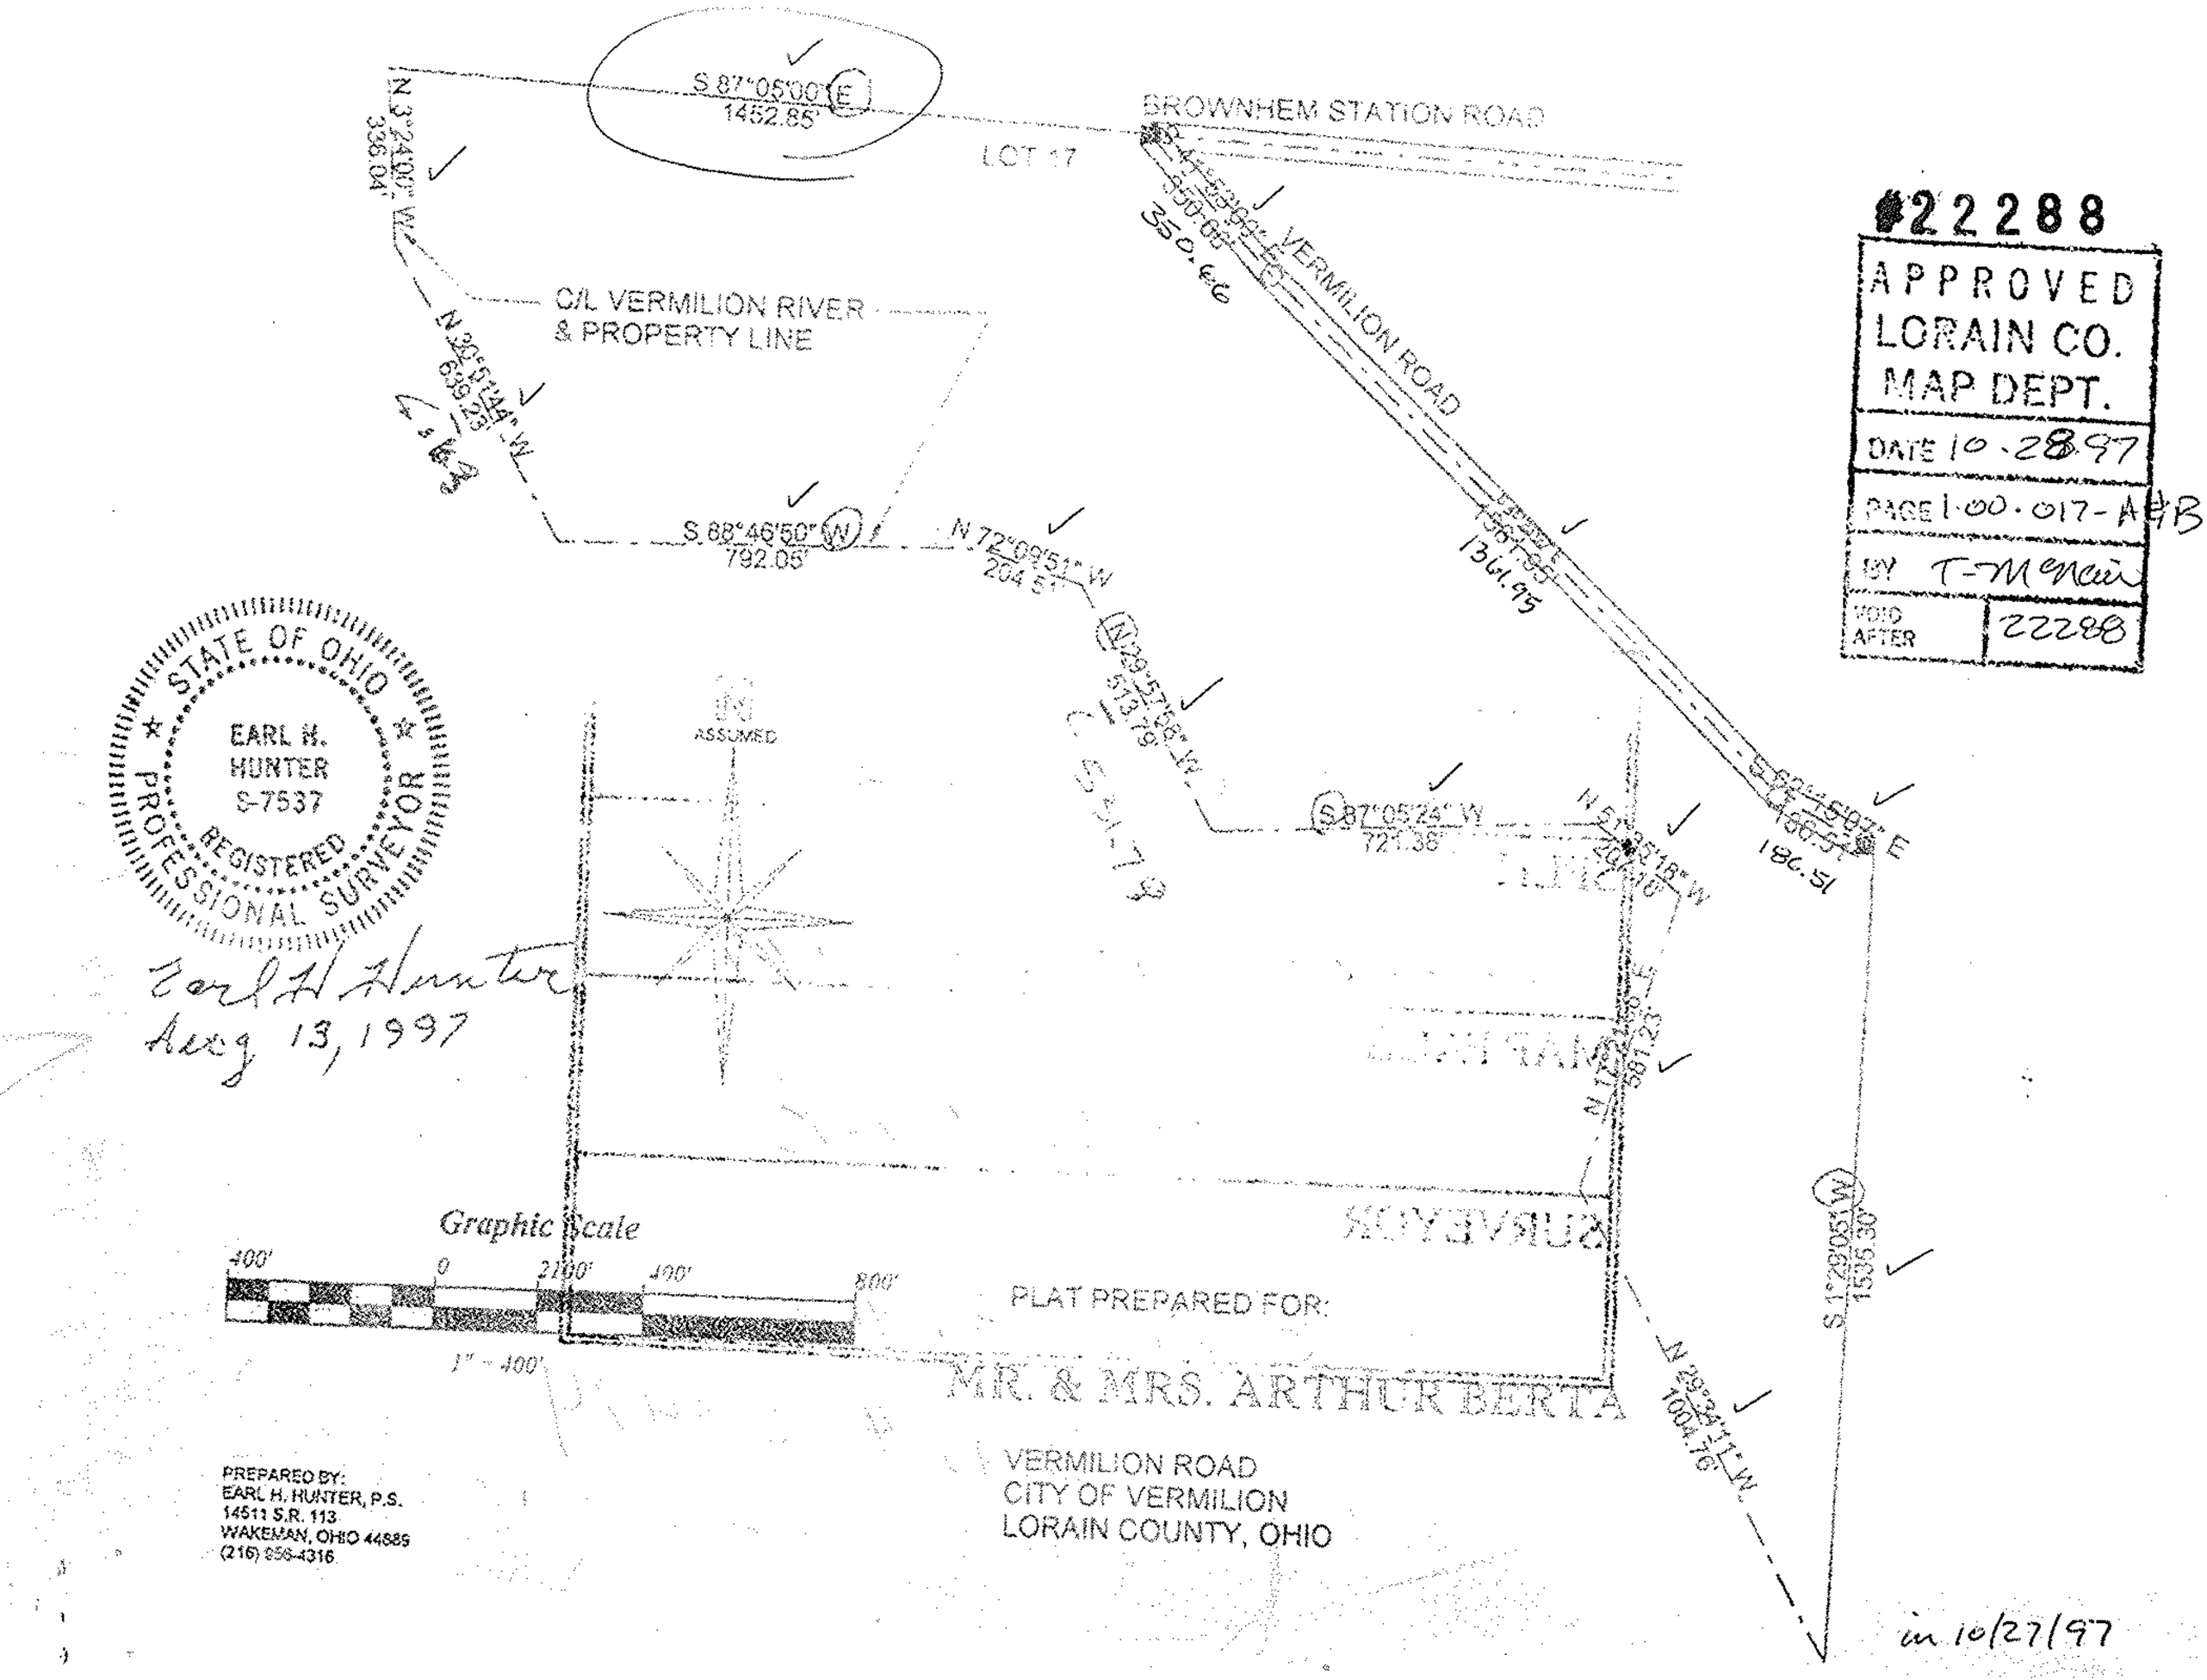

#22288

APPROVED
LORAIN CO.
MAP DEPT.

DATE 10-28-97

PAGE 1-00-017-A&B

BY T-McNair

VOID AFTER 22288

in 10/27/97