CERTIFICATE OF CORRECTION

This is to certify that certain revisions and corrections are to be made to the plat of University Oaks Subdivision No. 2 as recorded in Volume 44, Pages 32 and 33 regarding Sublot No. 87 and Hampton Subdivision No. 1 as recorded in Volume 44, Pages 56 and 57 regarding Sublots Nos. 19 and 20. These revisions and corrections are shown below and are pursuant to boundary line agreements as recorded in Volume 670, Pages 292-294 and Volume 669, Page 948-955 of Lorain County Official Records. Dimensions and Bearings which are unchanged are denoted by parentheses.

STATE OF OHIO
DAVID L. ELWELL
6333
REGISTERED SURVEYOR

David L. Elwell

David L. Elwell, Reg. Surveyor #6333
KS ASSOCIATES, INC.
24 Middle Ave., Elyria, OH 44035

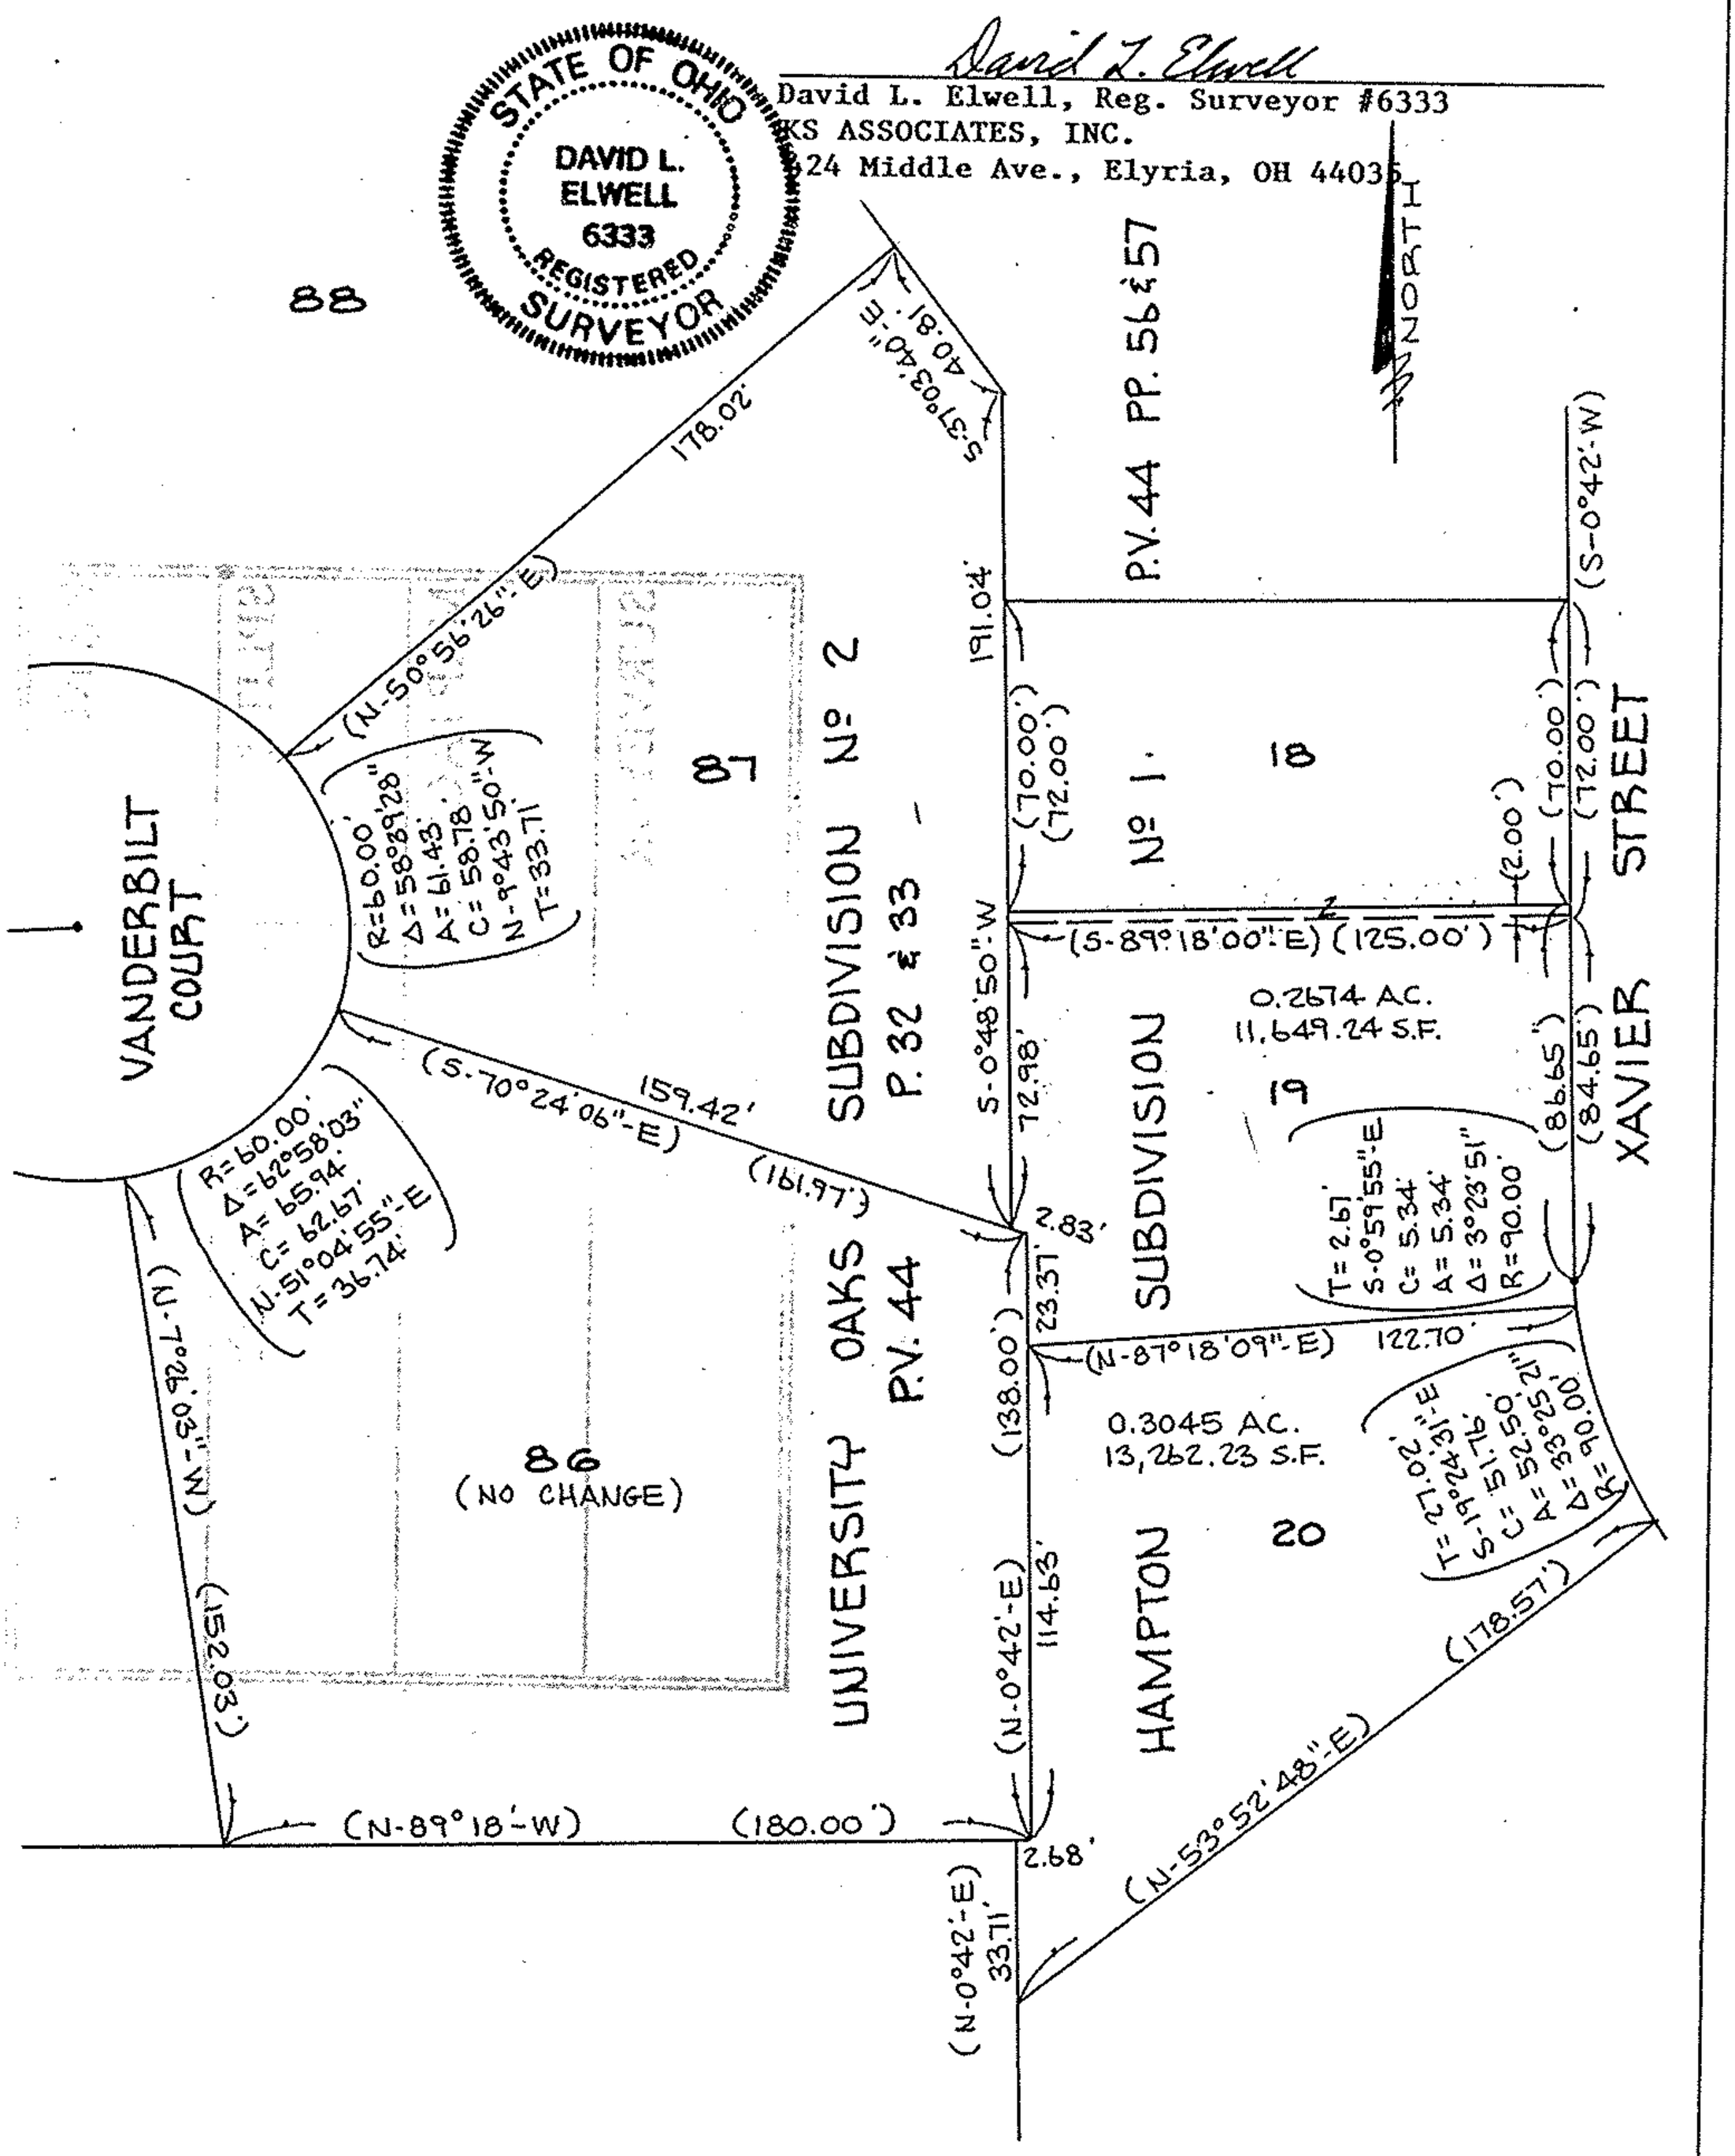

Sworn to before me and subscribed in my presence this 3rd day of August, 1993, at Elyria, Ohio.

NOTARIAL SEAL STATE OF OHIO

Marlene L. Jacobs

Marlene L. Jacobs, Notary Public
My Commission Expires 10/4/94