SURVEY

OF PART OF

ORIGINAL RIDGEVILLE TOWNSHIP

LOT NO. 29 AND 32

CITY OF NORTH RIDGEVILLE COUNTY OF LORAIN

STATE OF OHIO

PREPARED FOR:

E S REAL INC.
N. RIDGEVILLE, OH

PREPARED BY

HAPONEK & ASSOC.
N RIDGEVILLE, OH.

STATE OF OHIO
DANE A. HAPONEK
S-6211
REGISTERED
SURVEYOR

DATE: SEPT. 1996
SCALE: 1" = 40'

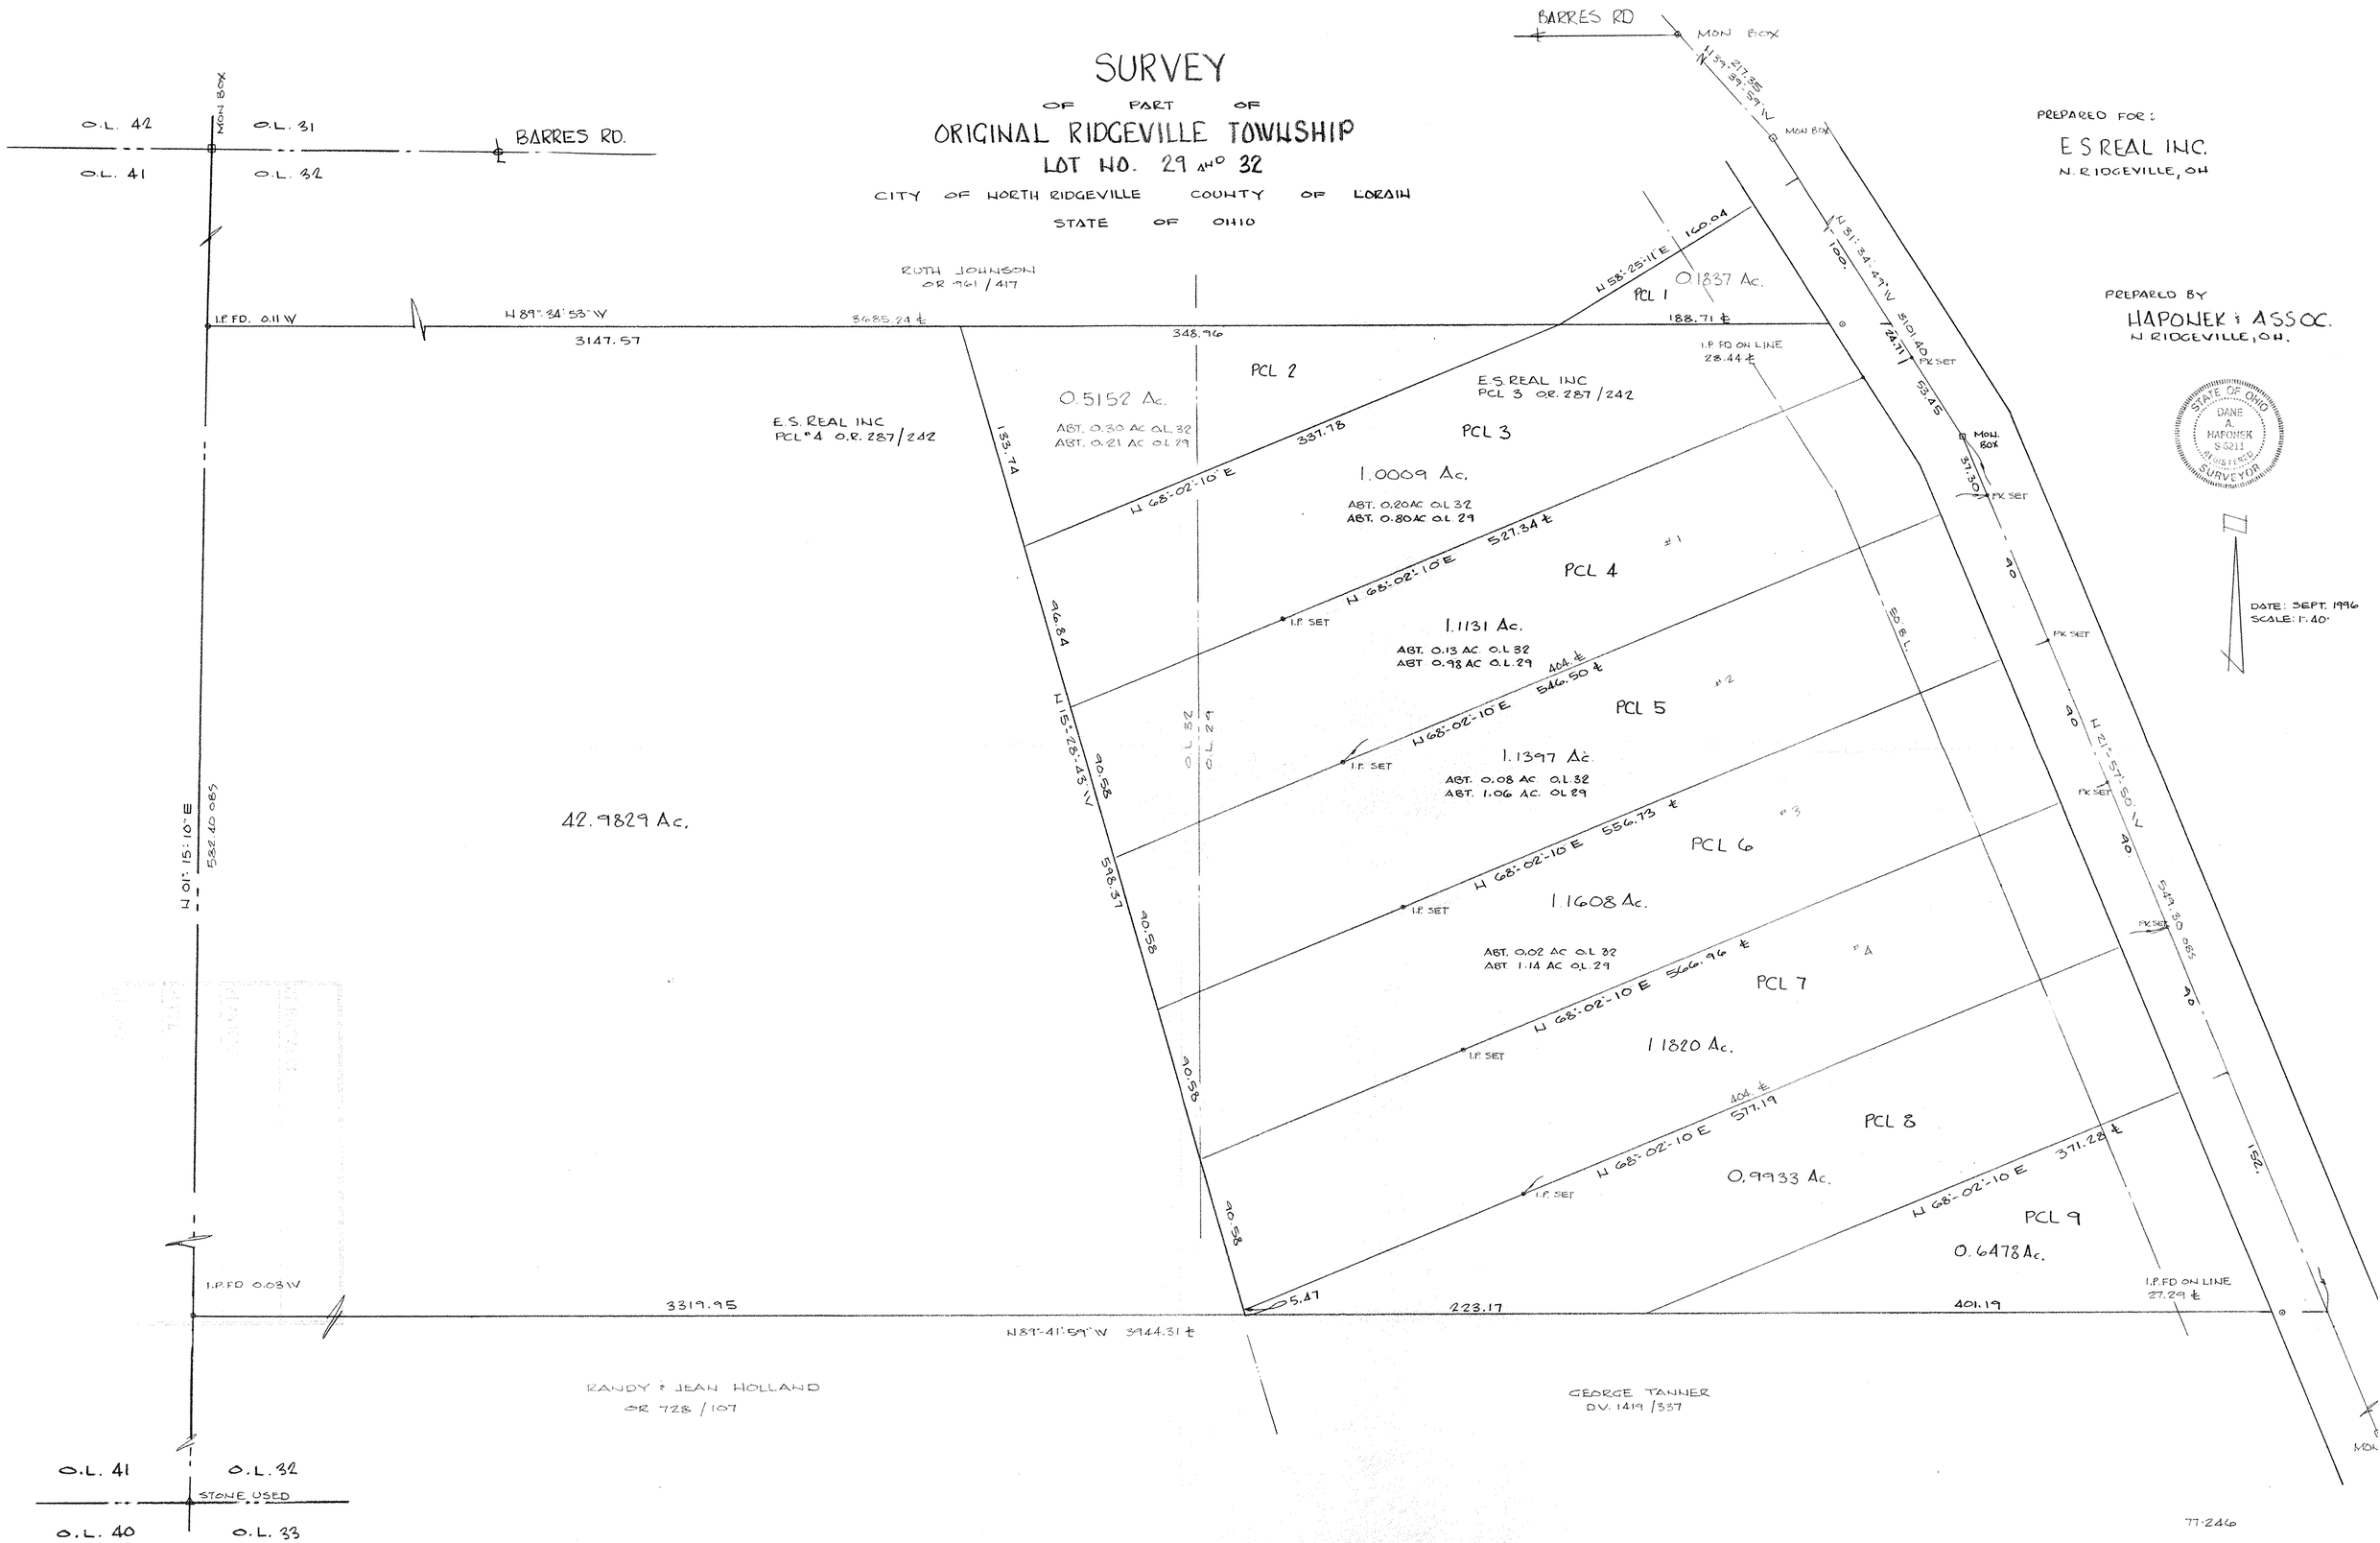

77-246