SURVEY
OF PART OF
ORIGINAL RIDGEVILLE TWP.
LOT Nº 29 & 32
CITY OF N. RIDGEVILLE COUNTY OF LORAIN
STATE OF OHIO
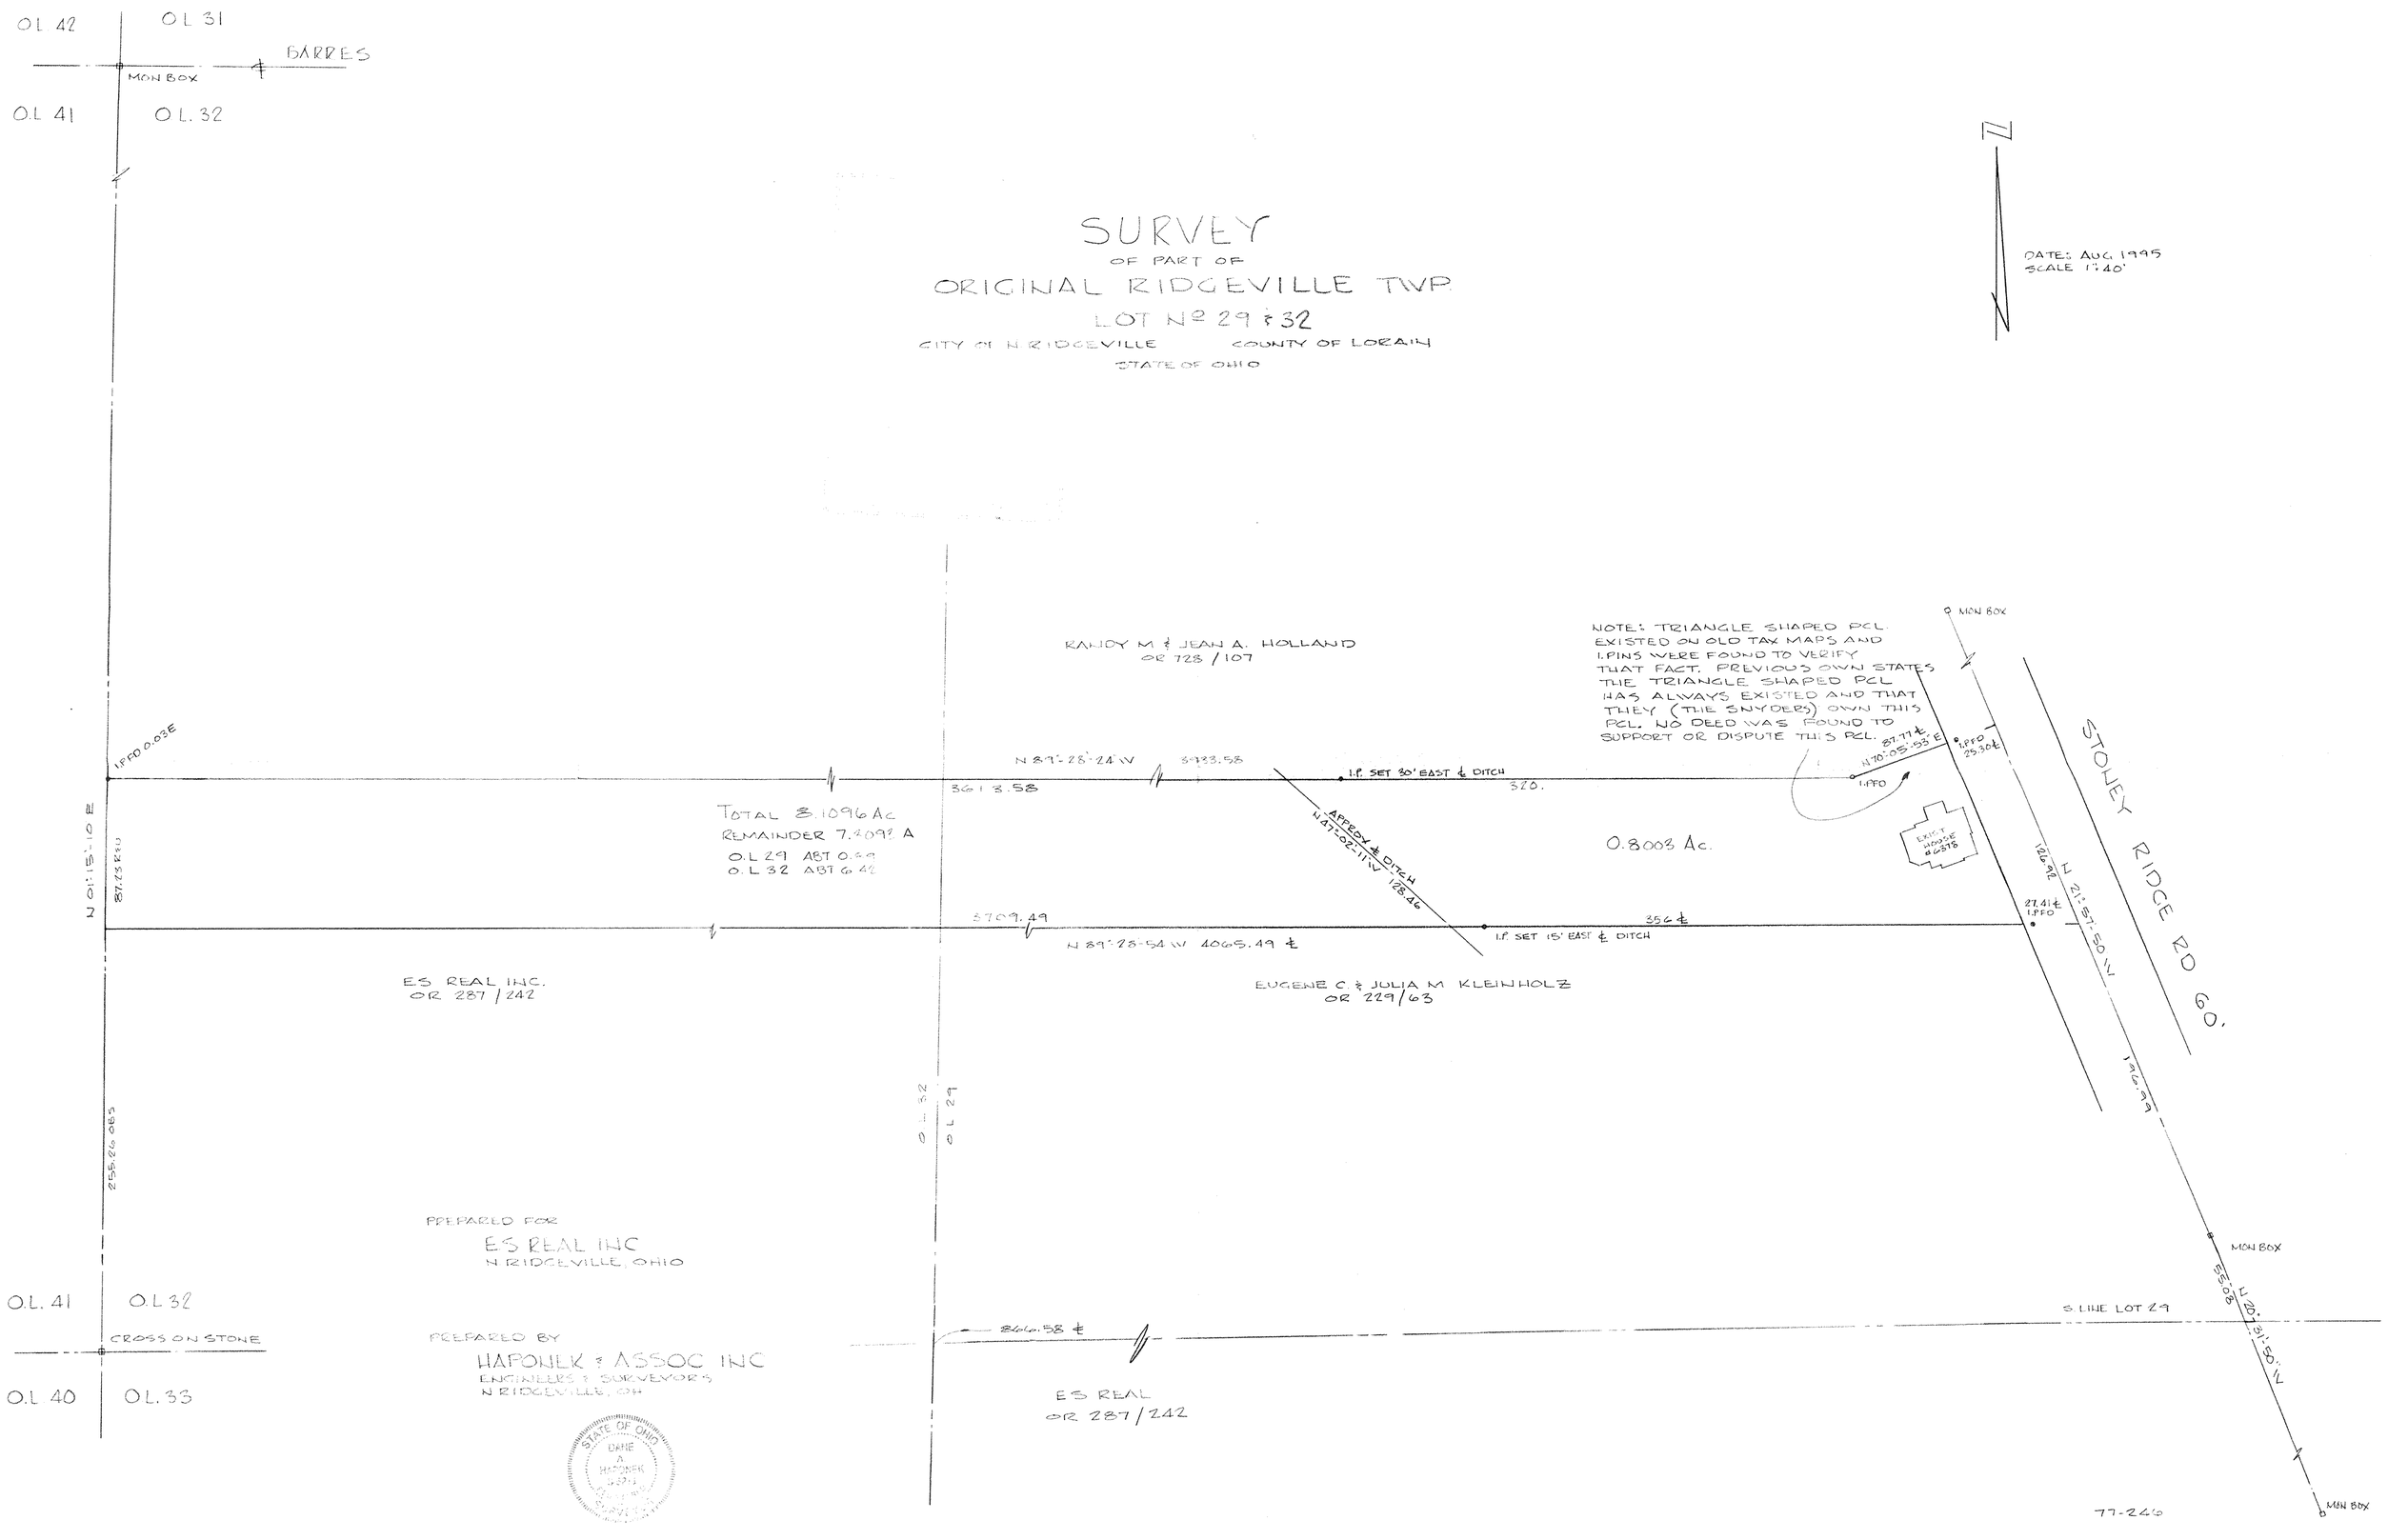
DATE: AUG. 1995
SCALE 1" = 40'