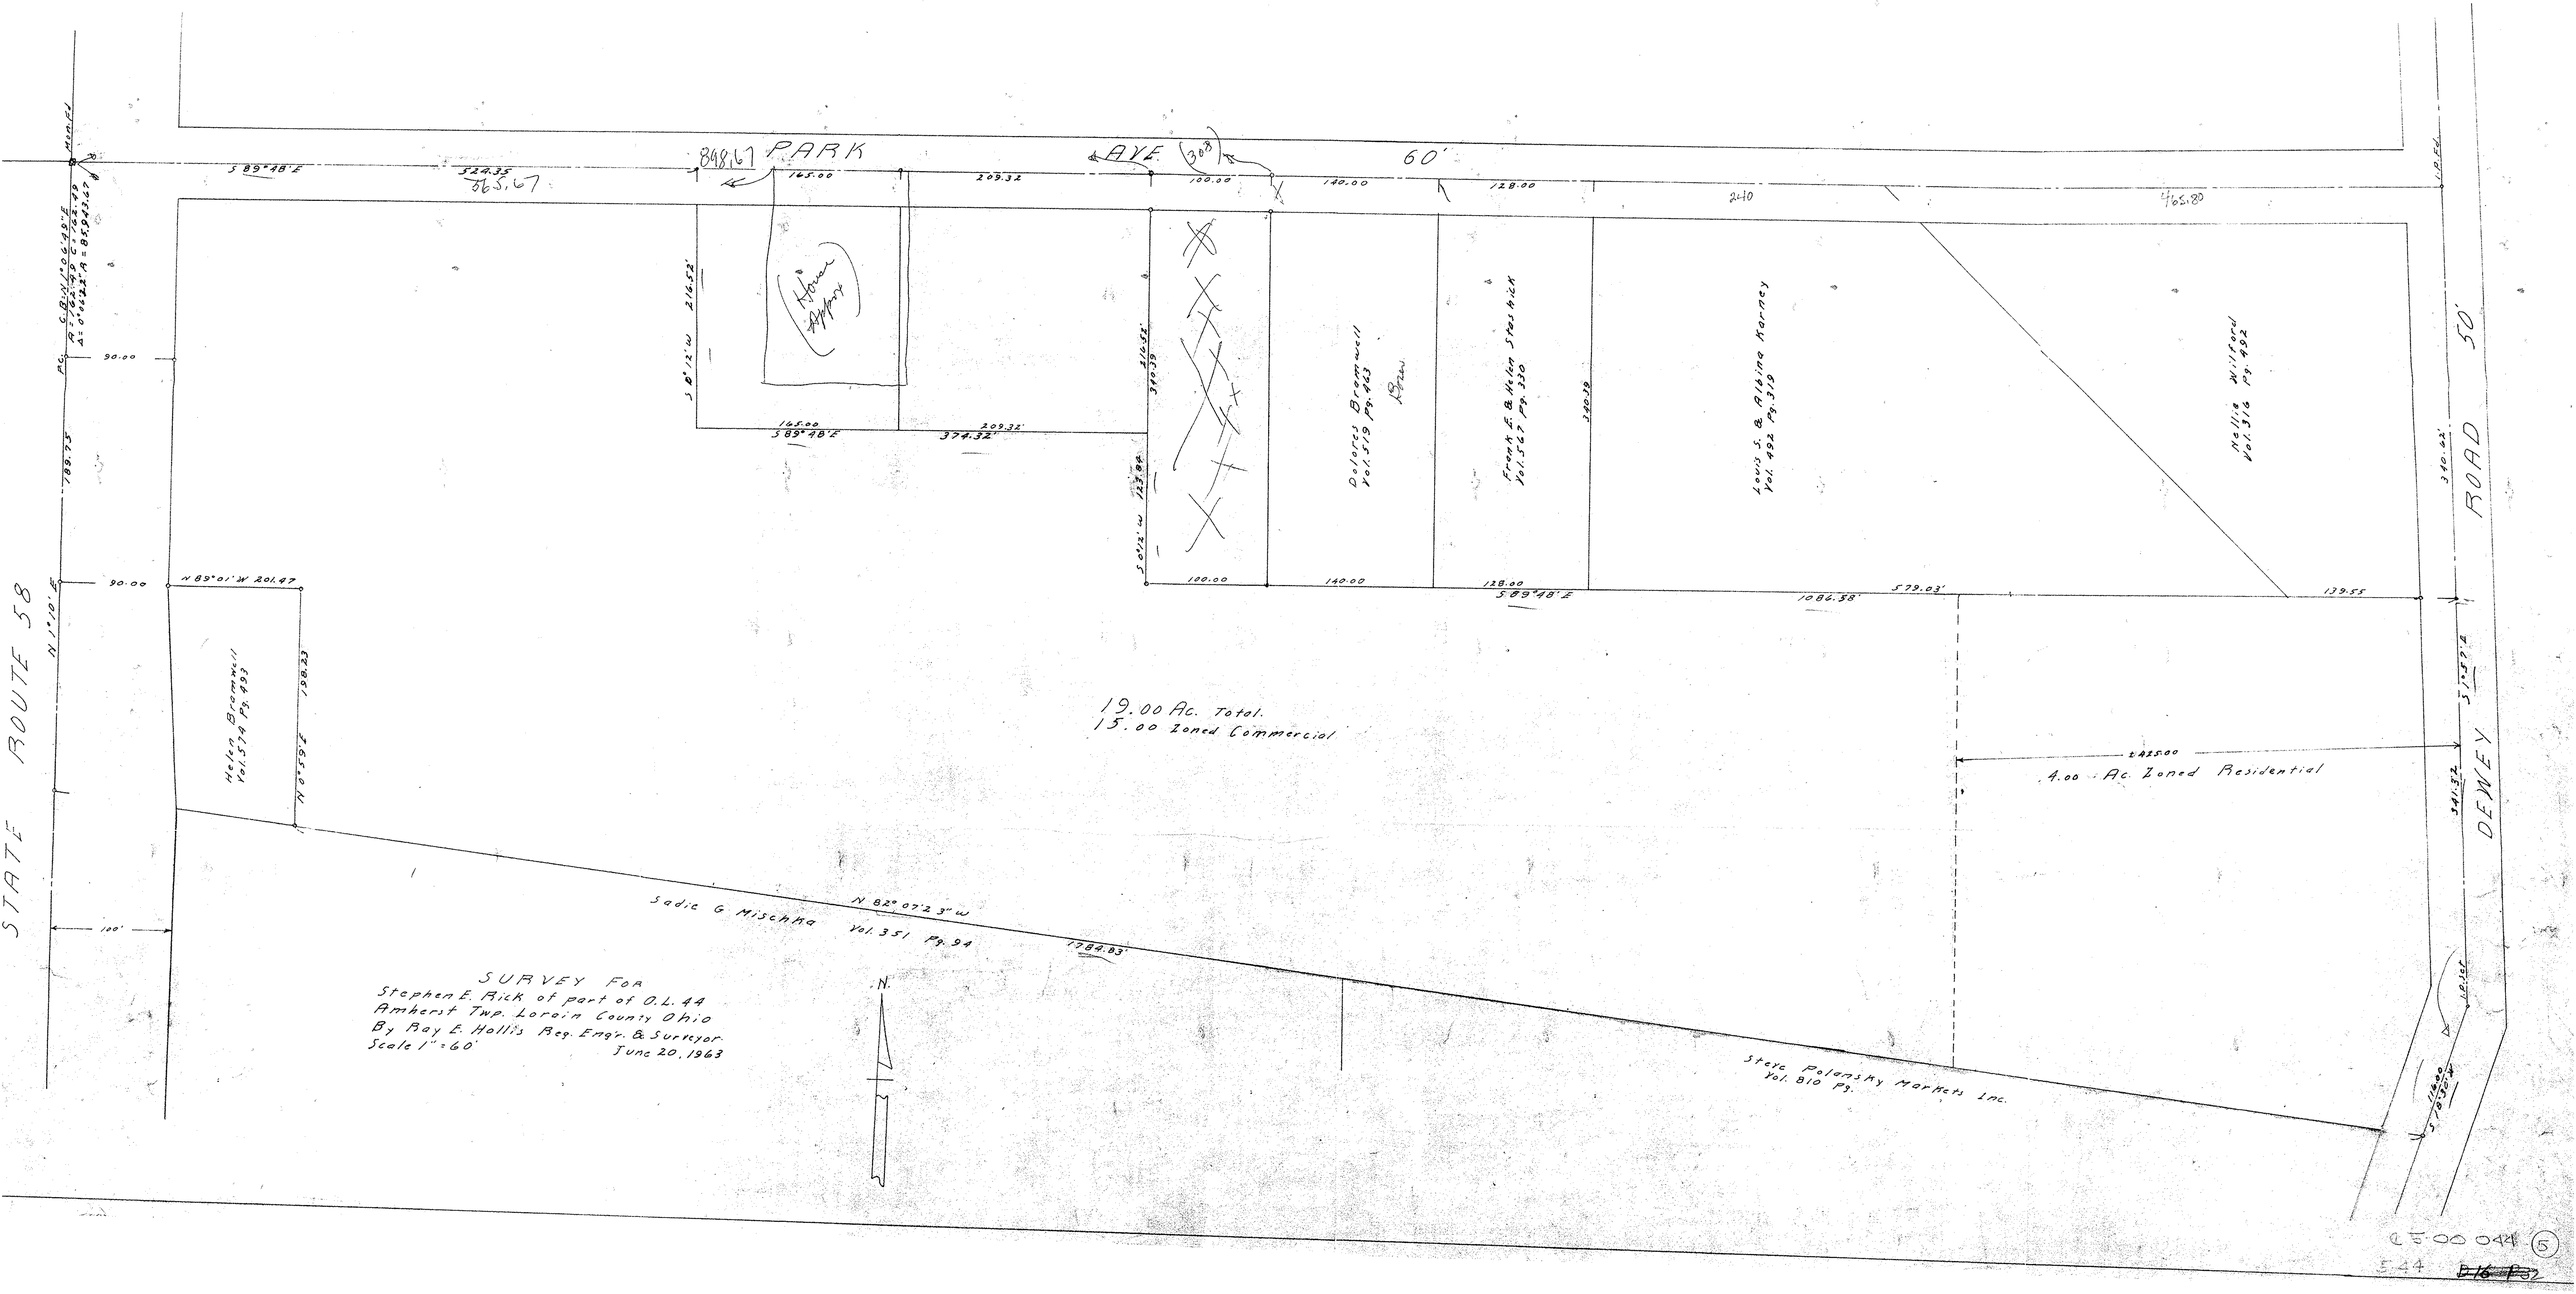


CE-00044 (5)
544 ~~D16 P87~~