MAP OF SURVEY OF 4.7525 ACRES OF LAND

TOWNSHIP OF AMHERST, LORAIN COUNTY, OHIO

PART OF ORIGINAL LOTS NO. 43, 44, 45, 58

LAKE SHORE AND SOUTHERN RAILWAY CO. RIGHT OF WAY

AS RECORDED IN LORAIN COUNTY RECORD OF DEEDS:	Volume 31	Page 498,	J. Green	1933'x60'±	2.66 Ac.
	Volume 31	Page 501,	C. Boderman	830x66'±	1.14 Ac.
	Volume 31	Page 529,	F. Wilford	412x66'±	0.67 Ac.
	Volume 31	Page 530,	M. Jackson		0.20 Ac.
				Total=	4.67 Ac.

By Survey, Total = 4.7525 Ac.

Note: Vol. 1136, P.276, Trustees Penn Central Transportation to Charles H. Barckert and Robert J. Barckert (4.7525 Acres)

MAP OF LANDS MADE FOR DESCRIPTION 2.7430 ACRES
PART OF O.L. 44 AND 45, AMHERST TWP., LORAIN CO., OHIO
Made at Request of Charles Barckert and Clint Reph
By Charles P. Waryu Reg. Surveyor No. 5029
July 25, 1977

05-00-044-000-043
4/17/78
11563

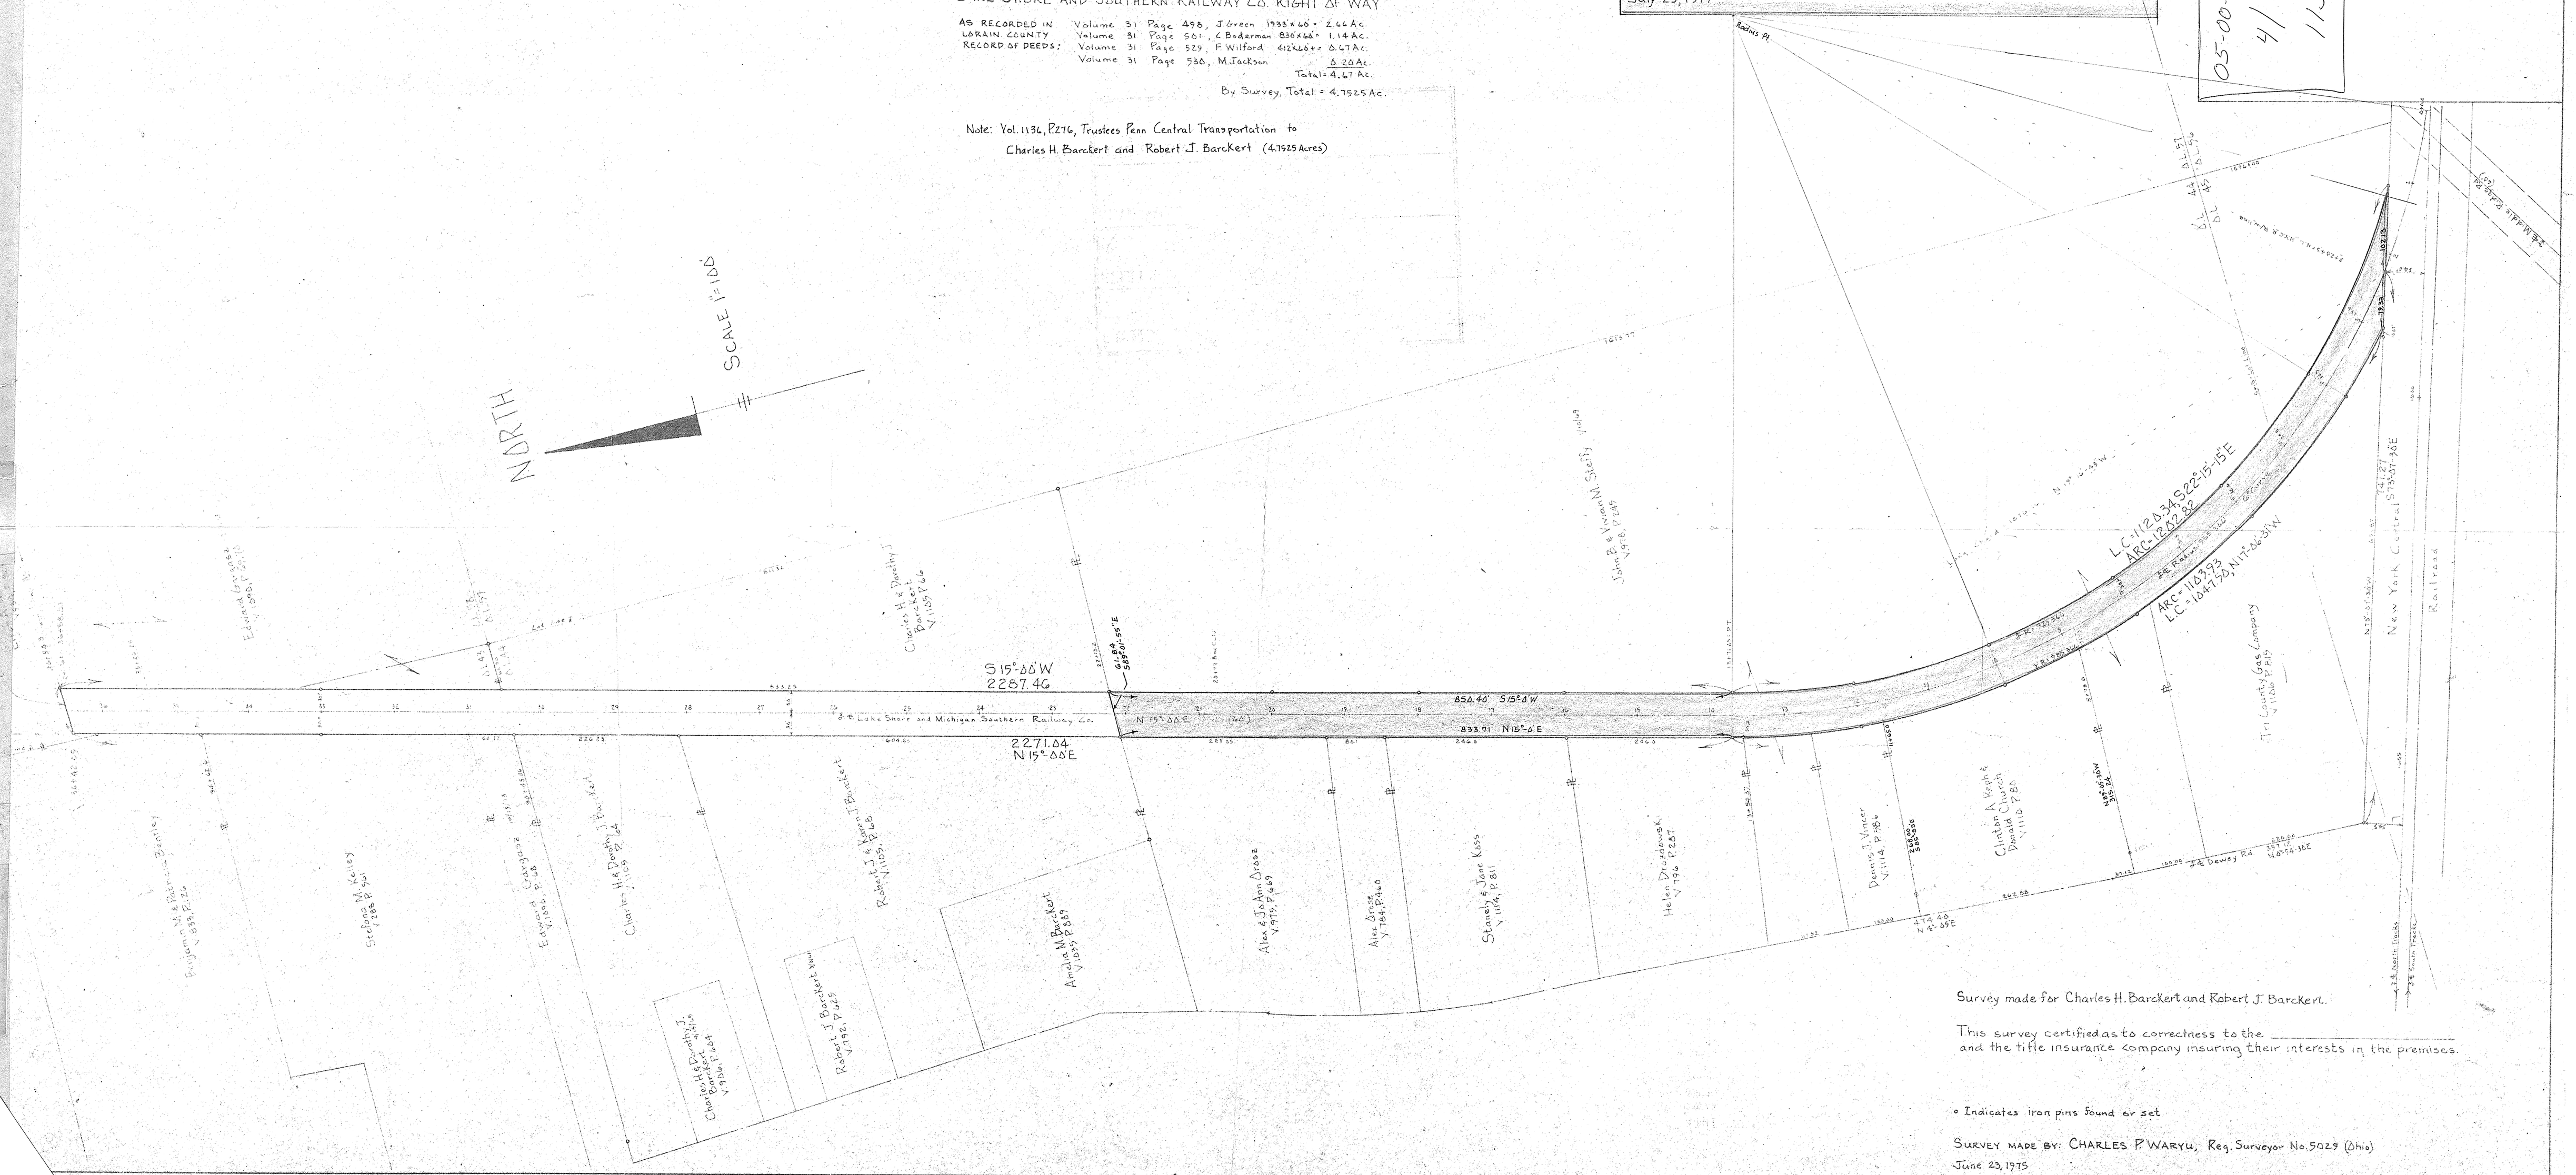

Survey made for Charles H. Barckert and Robert J. Barckert.

This survey certified as to correctness to the _____ and the title insurance company insuring their interests in the premises.

• Indicates iron pins found or set

SURVEY MADE BY: CHARLES P. WARYU, Reg. Surveyor No. 5029 (Ohio)
June 23, 1975

July 25, 1977 MAP REVISED To show 2.7430 Acres division of lands as shown