5-00-045-000

#16091

LAUNDON • SIMON • CAHL & ASSOC. INC.
CONSULTING ENGINEERS & SURVEYORS
ELYRIA, OHIO 44035

SURVEY FOR
RUBY ROBART

Orig. Lot 45	City of	Date FEB. '85 Scale 1" = 100
Orig. Sec	Village of	Dwn. by R.G.S. Chkd. by J.C.
Tract	County of LORAIN	Job No. 85-1346 F.B. 98 P.61
Township of AMHERST	State of OHIO	Printed FEB 19 1985

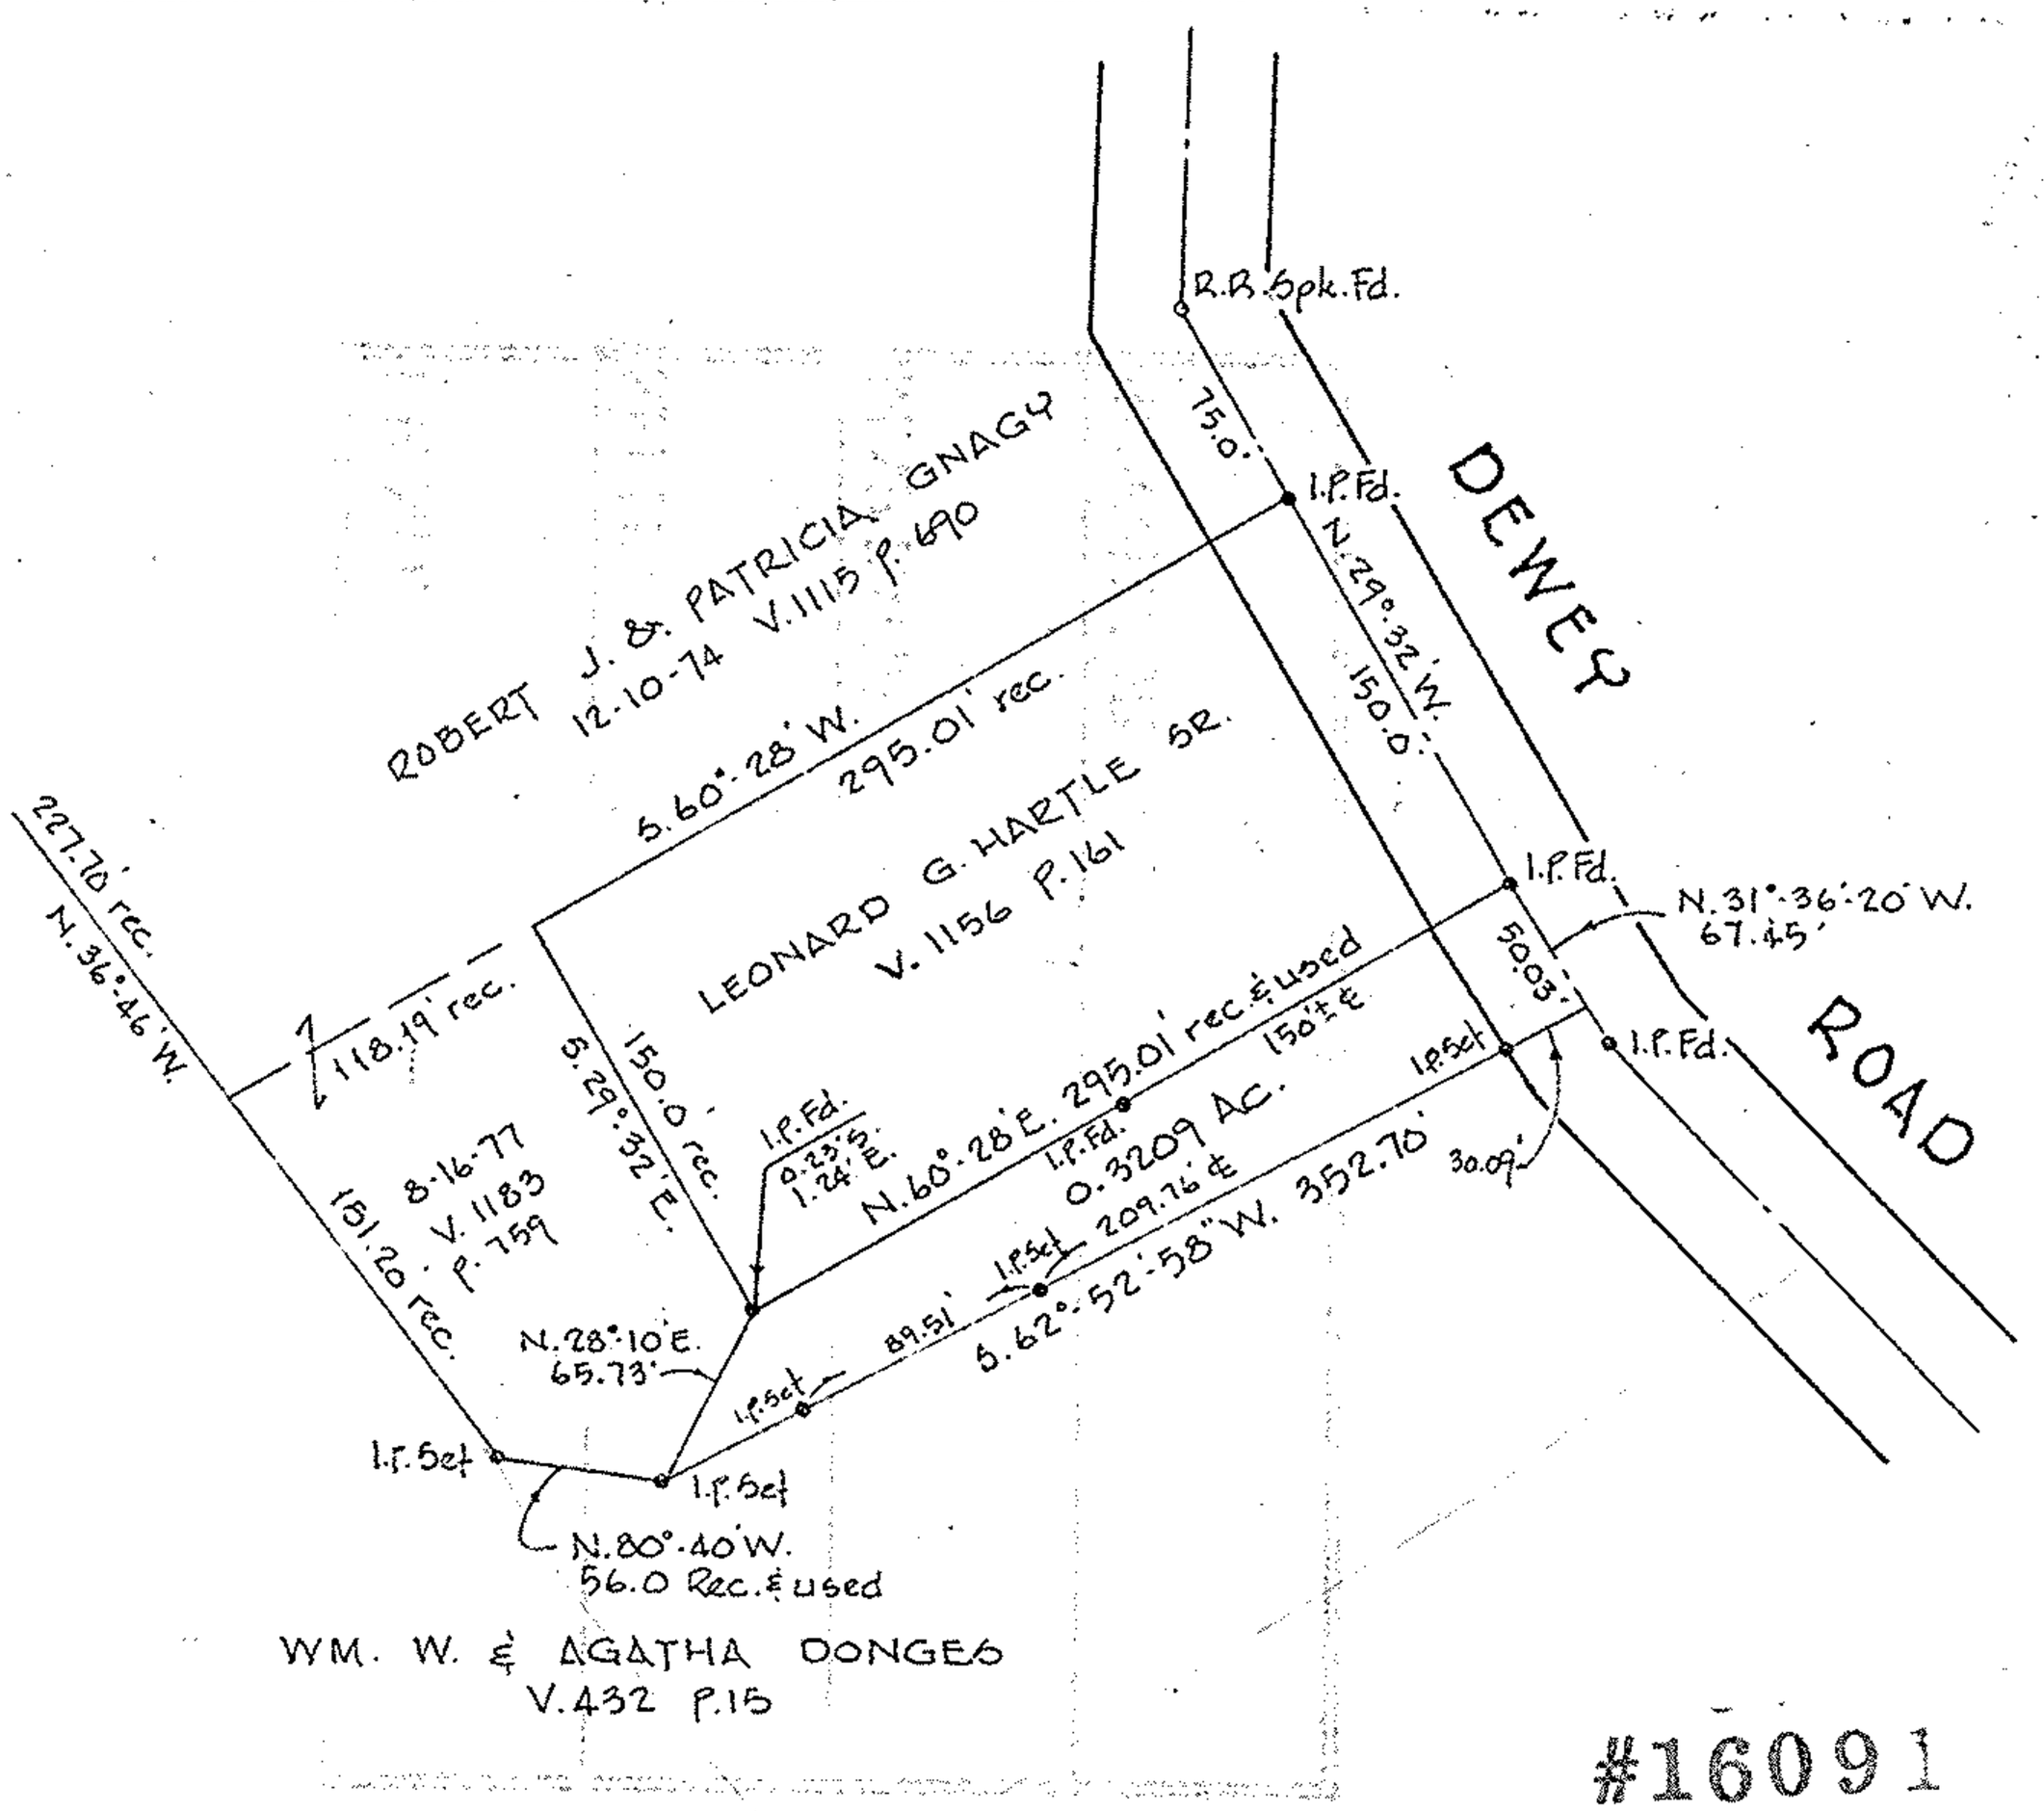

#16091
APPROVED
LORAIN CO.
MAP DEPT.
DATE 3-18-85
PAGE 5-00-045-B
BY T. McNair
VOID

5-00-045-B