P.P. NO.	
16-00-022-000-010, 012	
SPLIT # 00376	DATE OF SURVEY Oct, 1999
MAP PAGE 16-A	
SURVEYOR Rodger G. Simon	

Scan # 39508

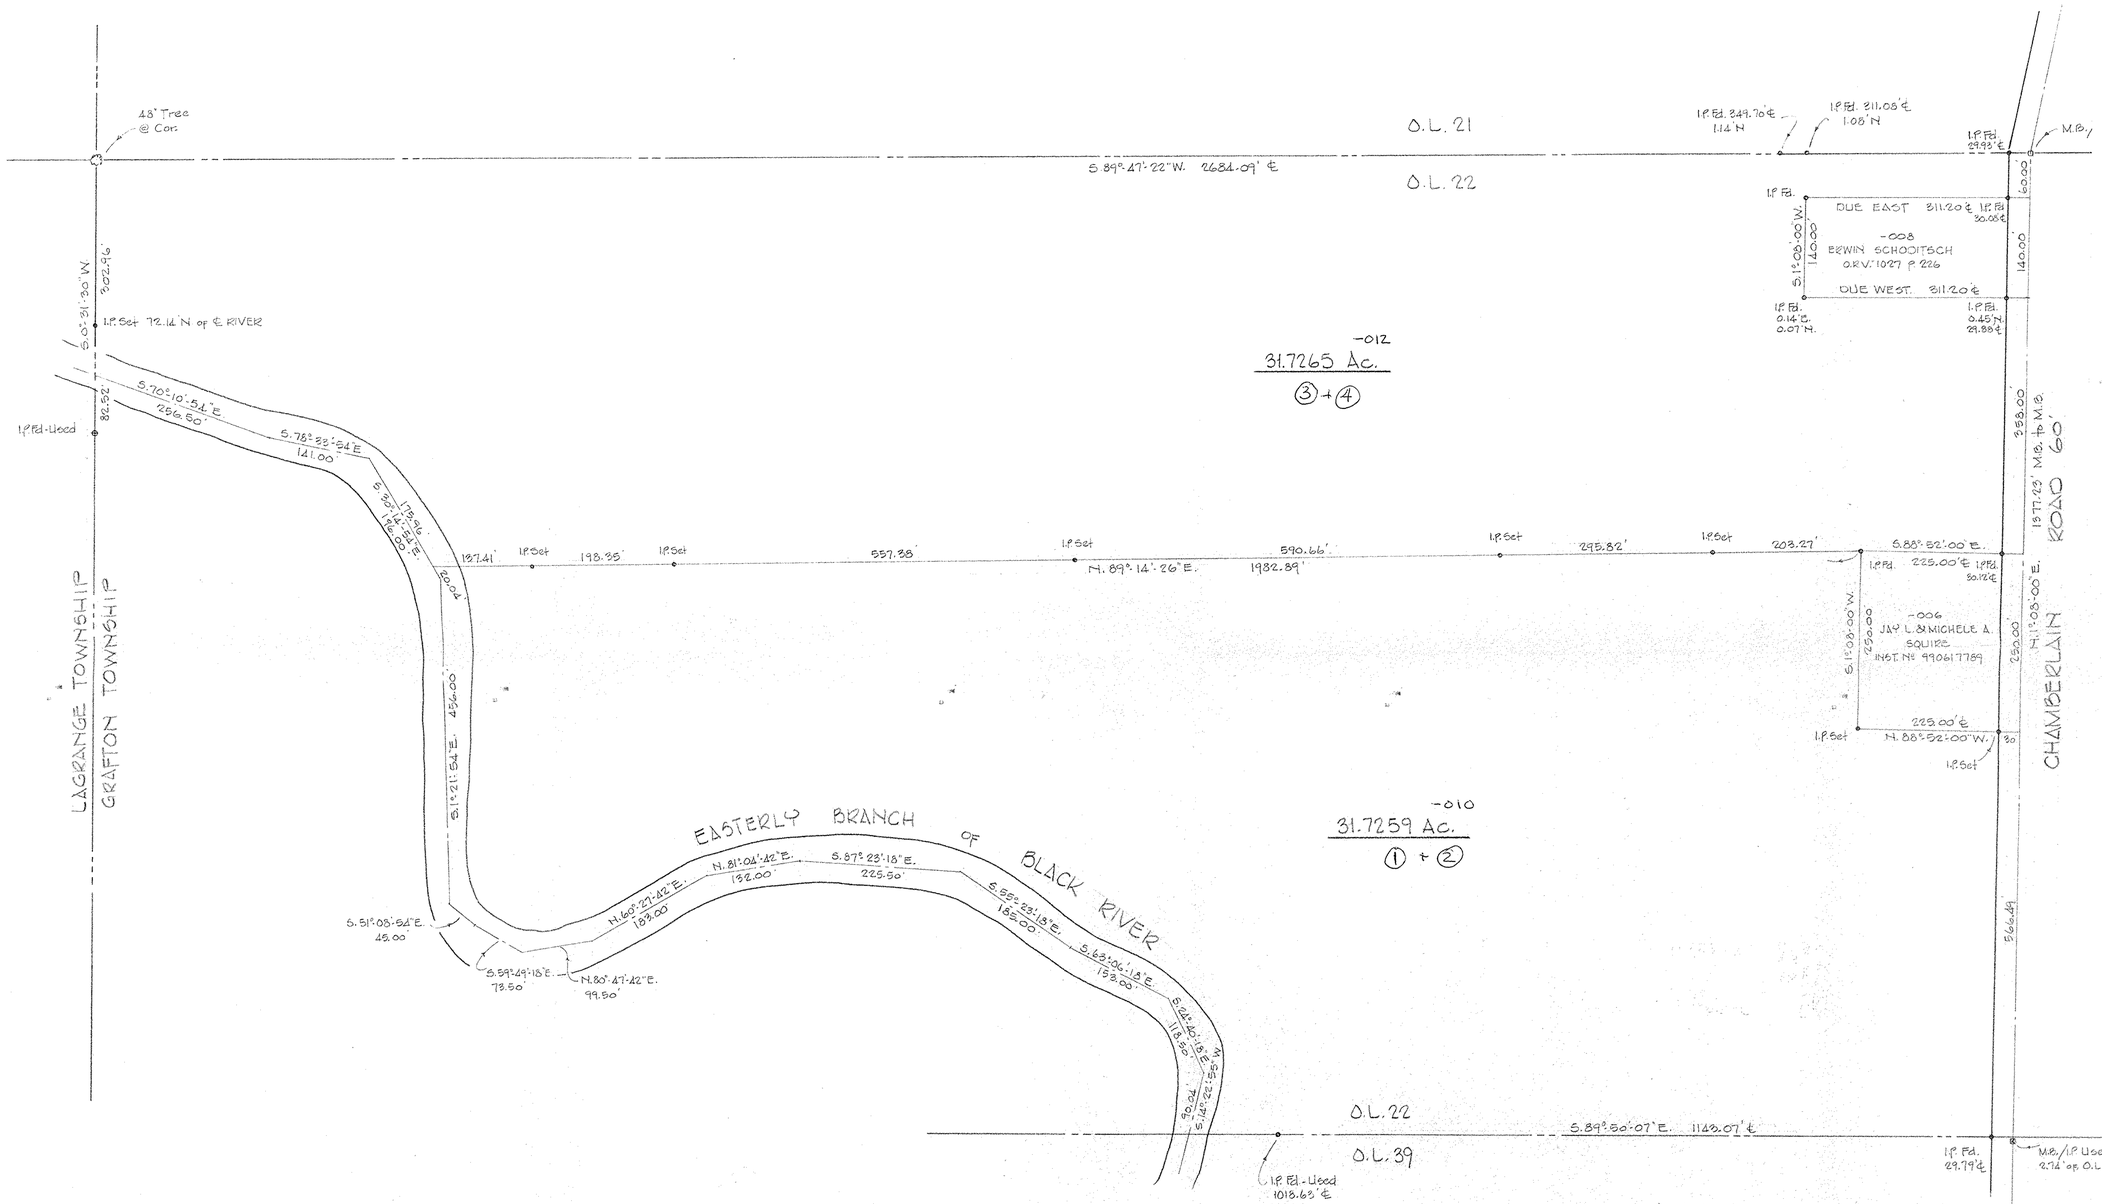

#00 376

APPROVED LORAIN CO. MAP DEPT
DATE 3-13-2000
PAGE 16-A
BY
#00376

STATE OF OHIO
RODGER G. SIMON
5101
REGISTERED SURVEYOR

SURVEY FOR THE

ESTATE of CHARLES A. MLAZOVSKY

PART of O.L. 22 TOWNSHIP of GRAFTON
COUNTY of LORAIN STATE of OHIO
OCTOBER 1999 SCALE 1" = 100'
BY
LAUNDON • SIMON • CAHL & ASSOC.
PROFESSIONAL LAND SURVEYORS
JOB № 99-3185 FB. 245 P. 77-79