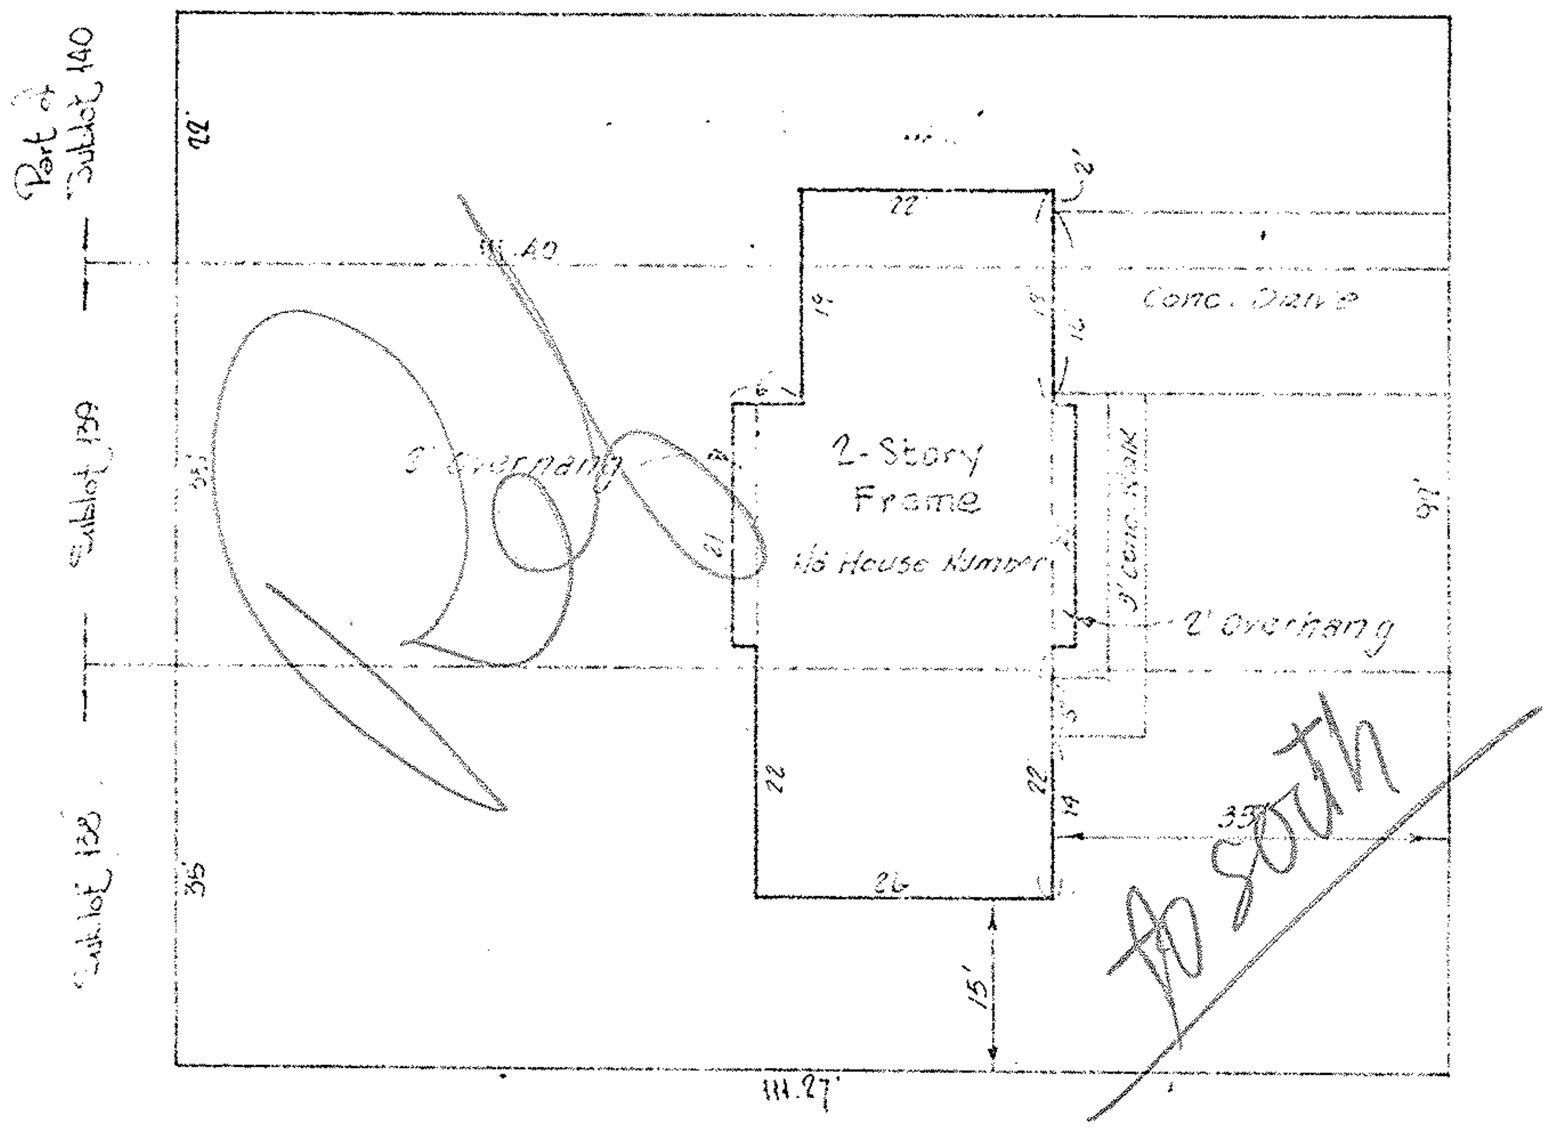

ROBINWOOD AVENUE 50'

SUBLOTS #138, 139 and PART of S.L. 140 of WEST SHORE SUBD.

PLAT VOL. 10 PAGE 3
PART of ORIG. SHEFFIELD TWP. LOT 38
NOW in CITY of SHEFFIELD LAKE, OHIO

McGLINCHY & ASSOCIATES
JUNE 30, 1977 #772199