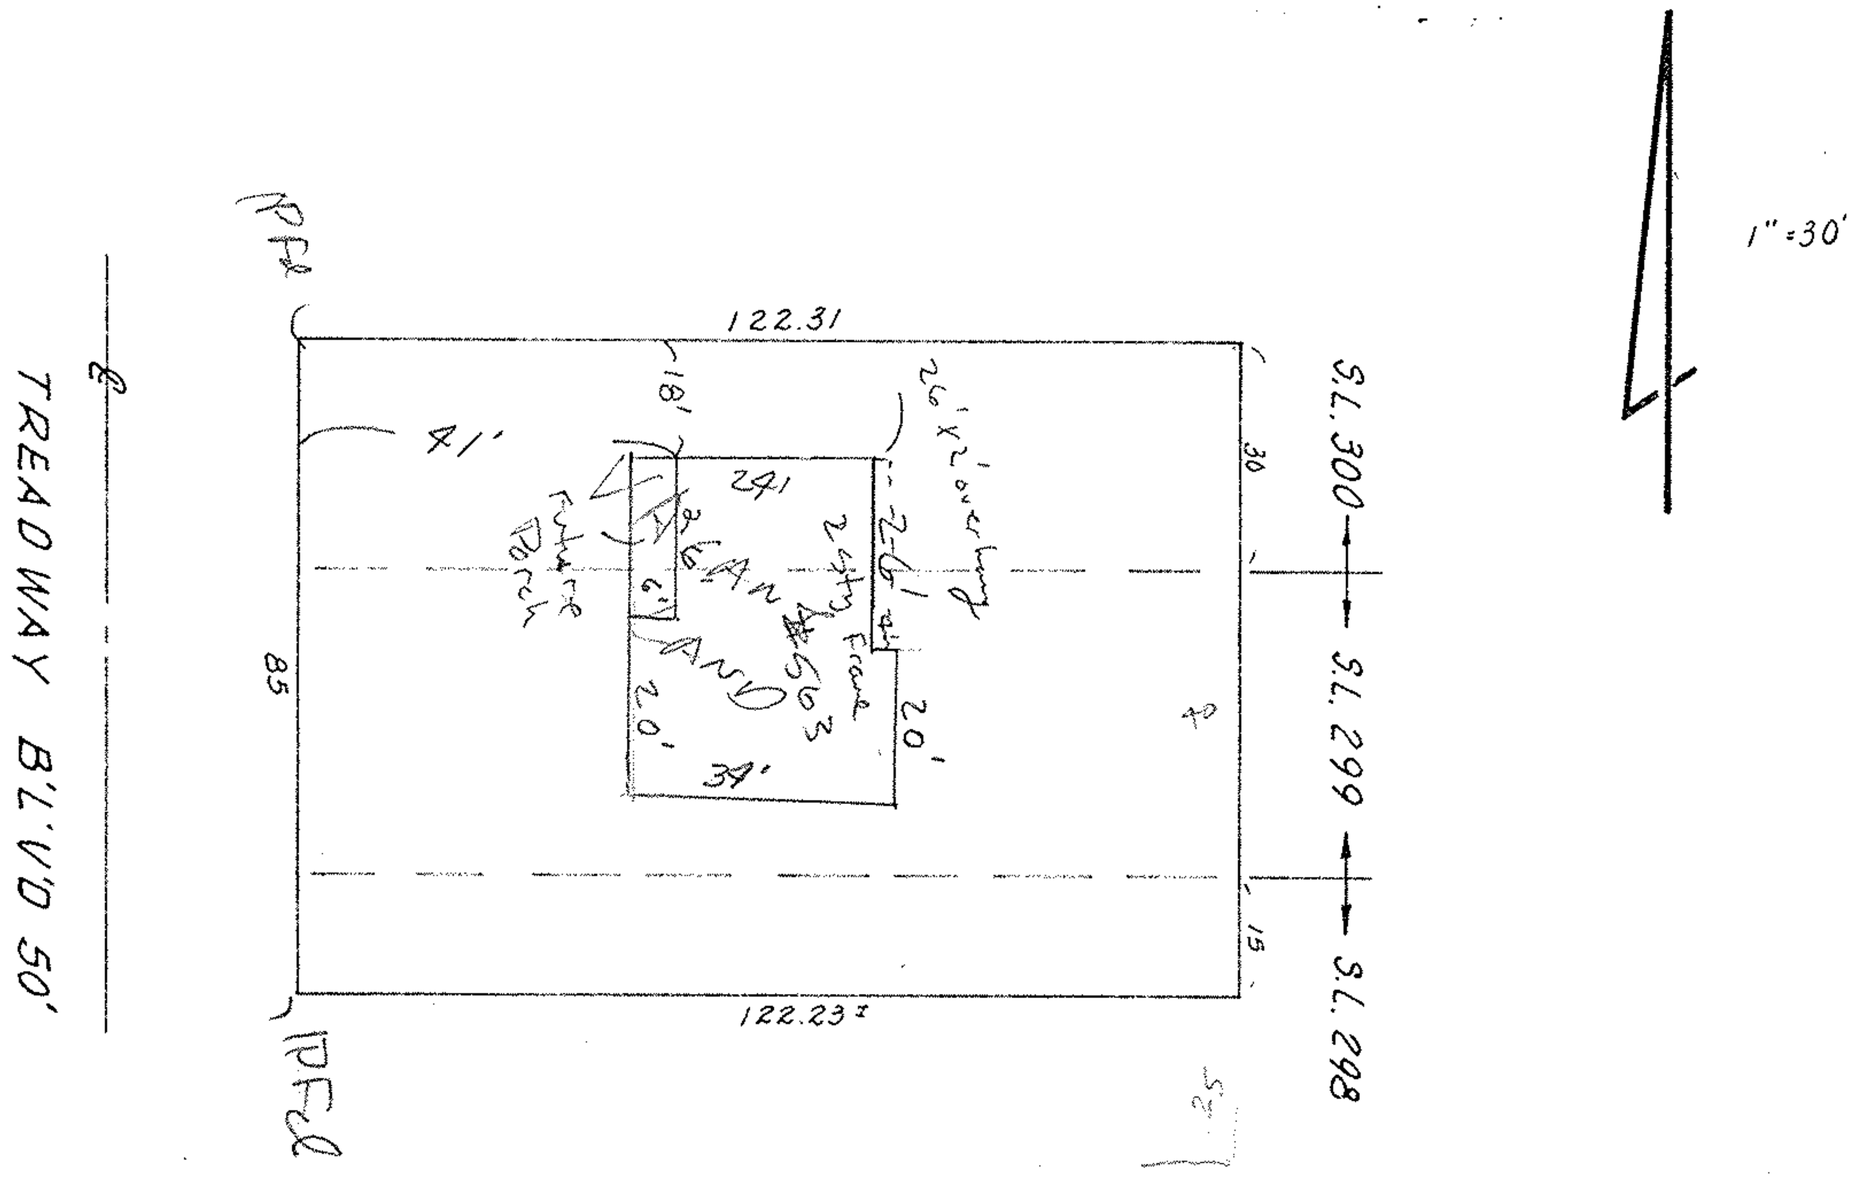

SUBLOT #299 plus part of #298 & 300 of
CORAL BEACH SUBDIVISION #2
PLAT VOL. 12 PAGE 21
PART of ORIG. SHEFFIELD TWP. LOT 37
NOW in CITY of SHEFFIELD LAKE, OHIO

McGLINCHY & ASSOCIATES
MAY 1977 #771901
MidT E-8640