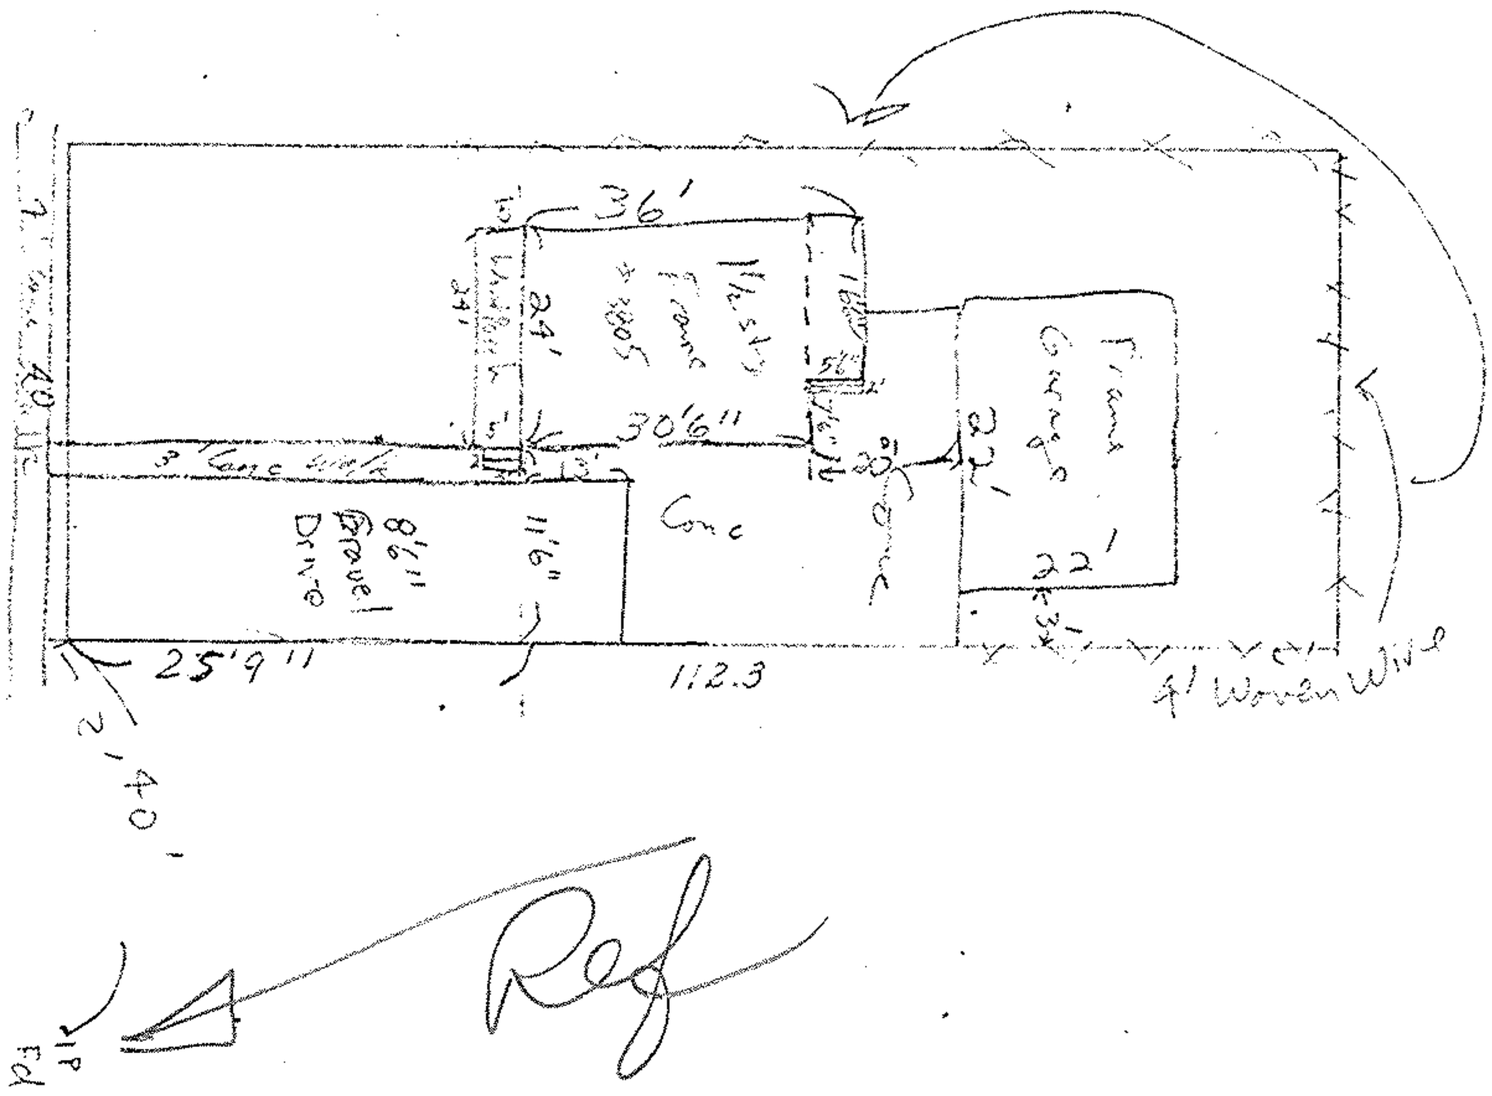

1" = 20'

SUBLOT #40 of BLOCK 8 of CITY
VIEW ALLOT. PLAT VOL. 6, PG. 8
PART of ORIG SHEFFIELD TWP. LOT 103
NOW in CITY of LORAIN, OHIO

McGLINCHY & ASSOCIATES
MAR. 1977 #771730