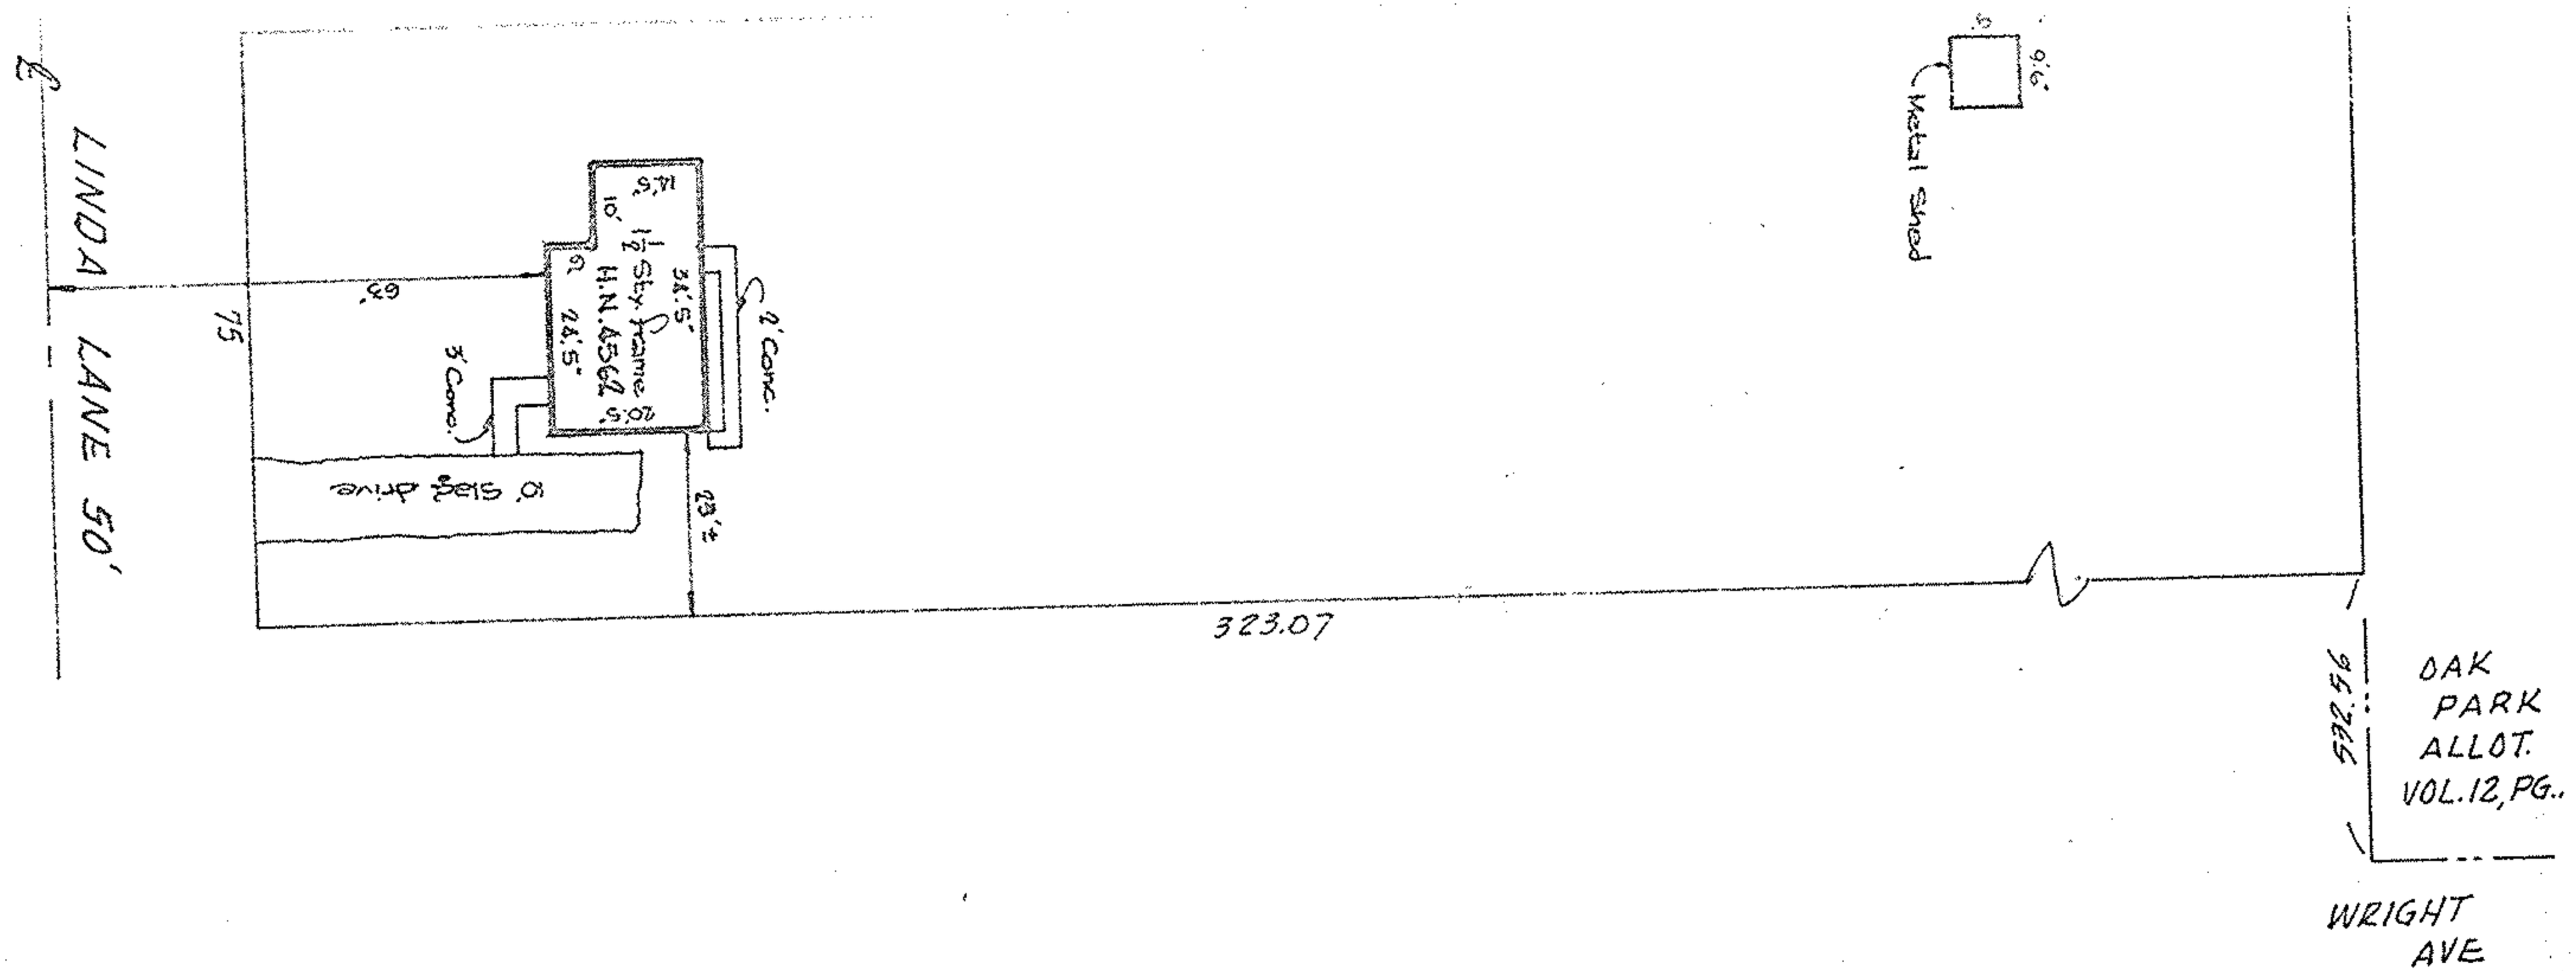

D.D. # 3-00-066-103-006 .556 Ac
PART OF ORIG. SHEFFIELD TWP.
LOT 66 - NOW in SHEFIELD VILLAGE
LORAIN COUNTY, OHIO

McGLINCHY & ASSOCIATES
MAY 28, 1976 #76981

LT # 43,858