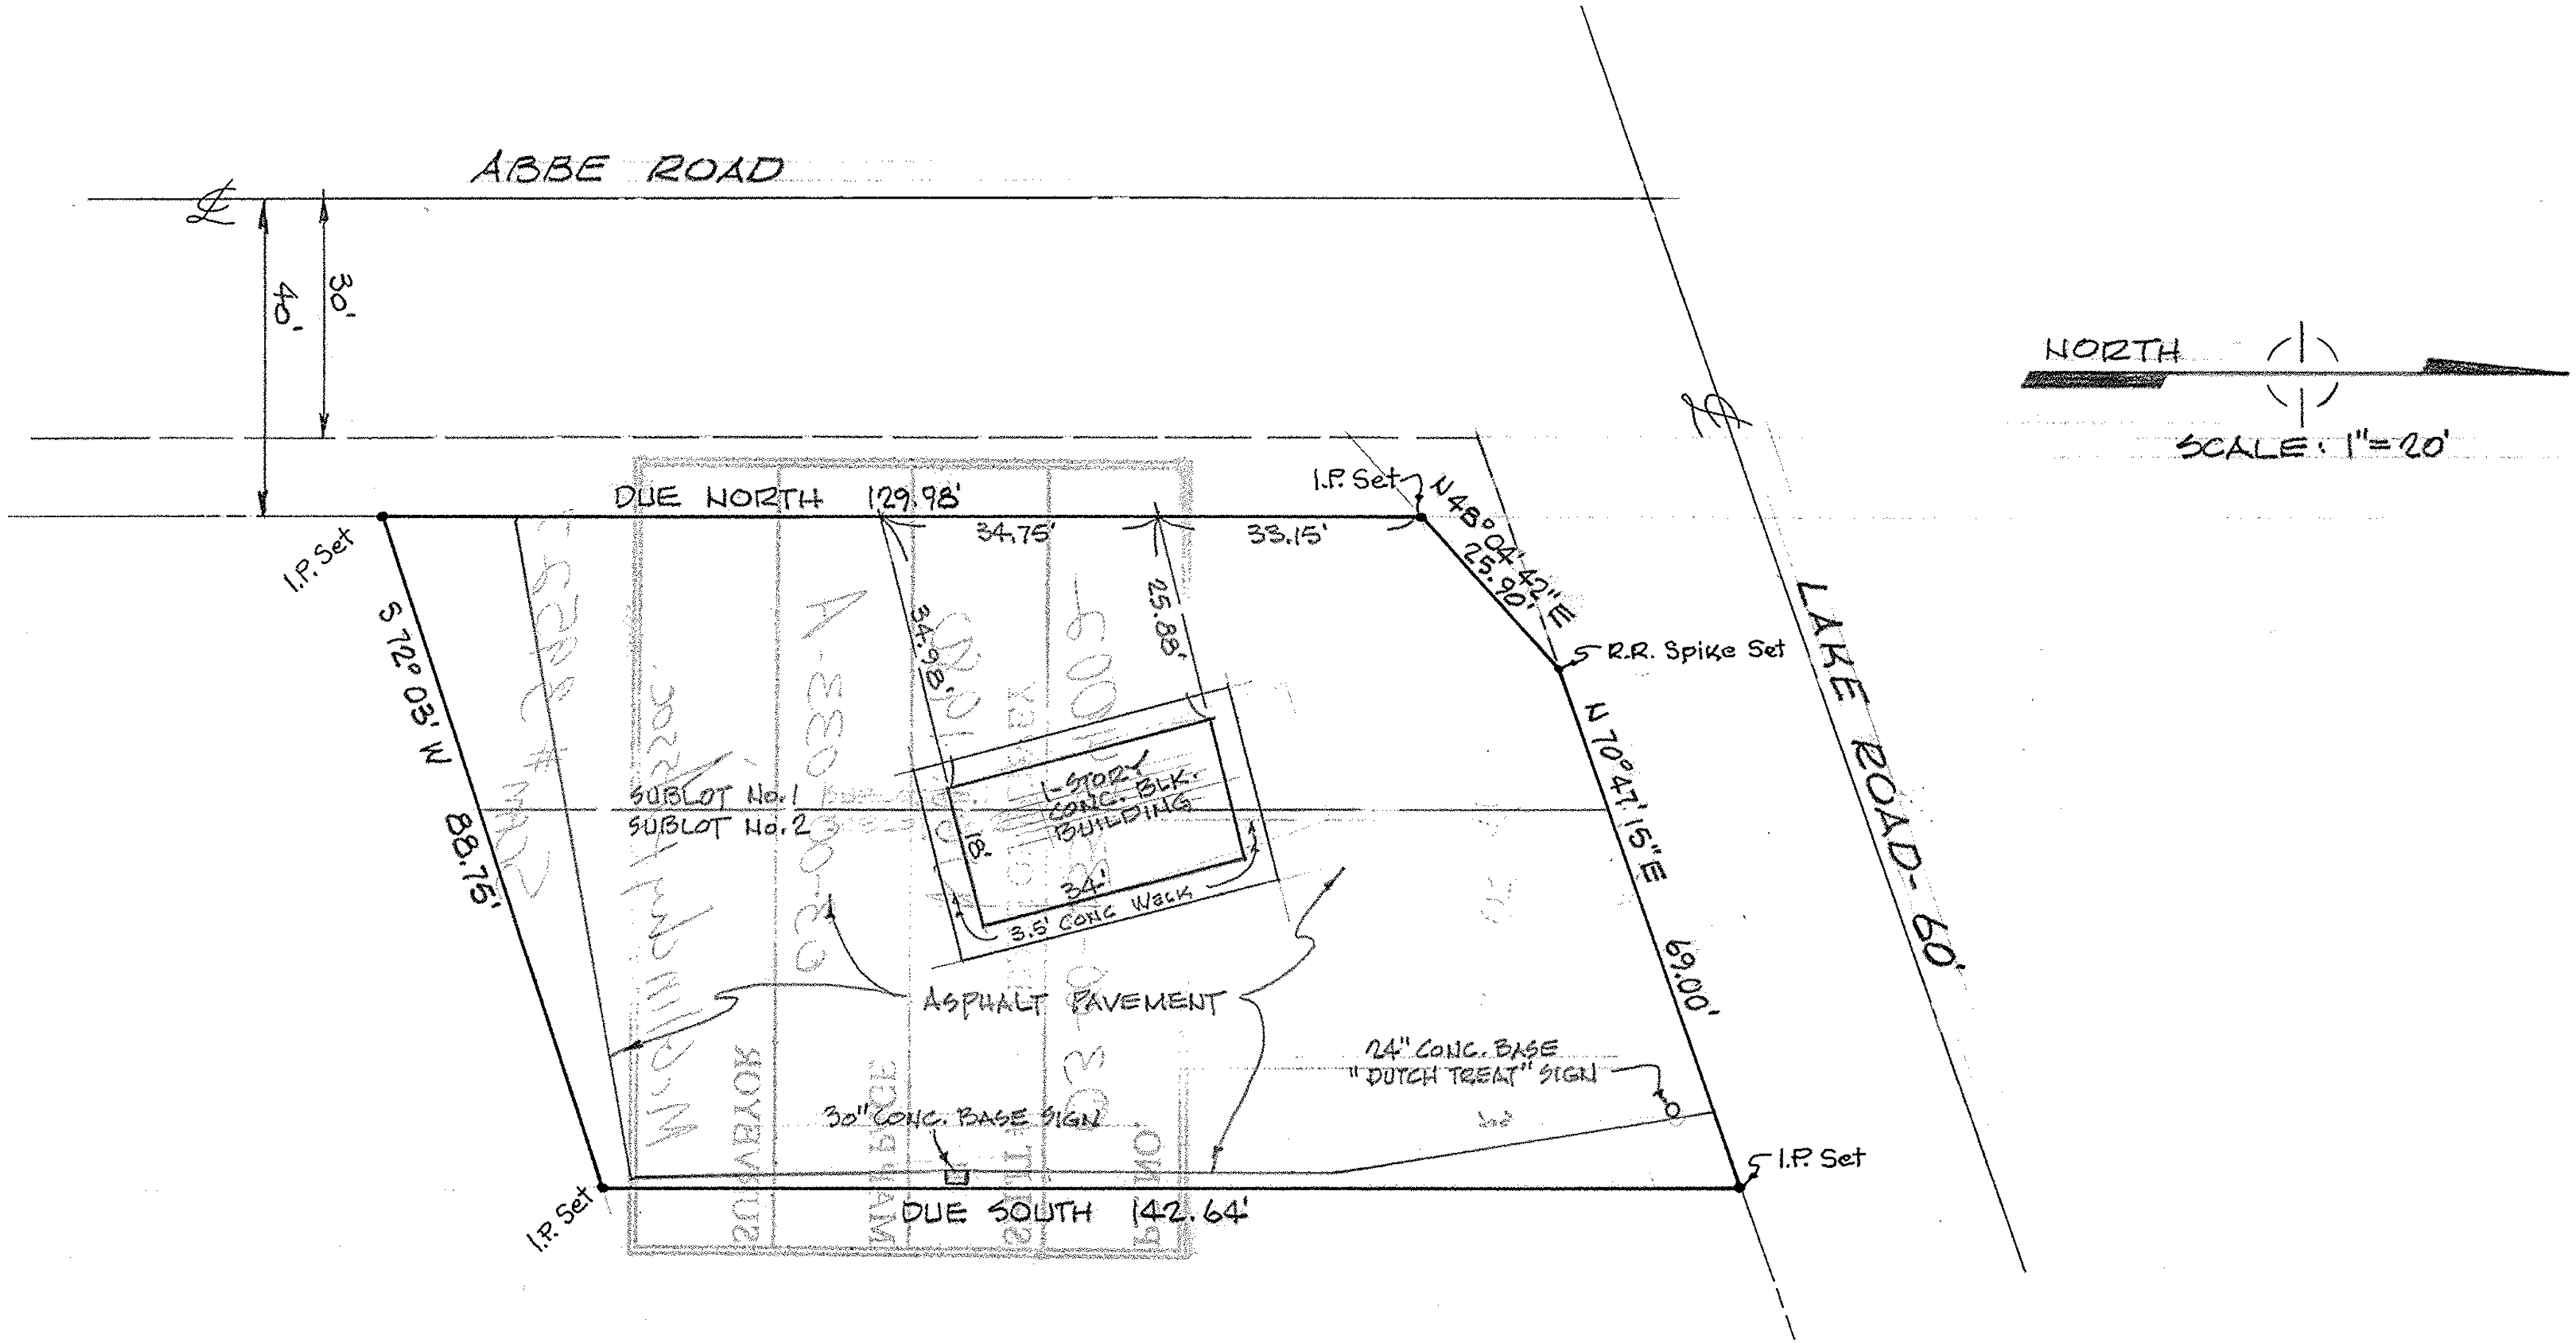

MAP of SURVEY

PREPARED FOR GEORGE FRAAM

PART of SUBLOT No. 1 and ALL of SUBLOT No. 2 in SUNSET COUNTRY CLUB ALLOTMENT (BLOCK-B) - PLAT VOL. 11, PG. 6
CITY of SHEFFIELD LAKE, LORAIN COUNTY, OHIO

McGLINCHY and ASSOCIATES INC.
PROFESSIONAL ENGINEER and SURVEYORS
110½ MIDDLE AVE. ELYRIA, OHIO
NOVEMBER, 1980 # 806553-A