


E BUCKEYE DRIVE 70'

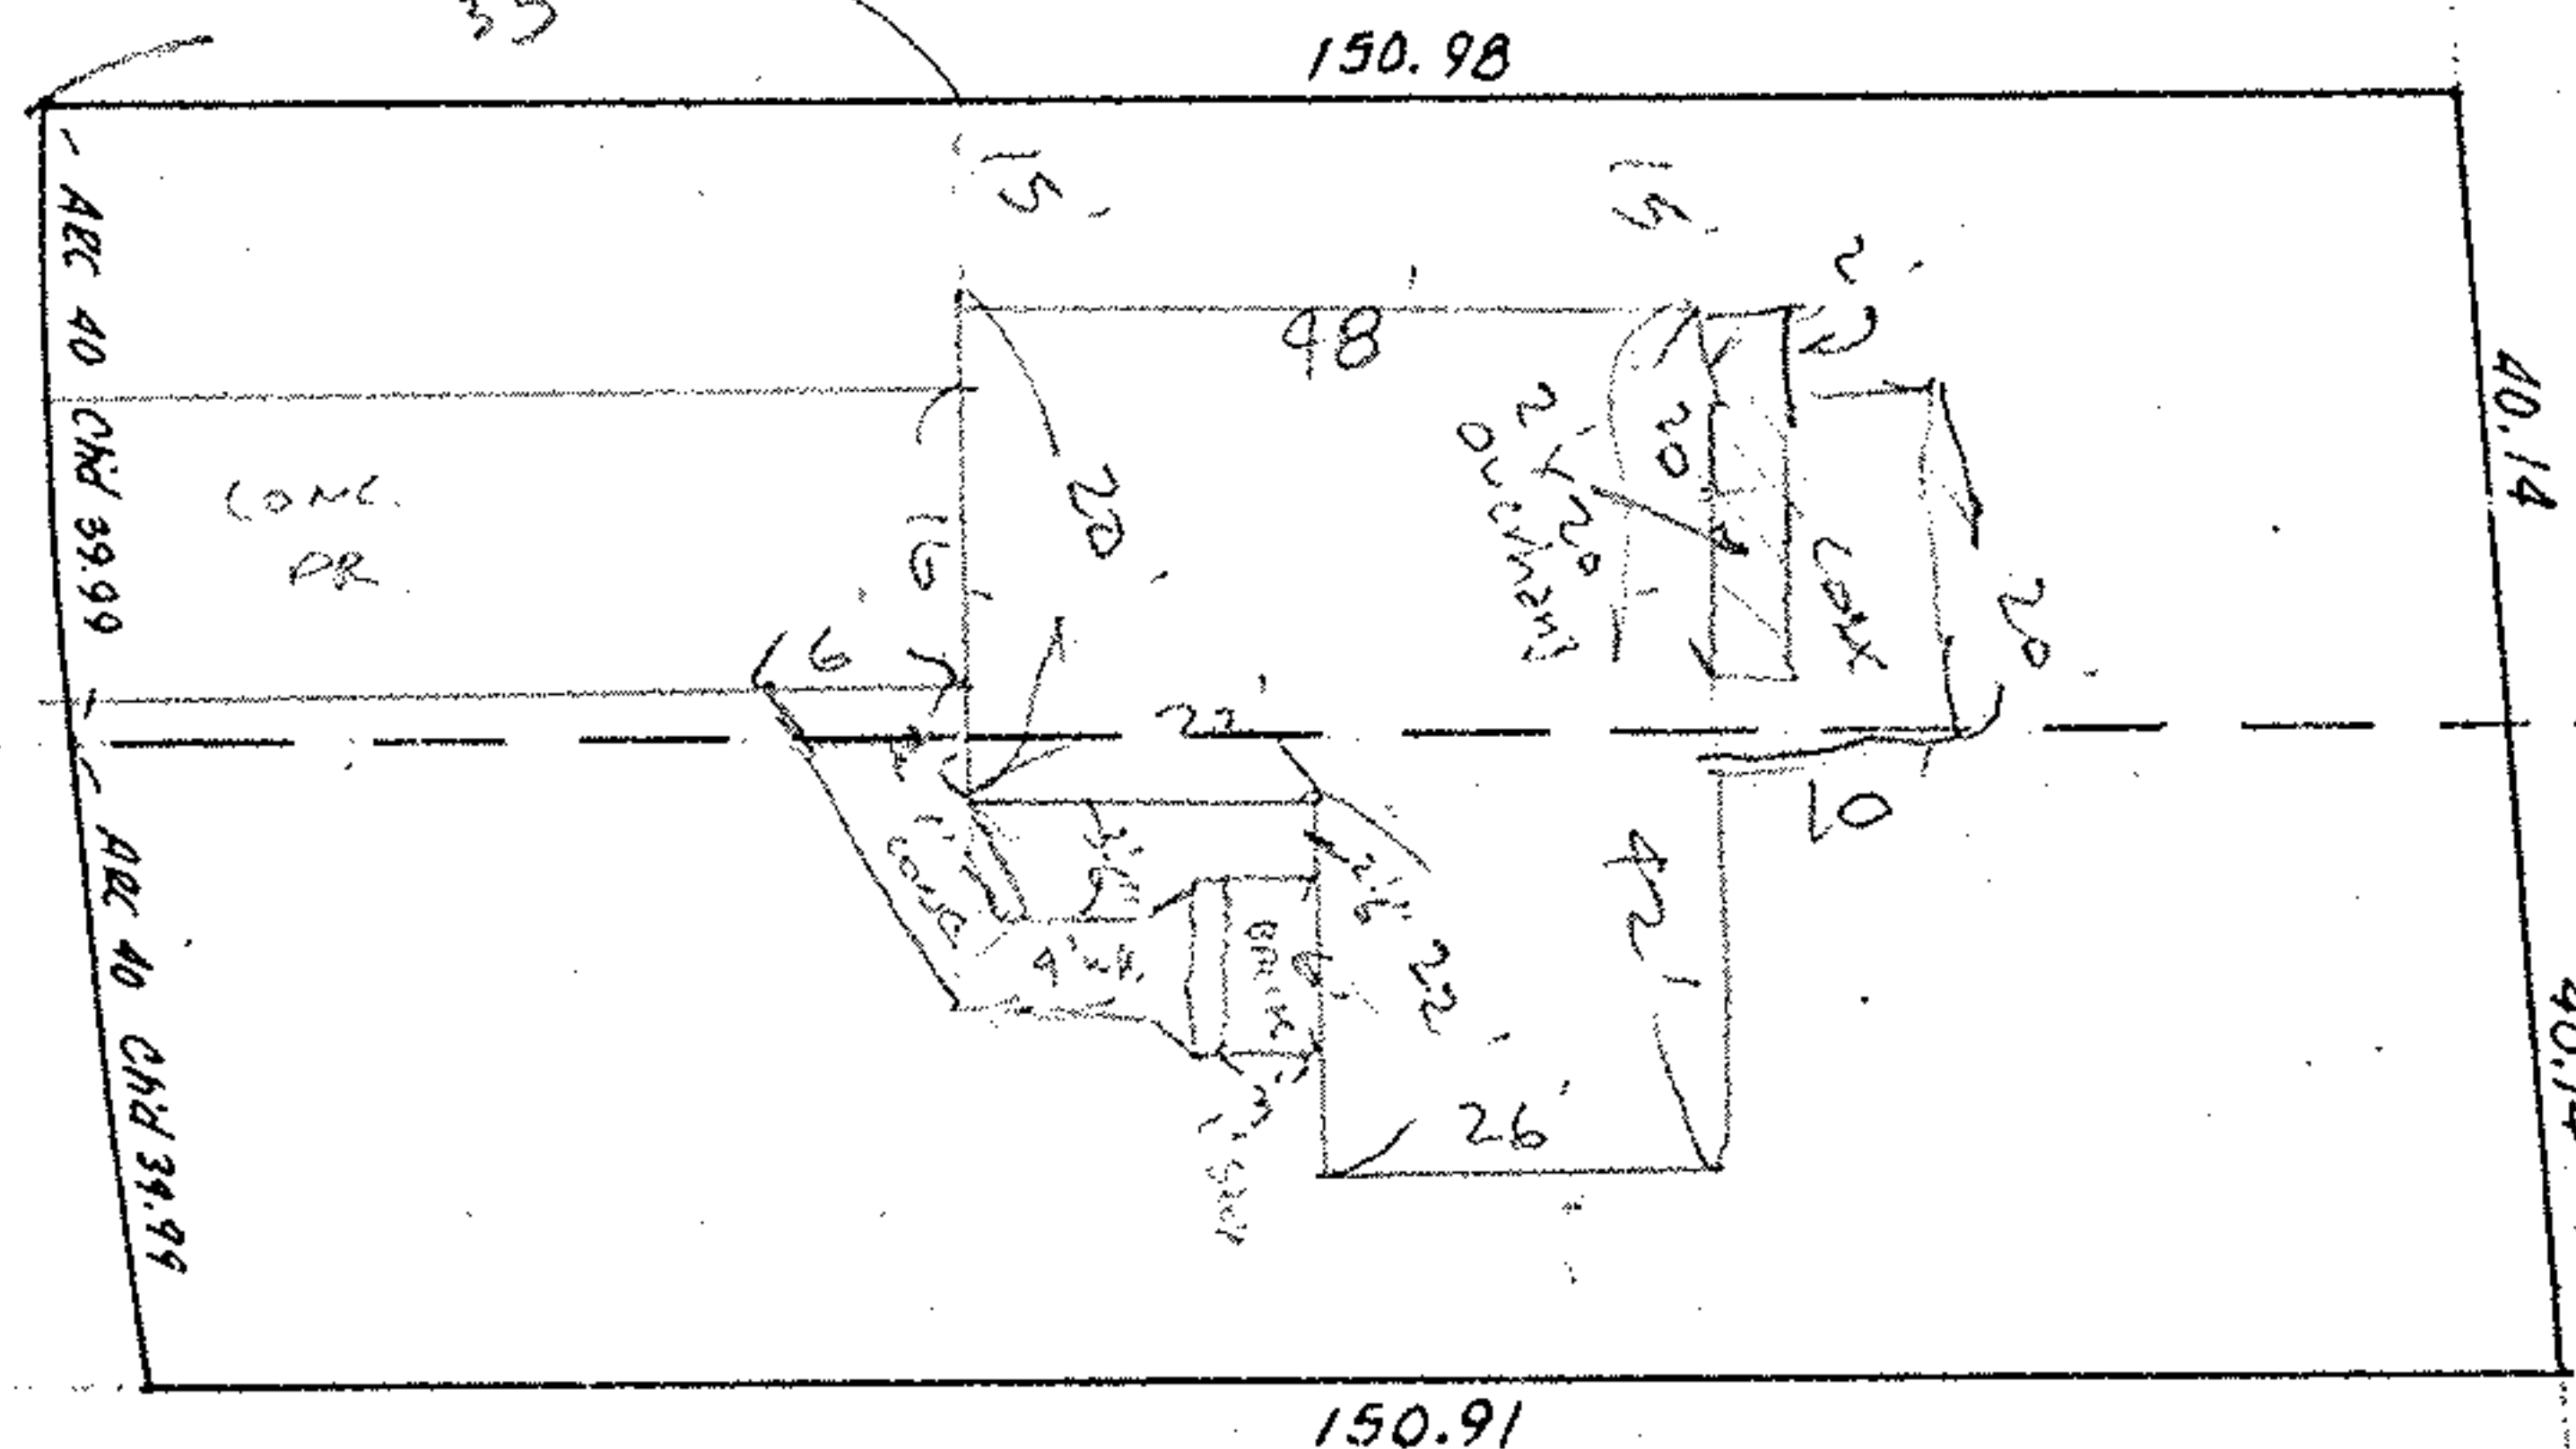

1" = 20'

SUBLOTS # 74 & 75 of BLOCK 'C' of BORDER CITIES CO'S
 SHORE SUBDIVISION & BUCKEYE COUNTRY CLUB
 PLAT VOL. 10 PAGES 30 & 31
 PART of ORIG. SHEFFIELD TWP. LOT 35
 NOW in CITY of SHEFFIELD LAKE, OHIO

McGLINCHY & ASSOCIATES
 JUNE 1977 *772006
 Midt E:8999