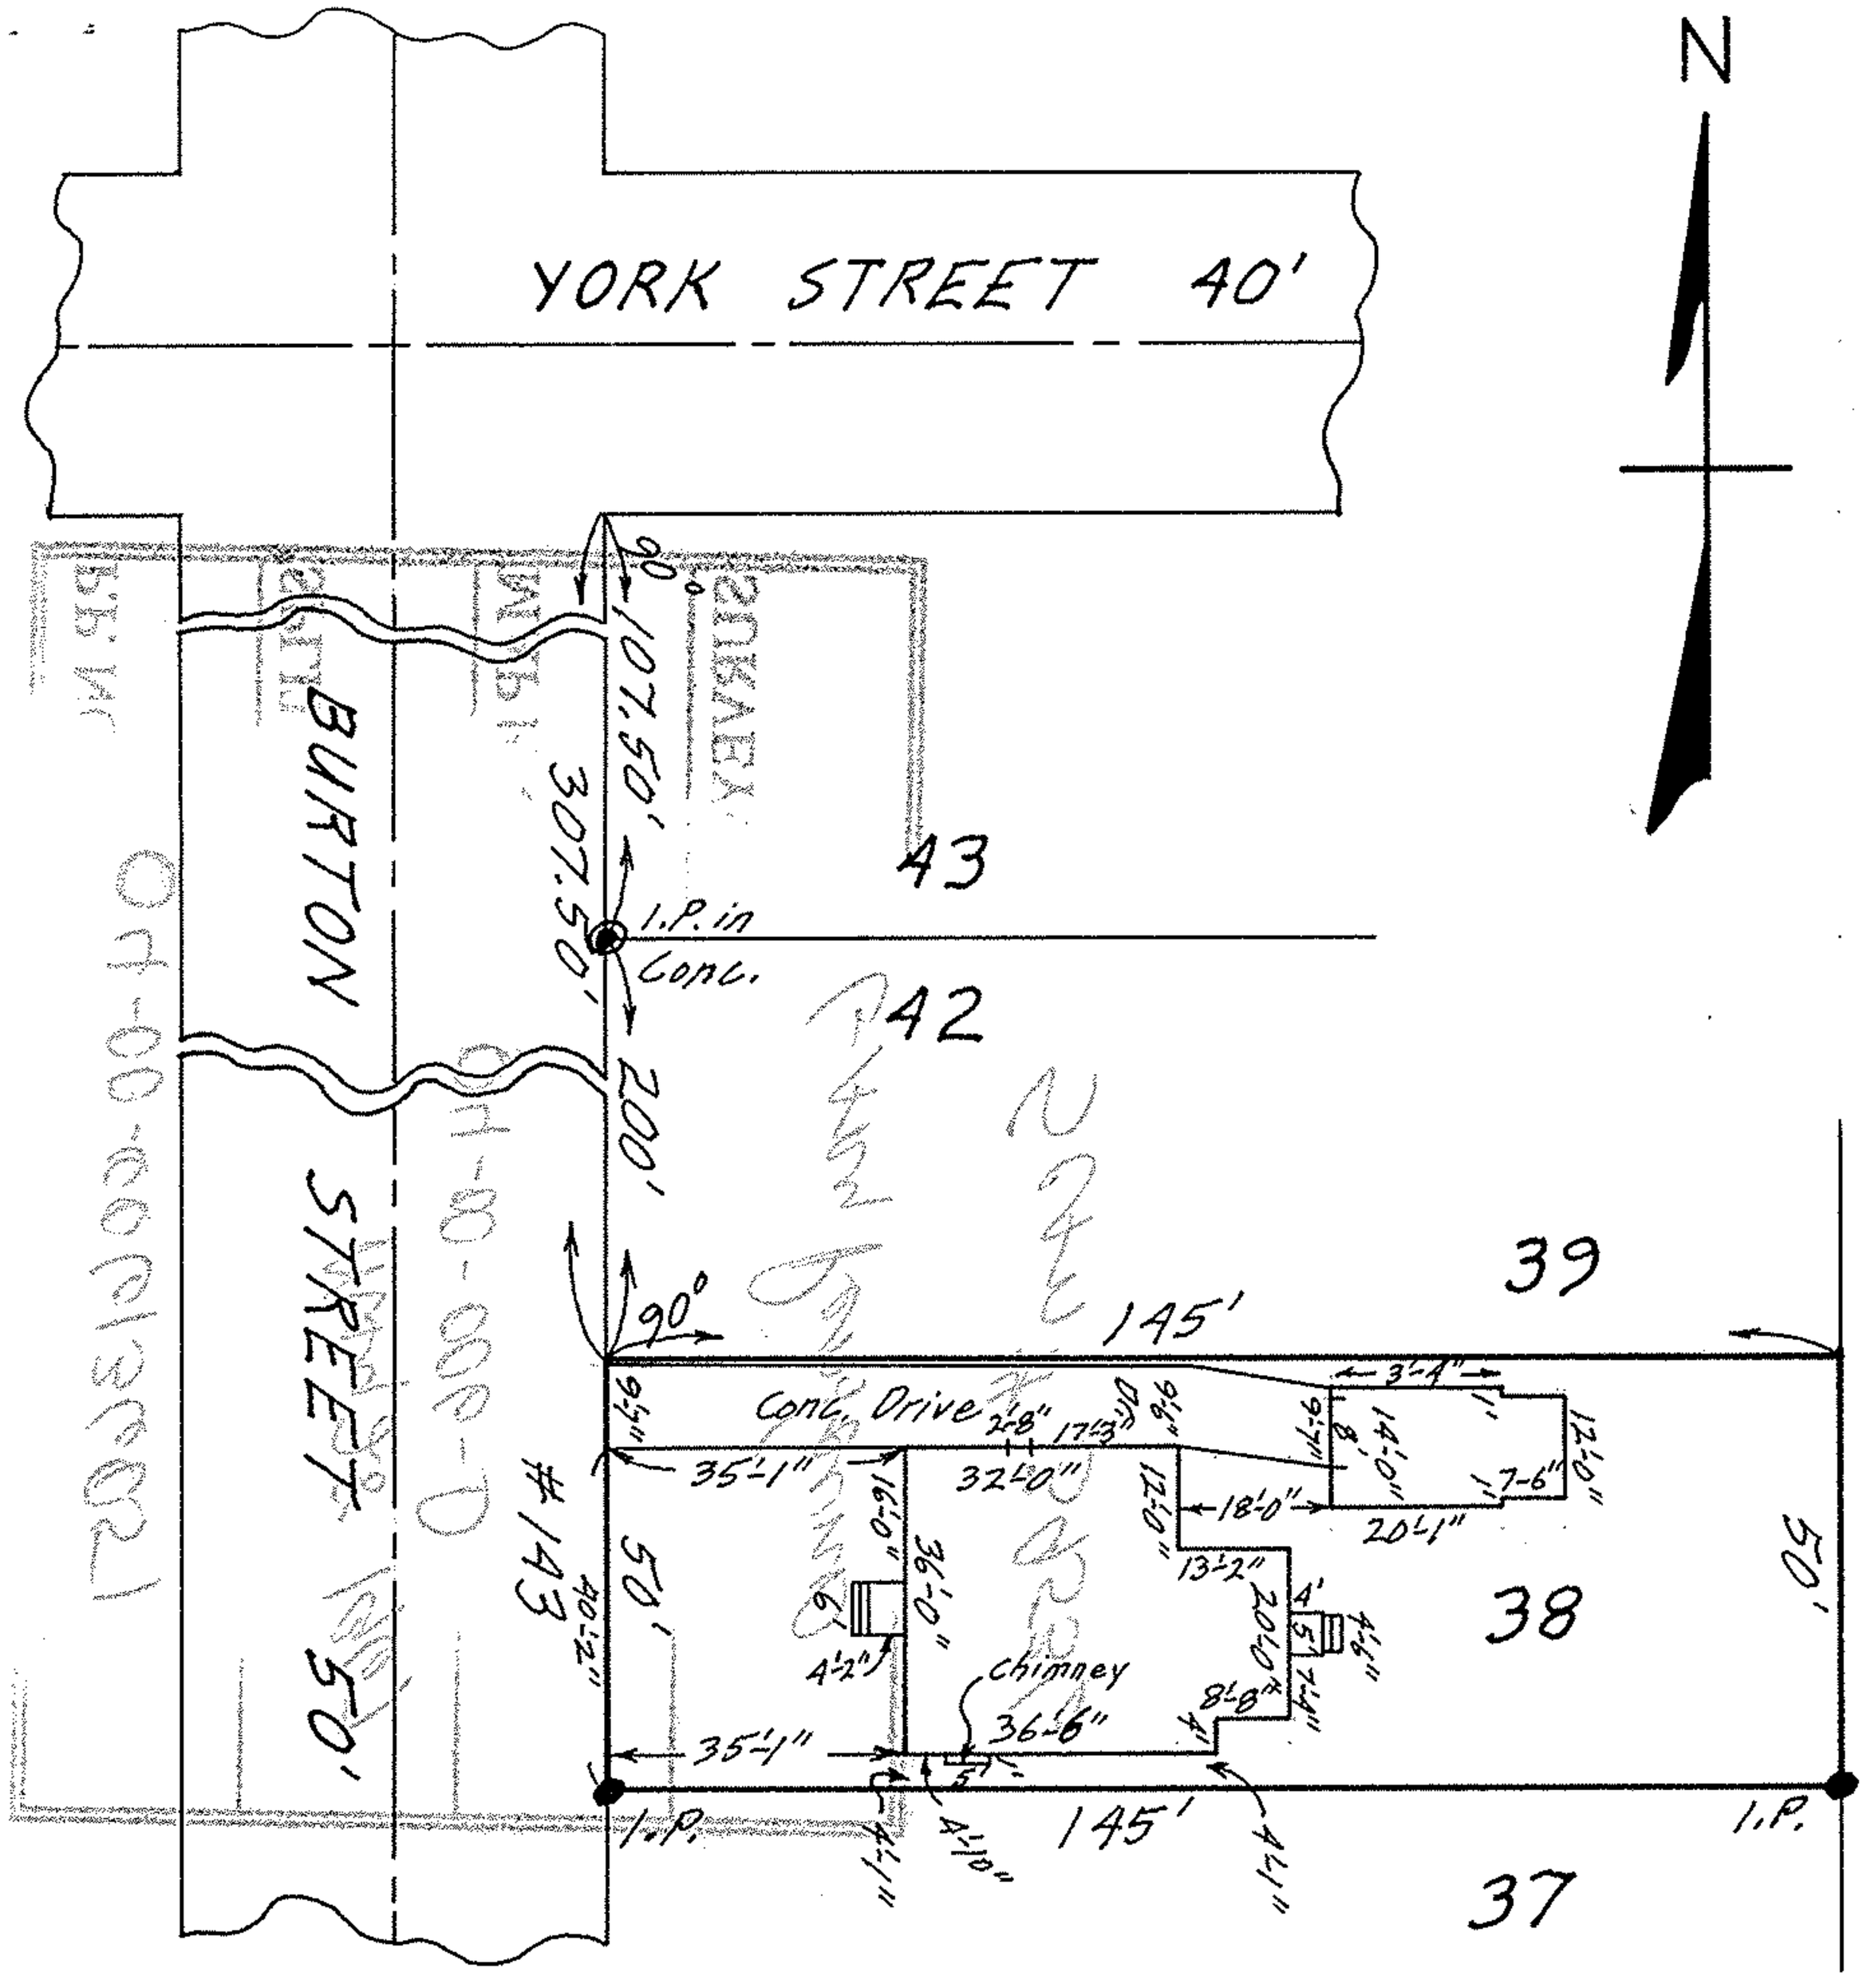

MAP OF SUB-LOT NO. 38
BEACH PARK ALL'T. VOL. 6 PG. 34
SECTION NO. 6 AVON TOWNSHIP
AVON LAKE CITY
LORAIN COUNTY OHIO
SCALE: 1" = 30' MAY 28-1967 3:00 P.M.
Gary E. Penfound REG. SURVEYOR

John P. & Mary Ann Jasko