NOTES: ● indicates iron pin set unless otherwise designated.
Dividing line between Sections 7 & 14 cannot be located.

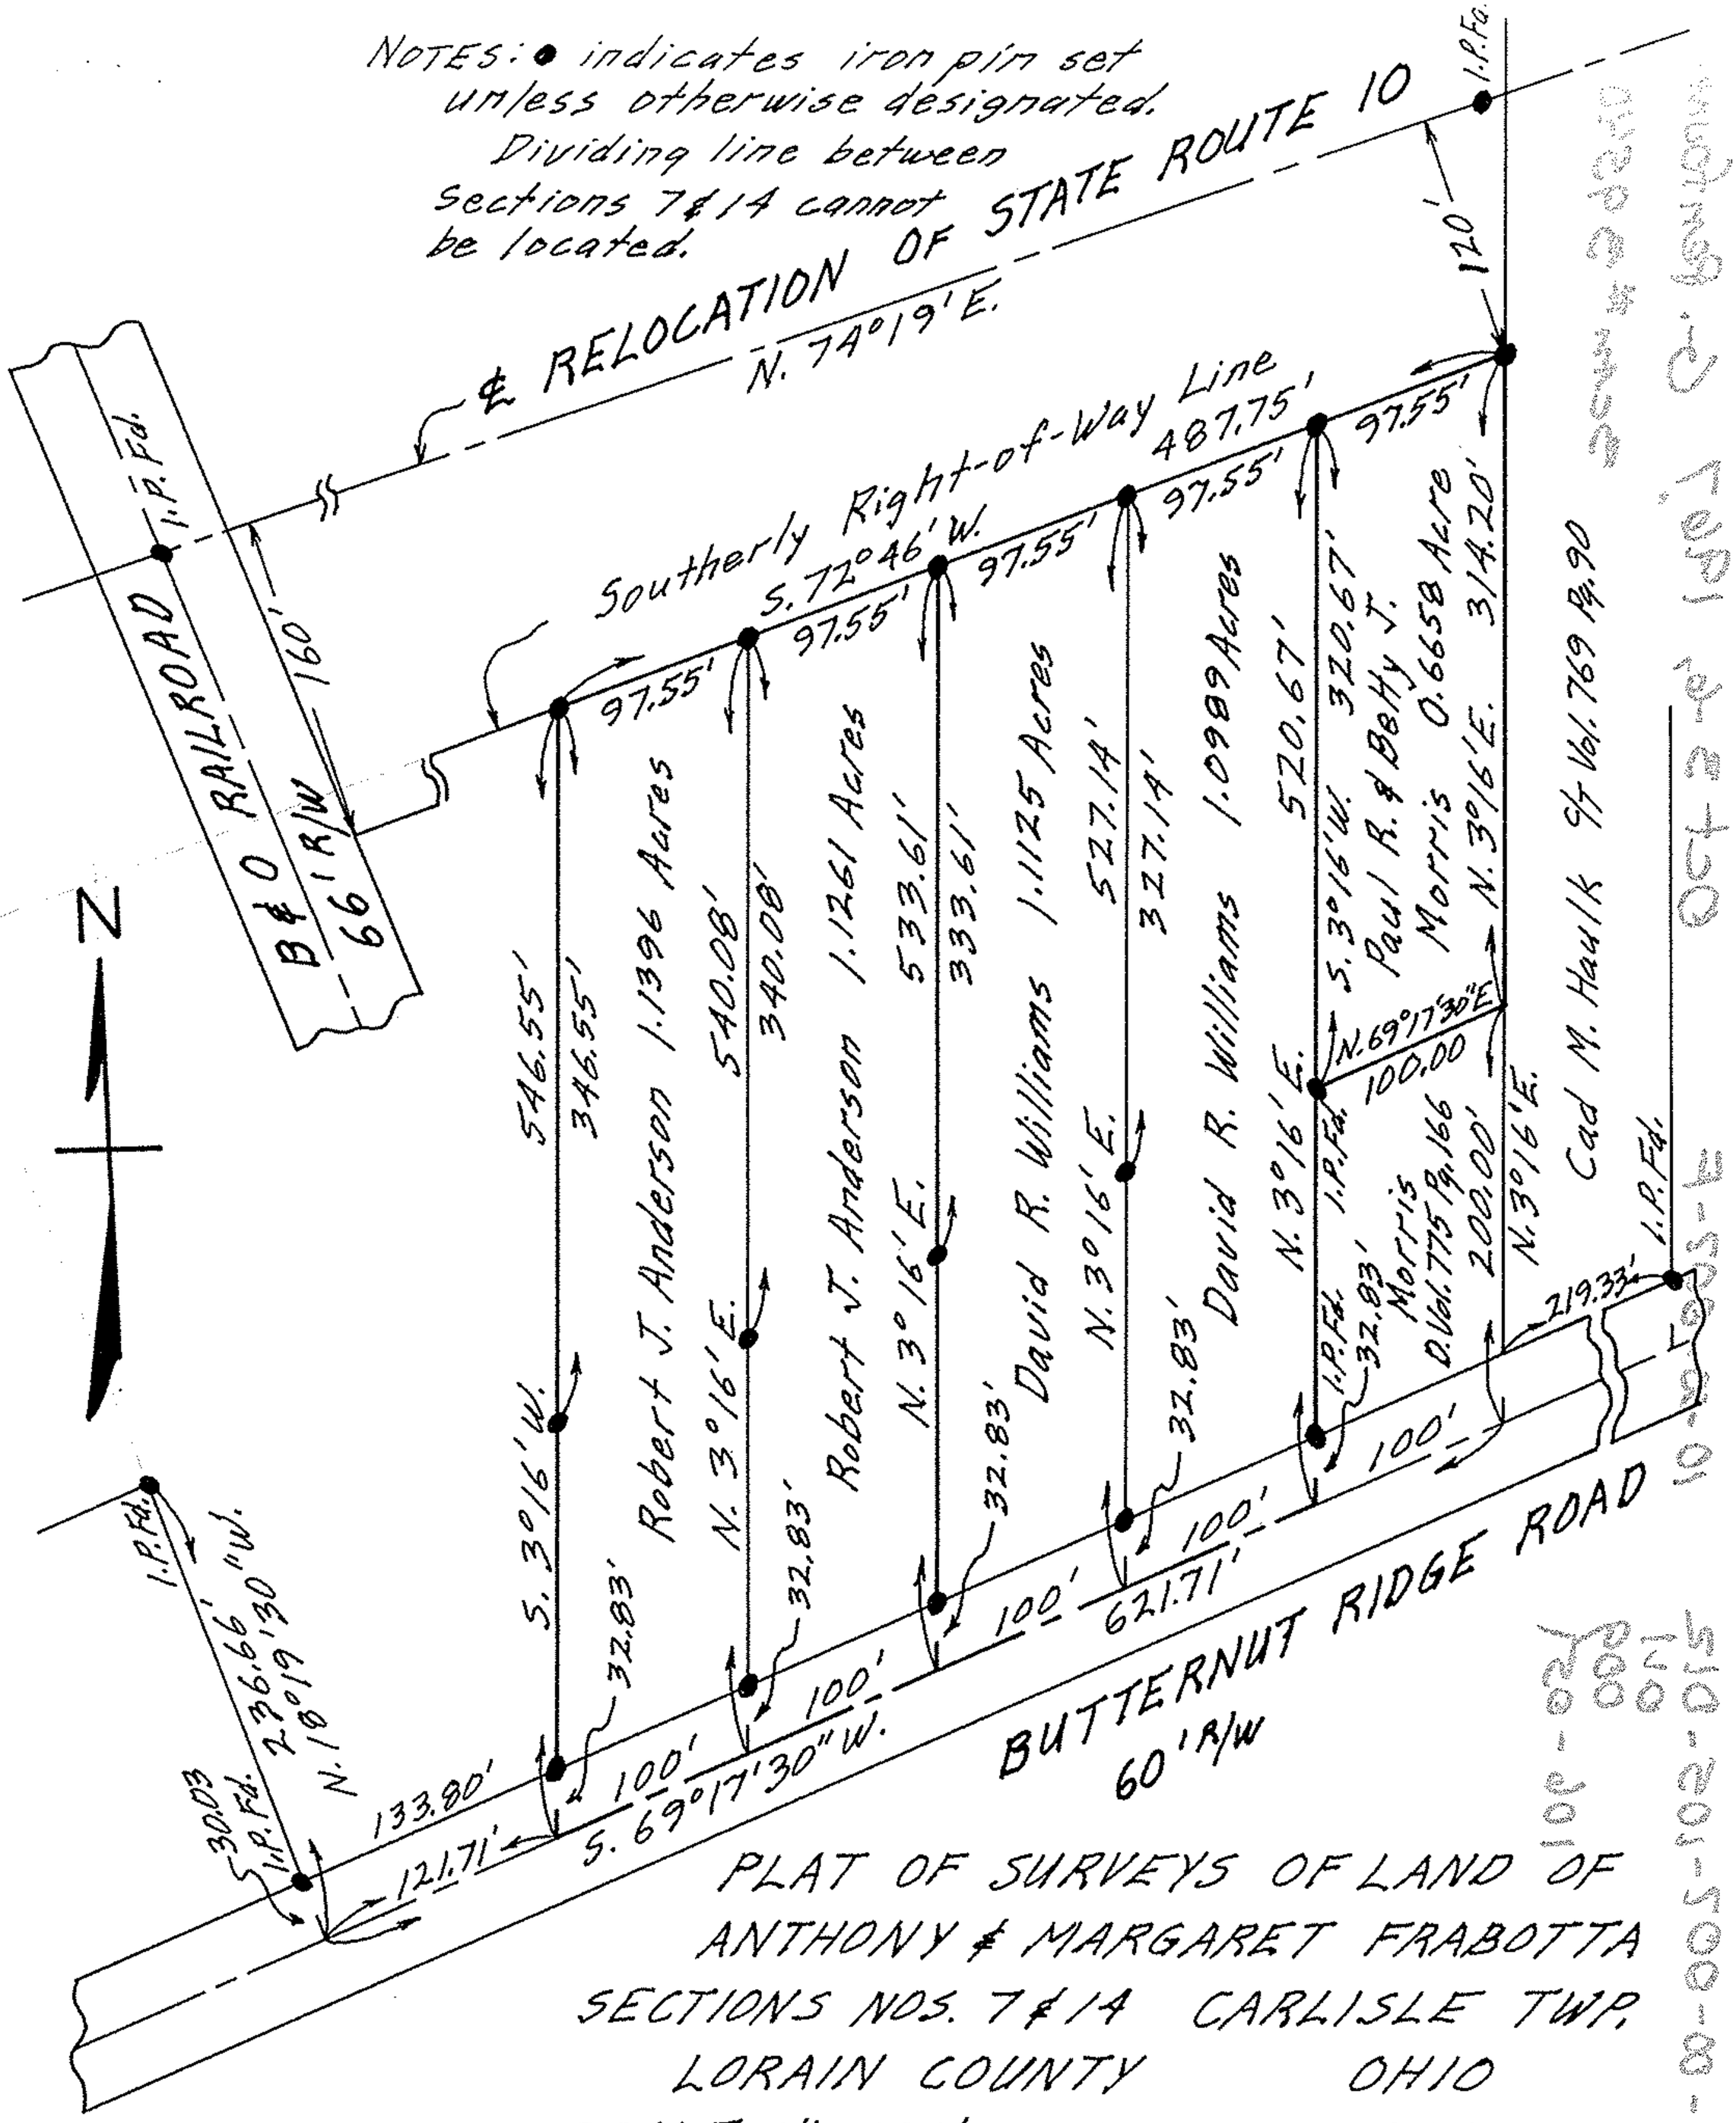

PLAT OF SURVEYS OF LAND OF
ANTHONY & MARGARET FRABOTTA
SECTIONS NOS. 7 & 14 CARLISLE TWP.
LORAIN COUNTY OHIO
SCALE: 1" = 100' OCT. 3-6, 1967
Gary E. Penfound Reg. Surveyor