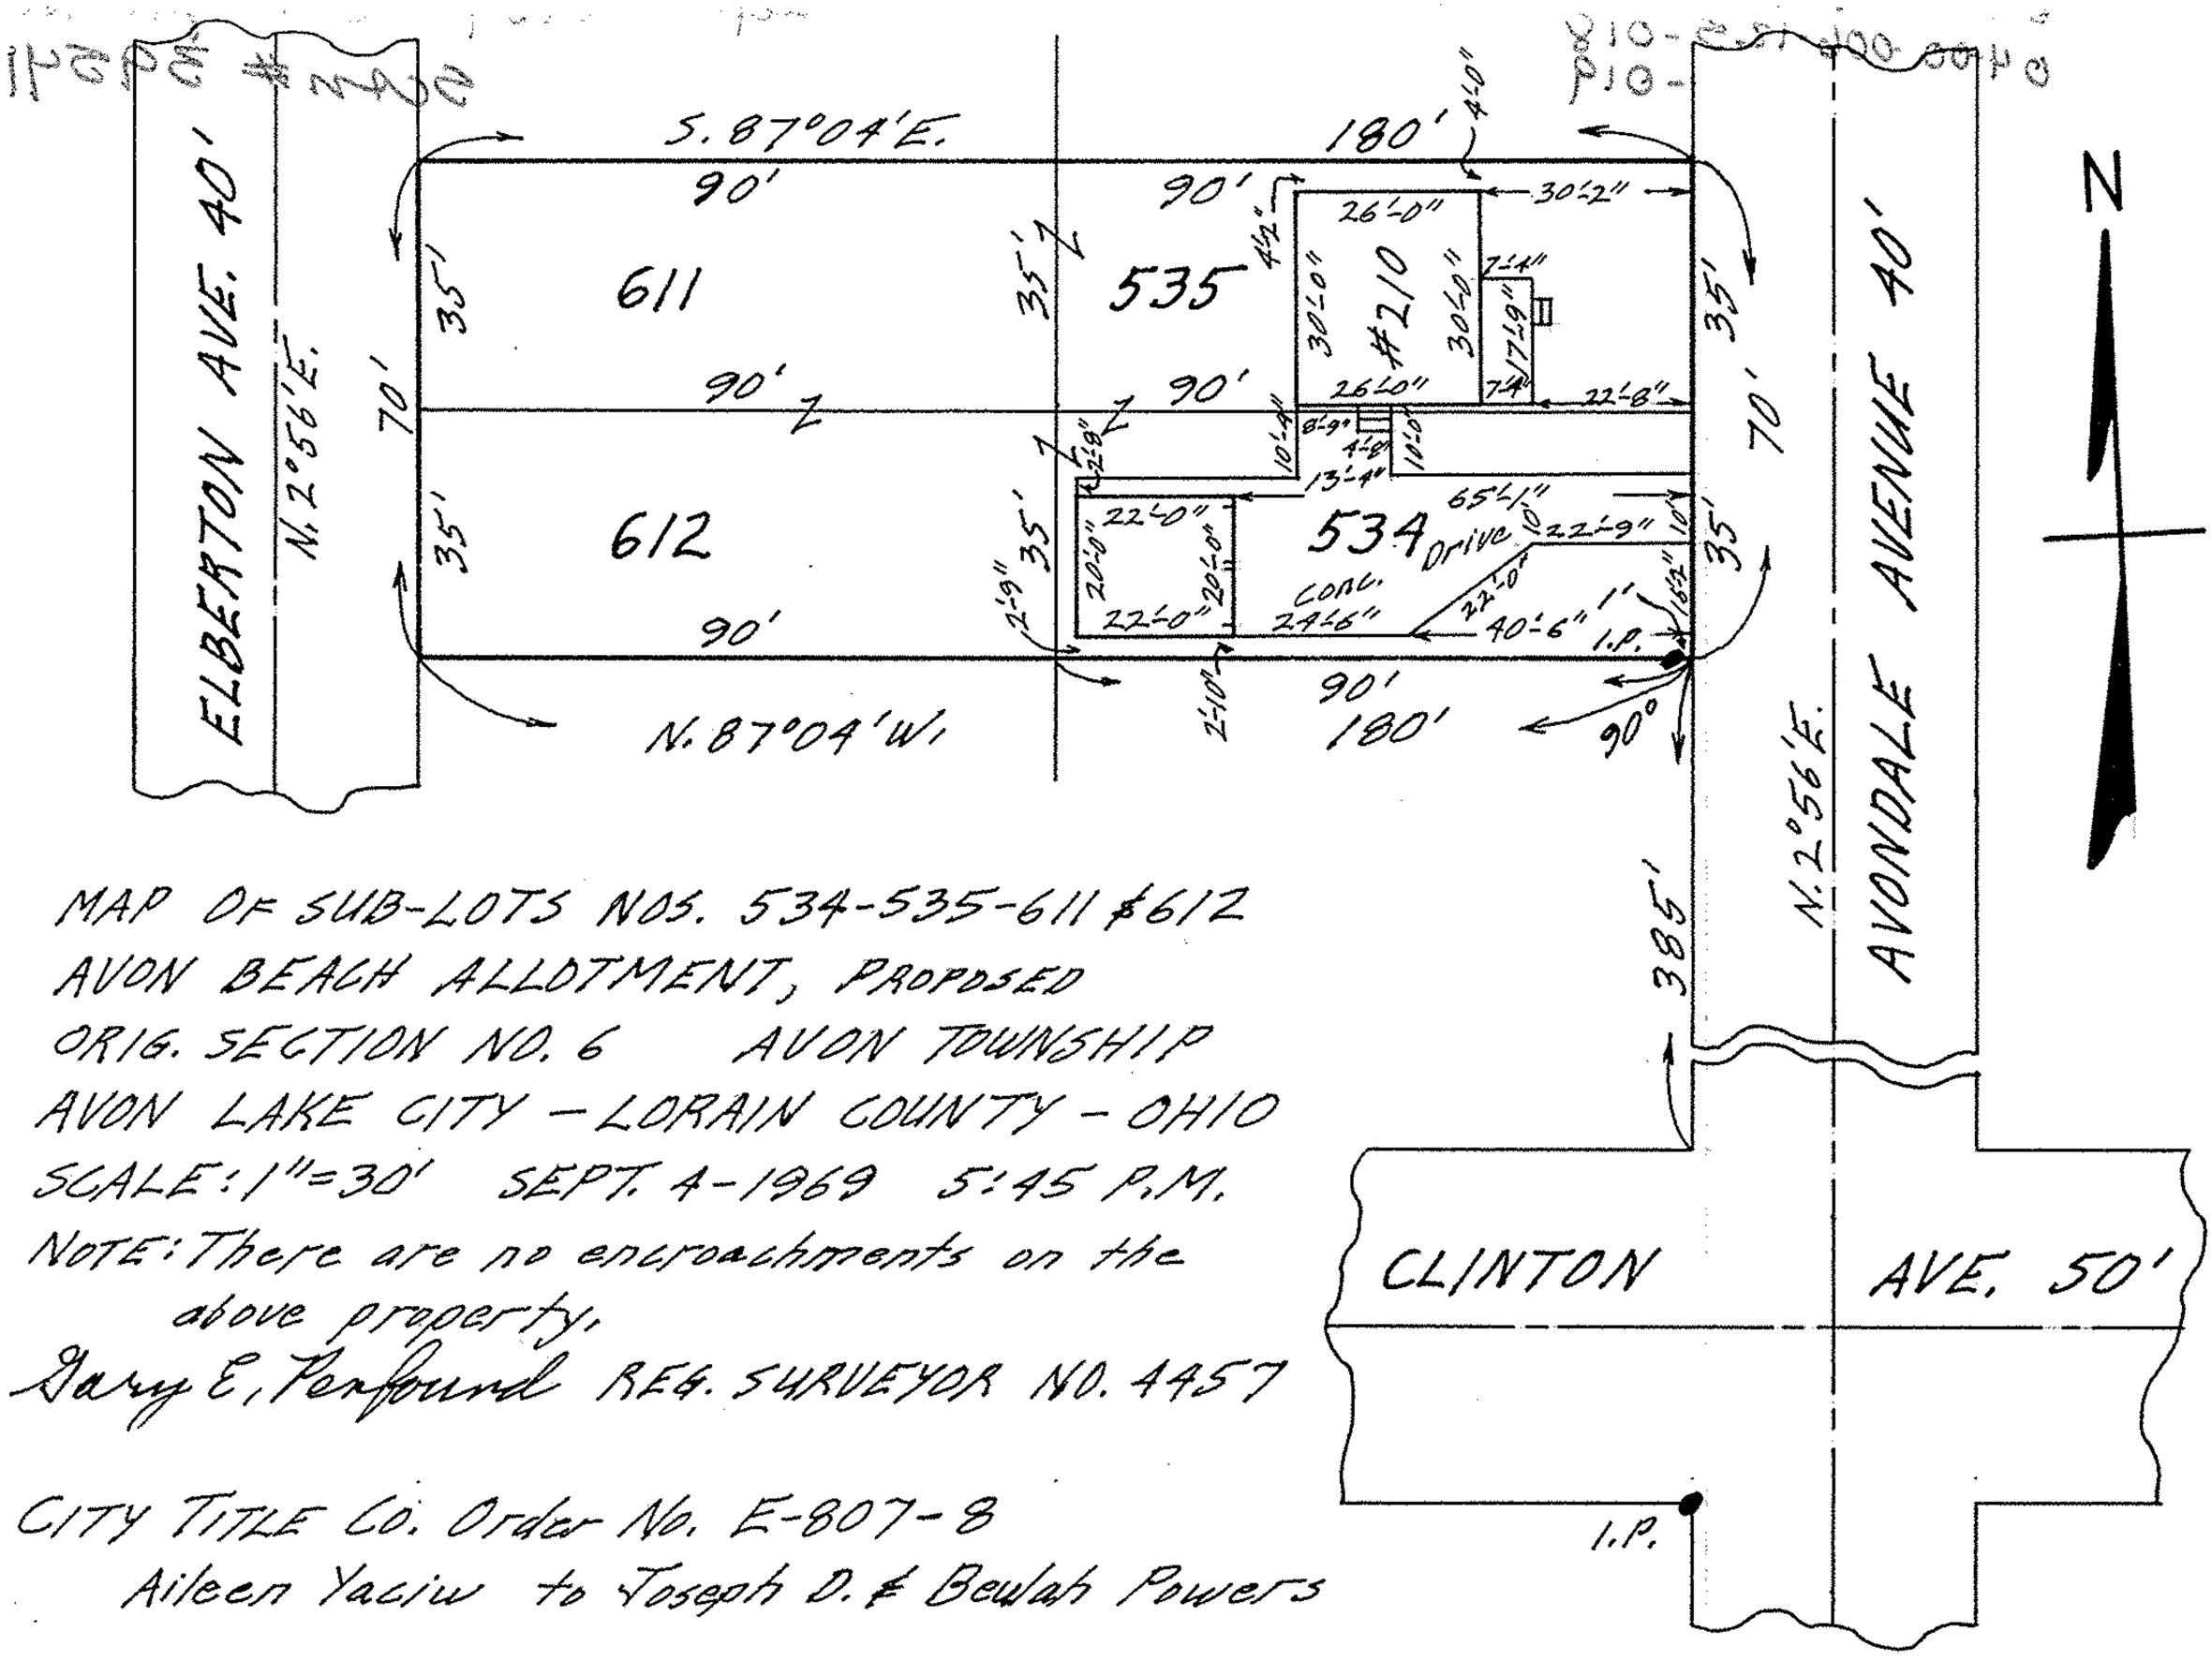

MAP OF SUB-LOTS NOS. 534-535-611 & 612
AVON BEACH ALLOTMENT, PROPOSED
ORIG. SECTION NO. 6 AVON TOWNSHIP
AVON LAKE CITY – LORAIN COUNTY – OHIO
SCALE: 1"=30' SEPT. 4-1969 5:45 P.M.
NOTE: There are no encroachments on the above property.

Gary E. Perfound REG. SURVEYOR NO. 4457

CITY TITLE CO. Order No. E-807-8
Aileen Yaciw to Joseph D. & Beulah Powers