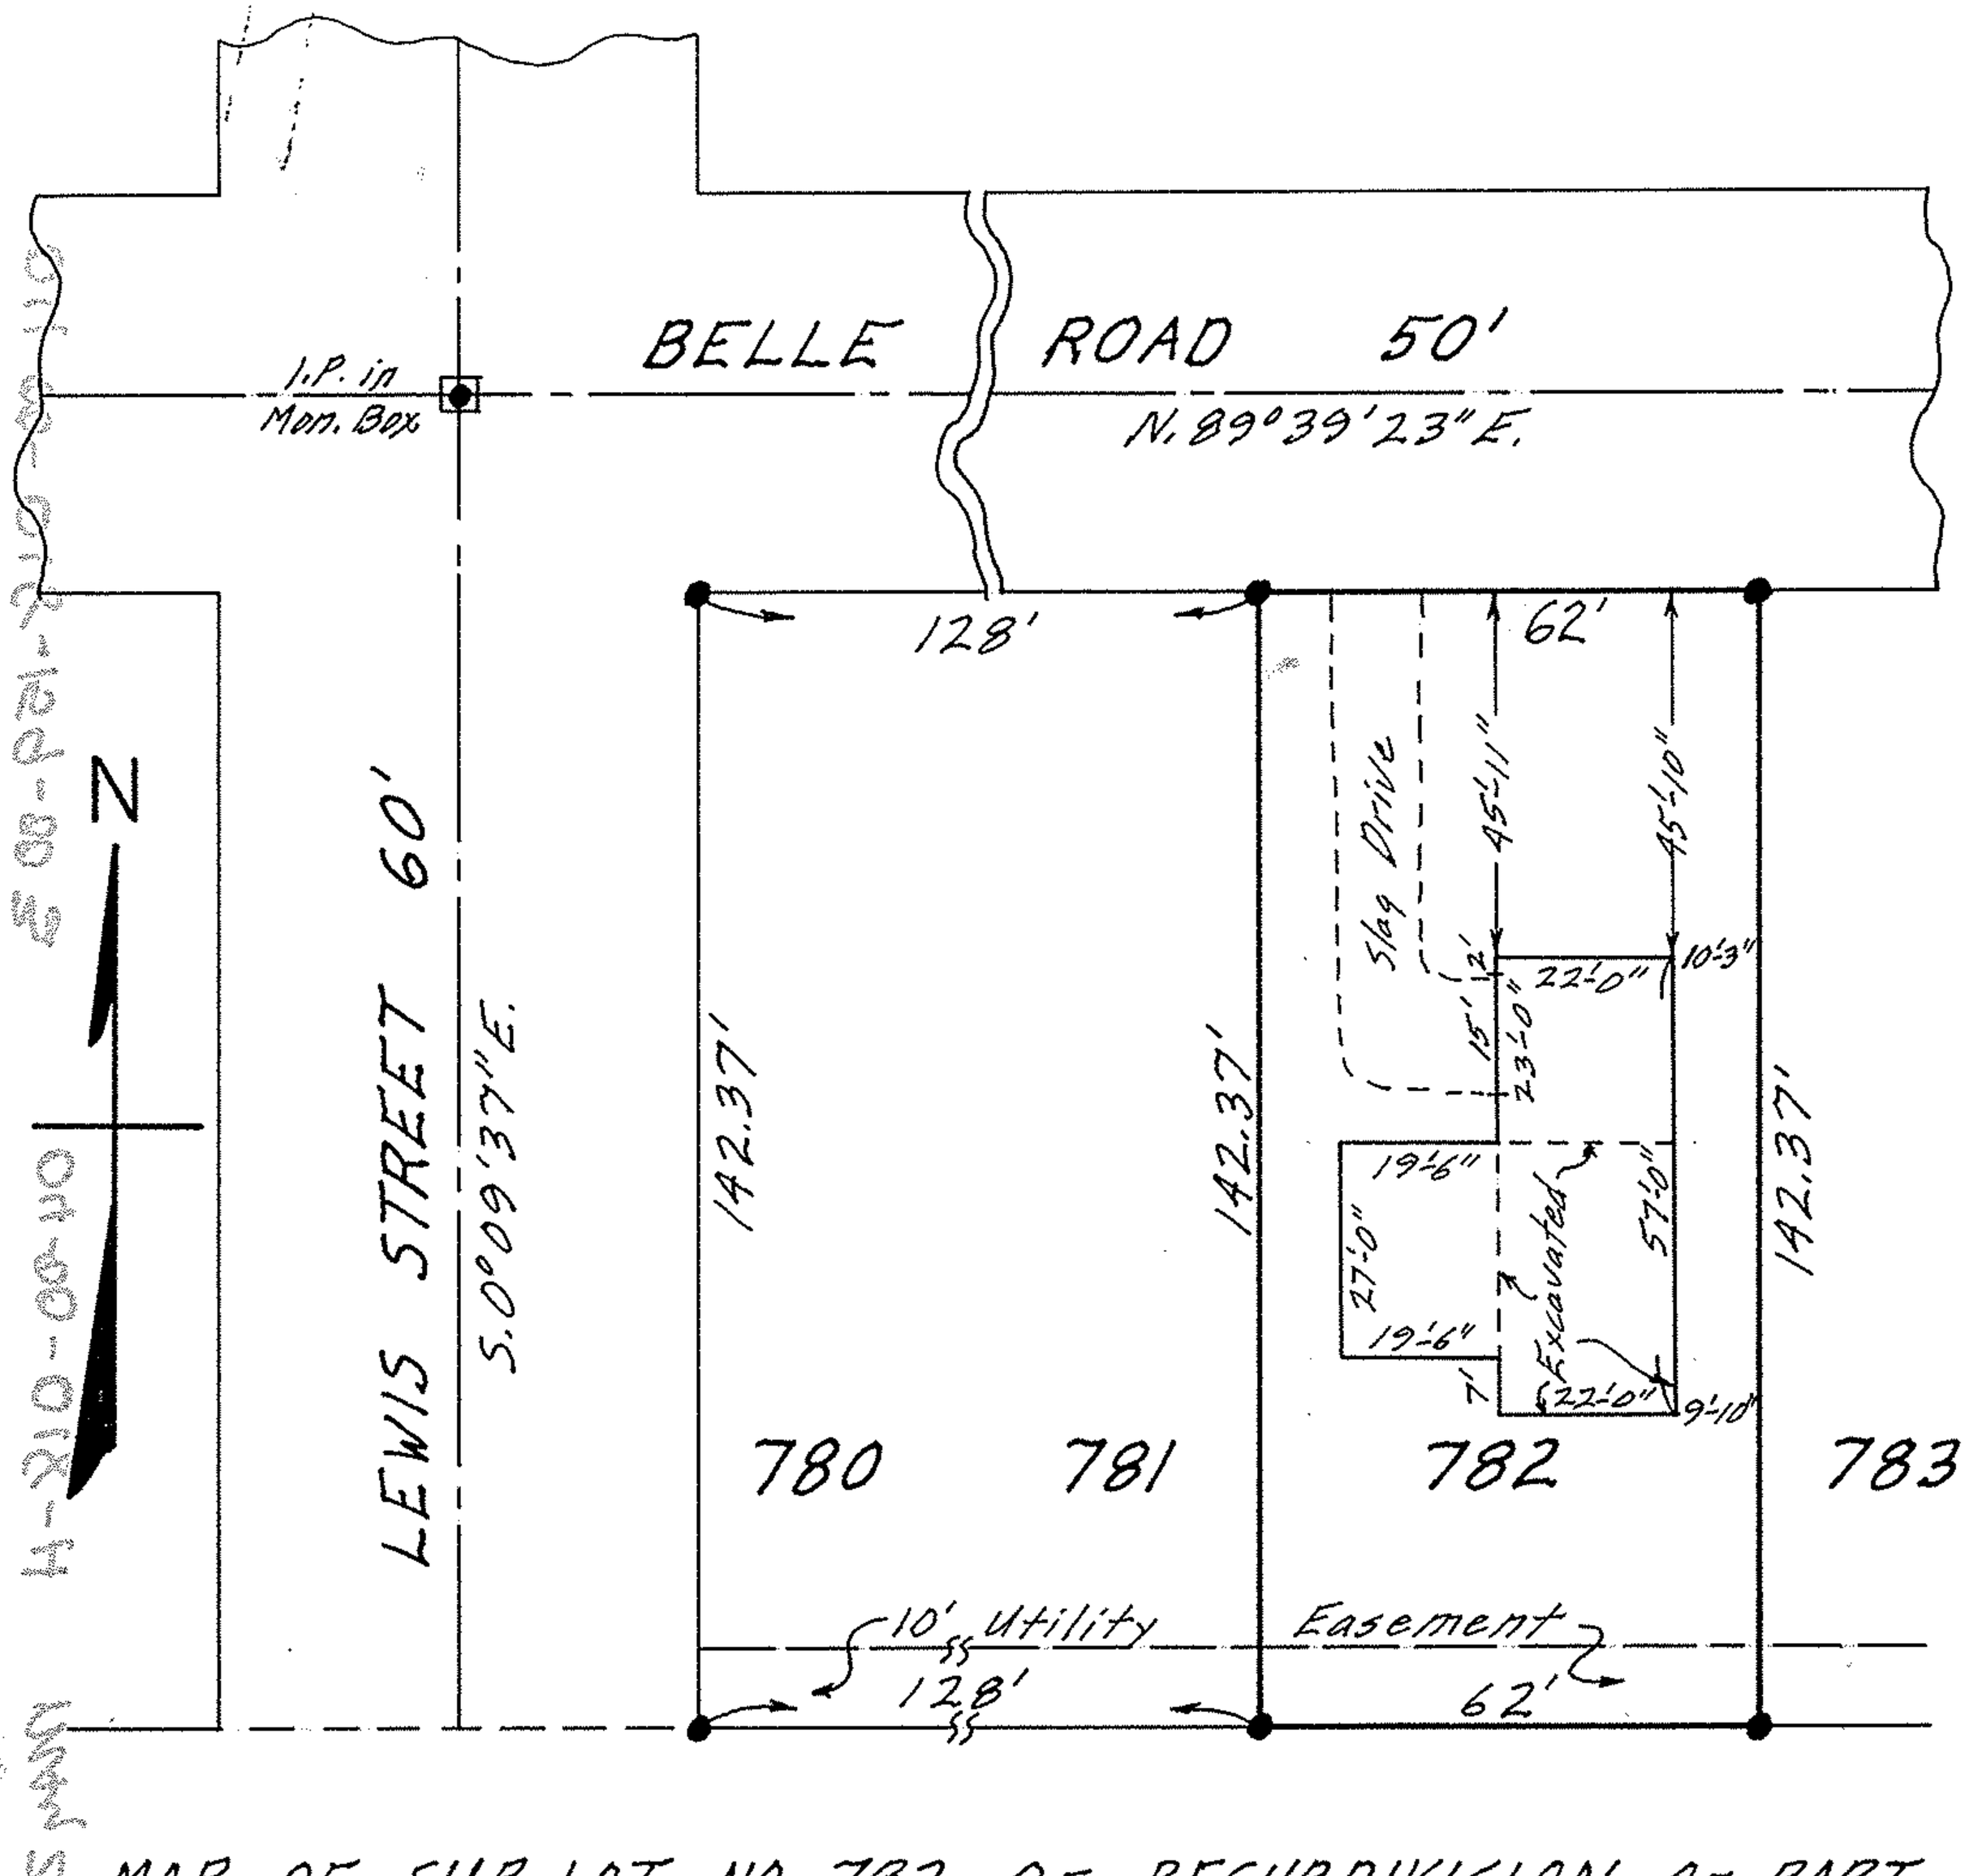

MAP OF SUB-LOT NO. 782 OF RESUBDIVISION OF PART OF BELDEN PARK SUB'N. NO. 2 VOL. 18 PG. 24 PLATS
SECTION 18 AVON TWP. - AVON LAKE CITY
LORAIN COUNTY OHIO
SCALE: 1"=30' MAY 28 - 1967 12:30 P.M.
Gary E. Penfound
for C.E. Penfound REG. SURVEYORS

E-15011 Kopf Construction Corp.