MAP OF PART OF SUB-LOT NO. 59
ORIGINAL PLAT OF CHARLESTON
DEED VOL. J PG. 446
BLACK RIVER TWP. — LORAIN CITY
LORAIN COUNTY — OHIO
SCALE: 1" = 20' JULY 7-1966 4:00 P.M.
Gary E. Penfound REG. SURVEYOR

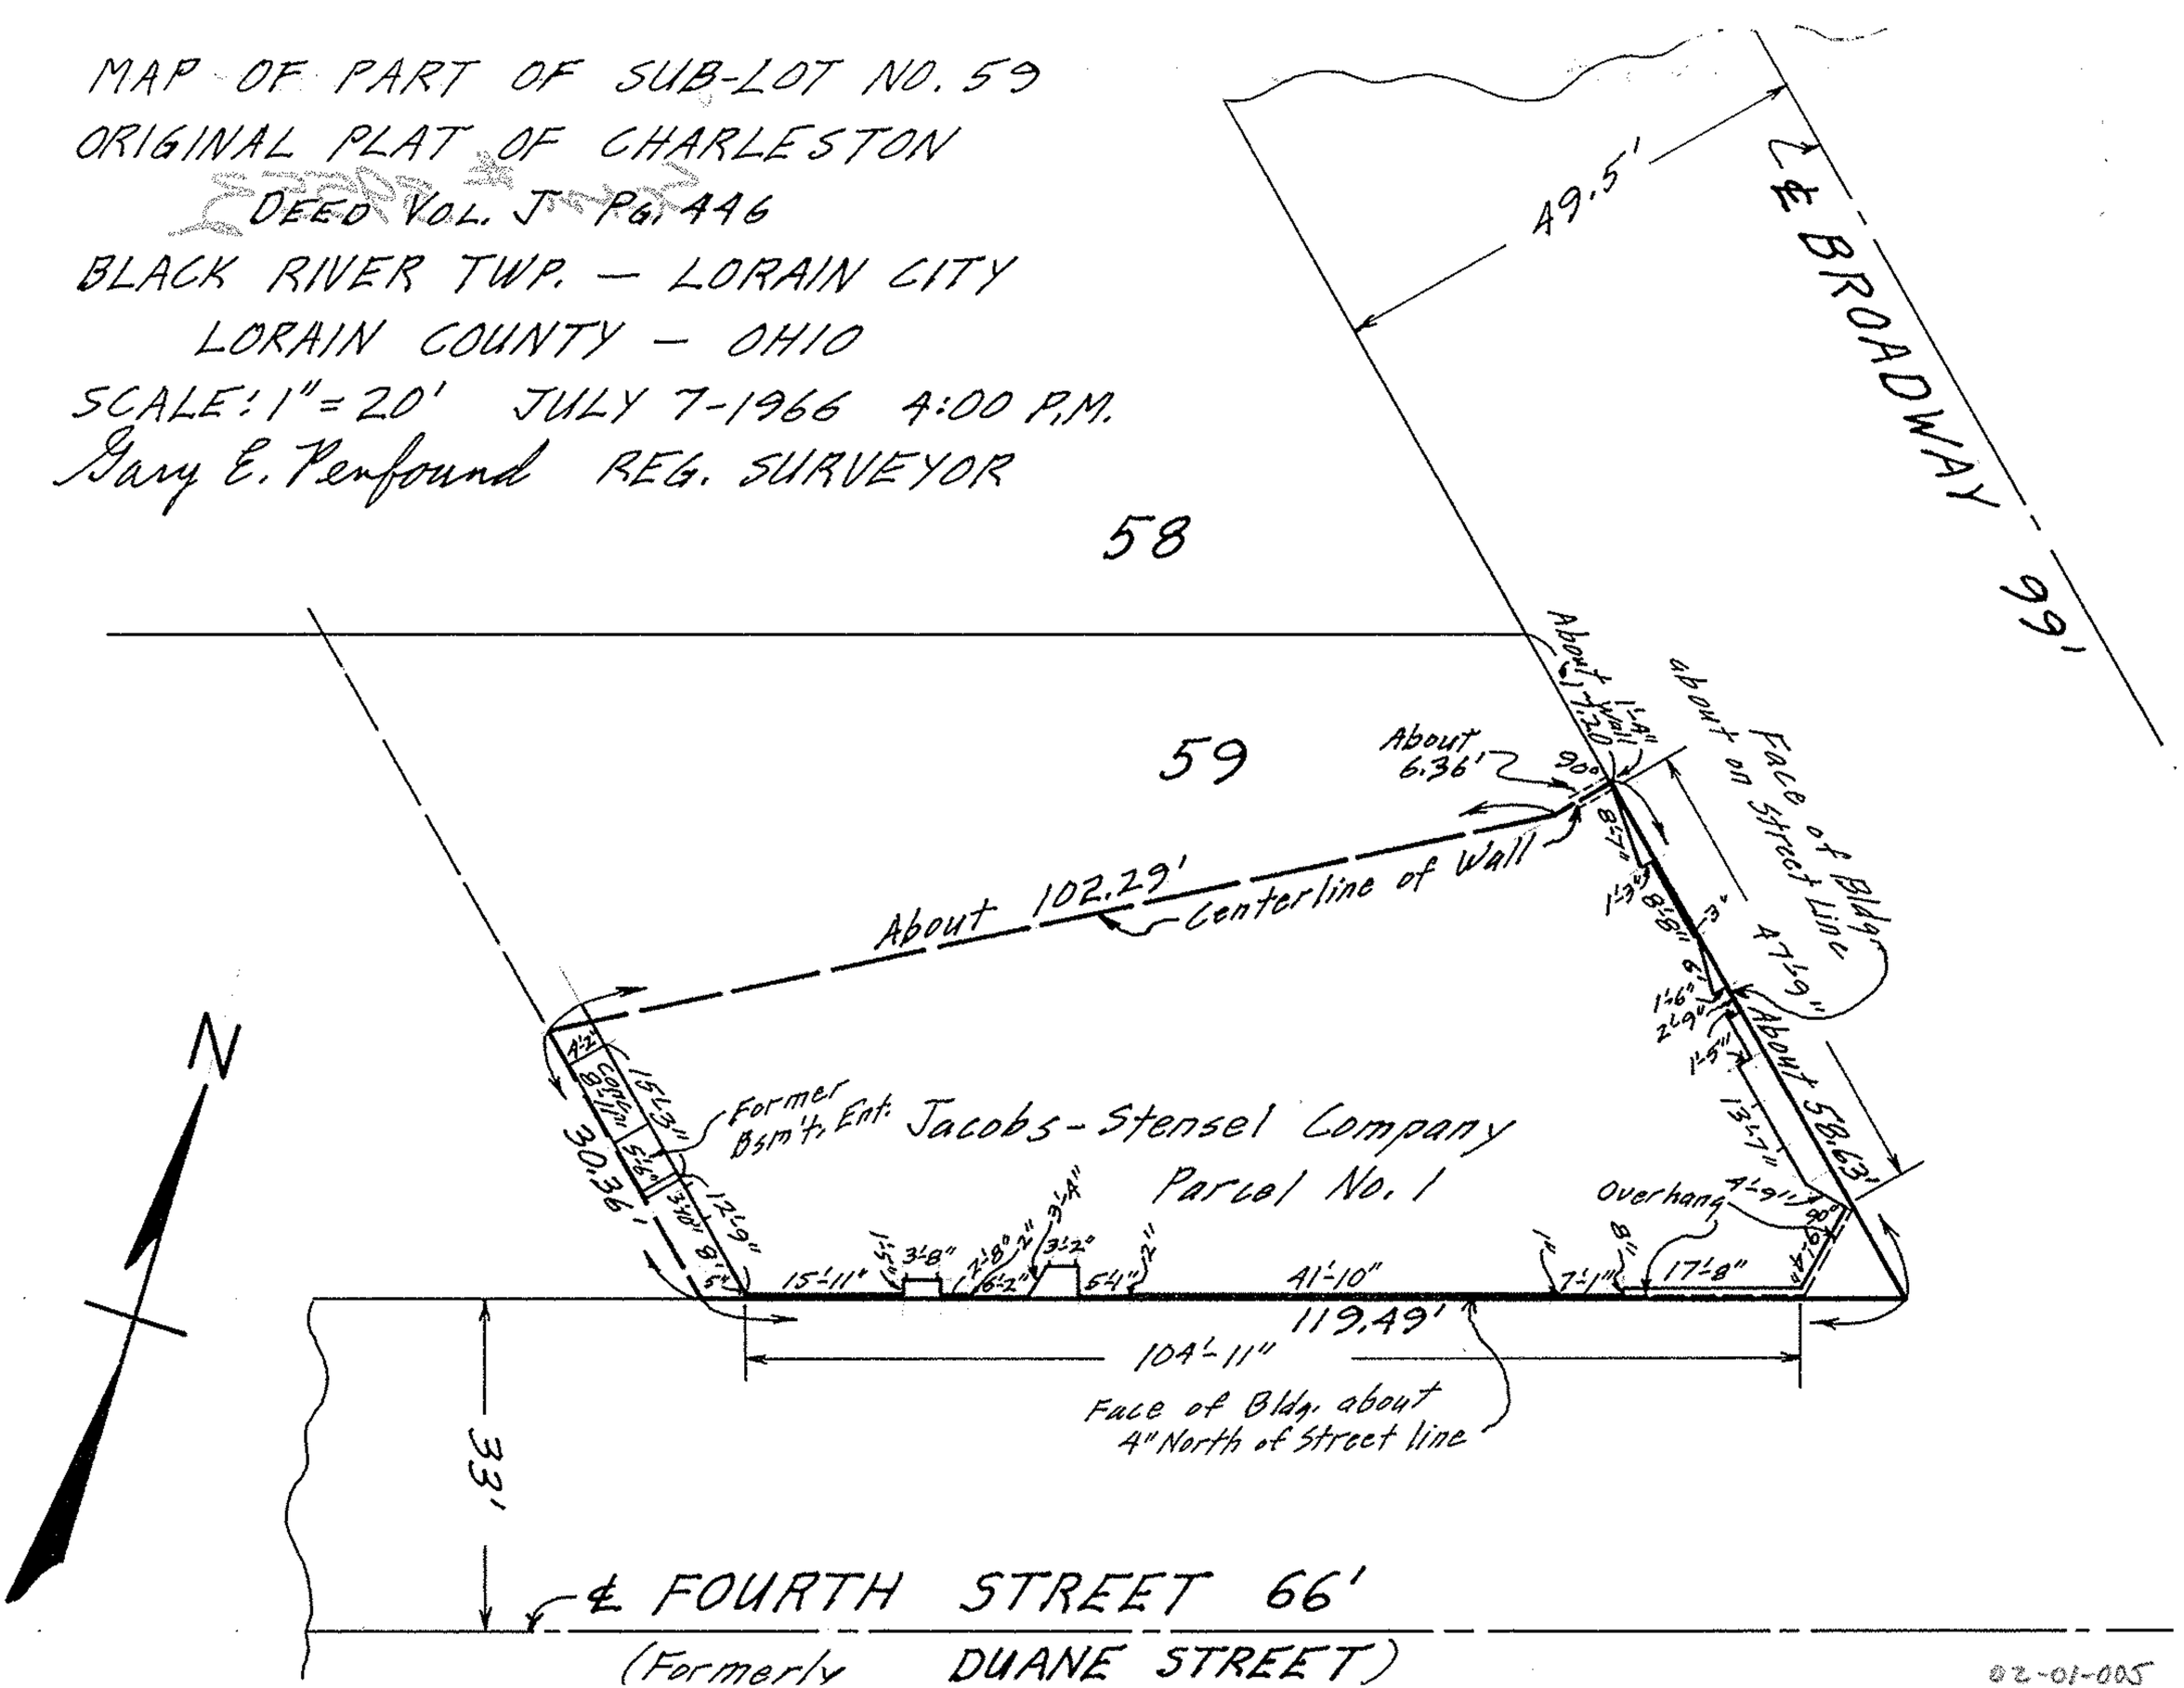

02-01-005