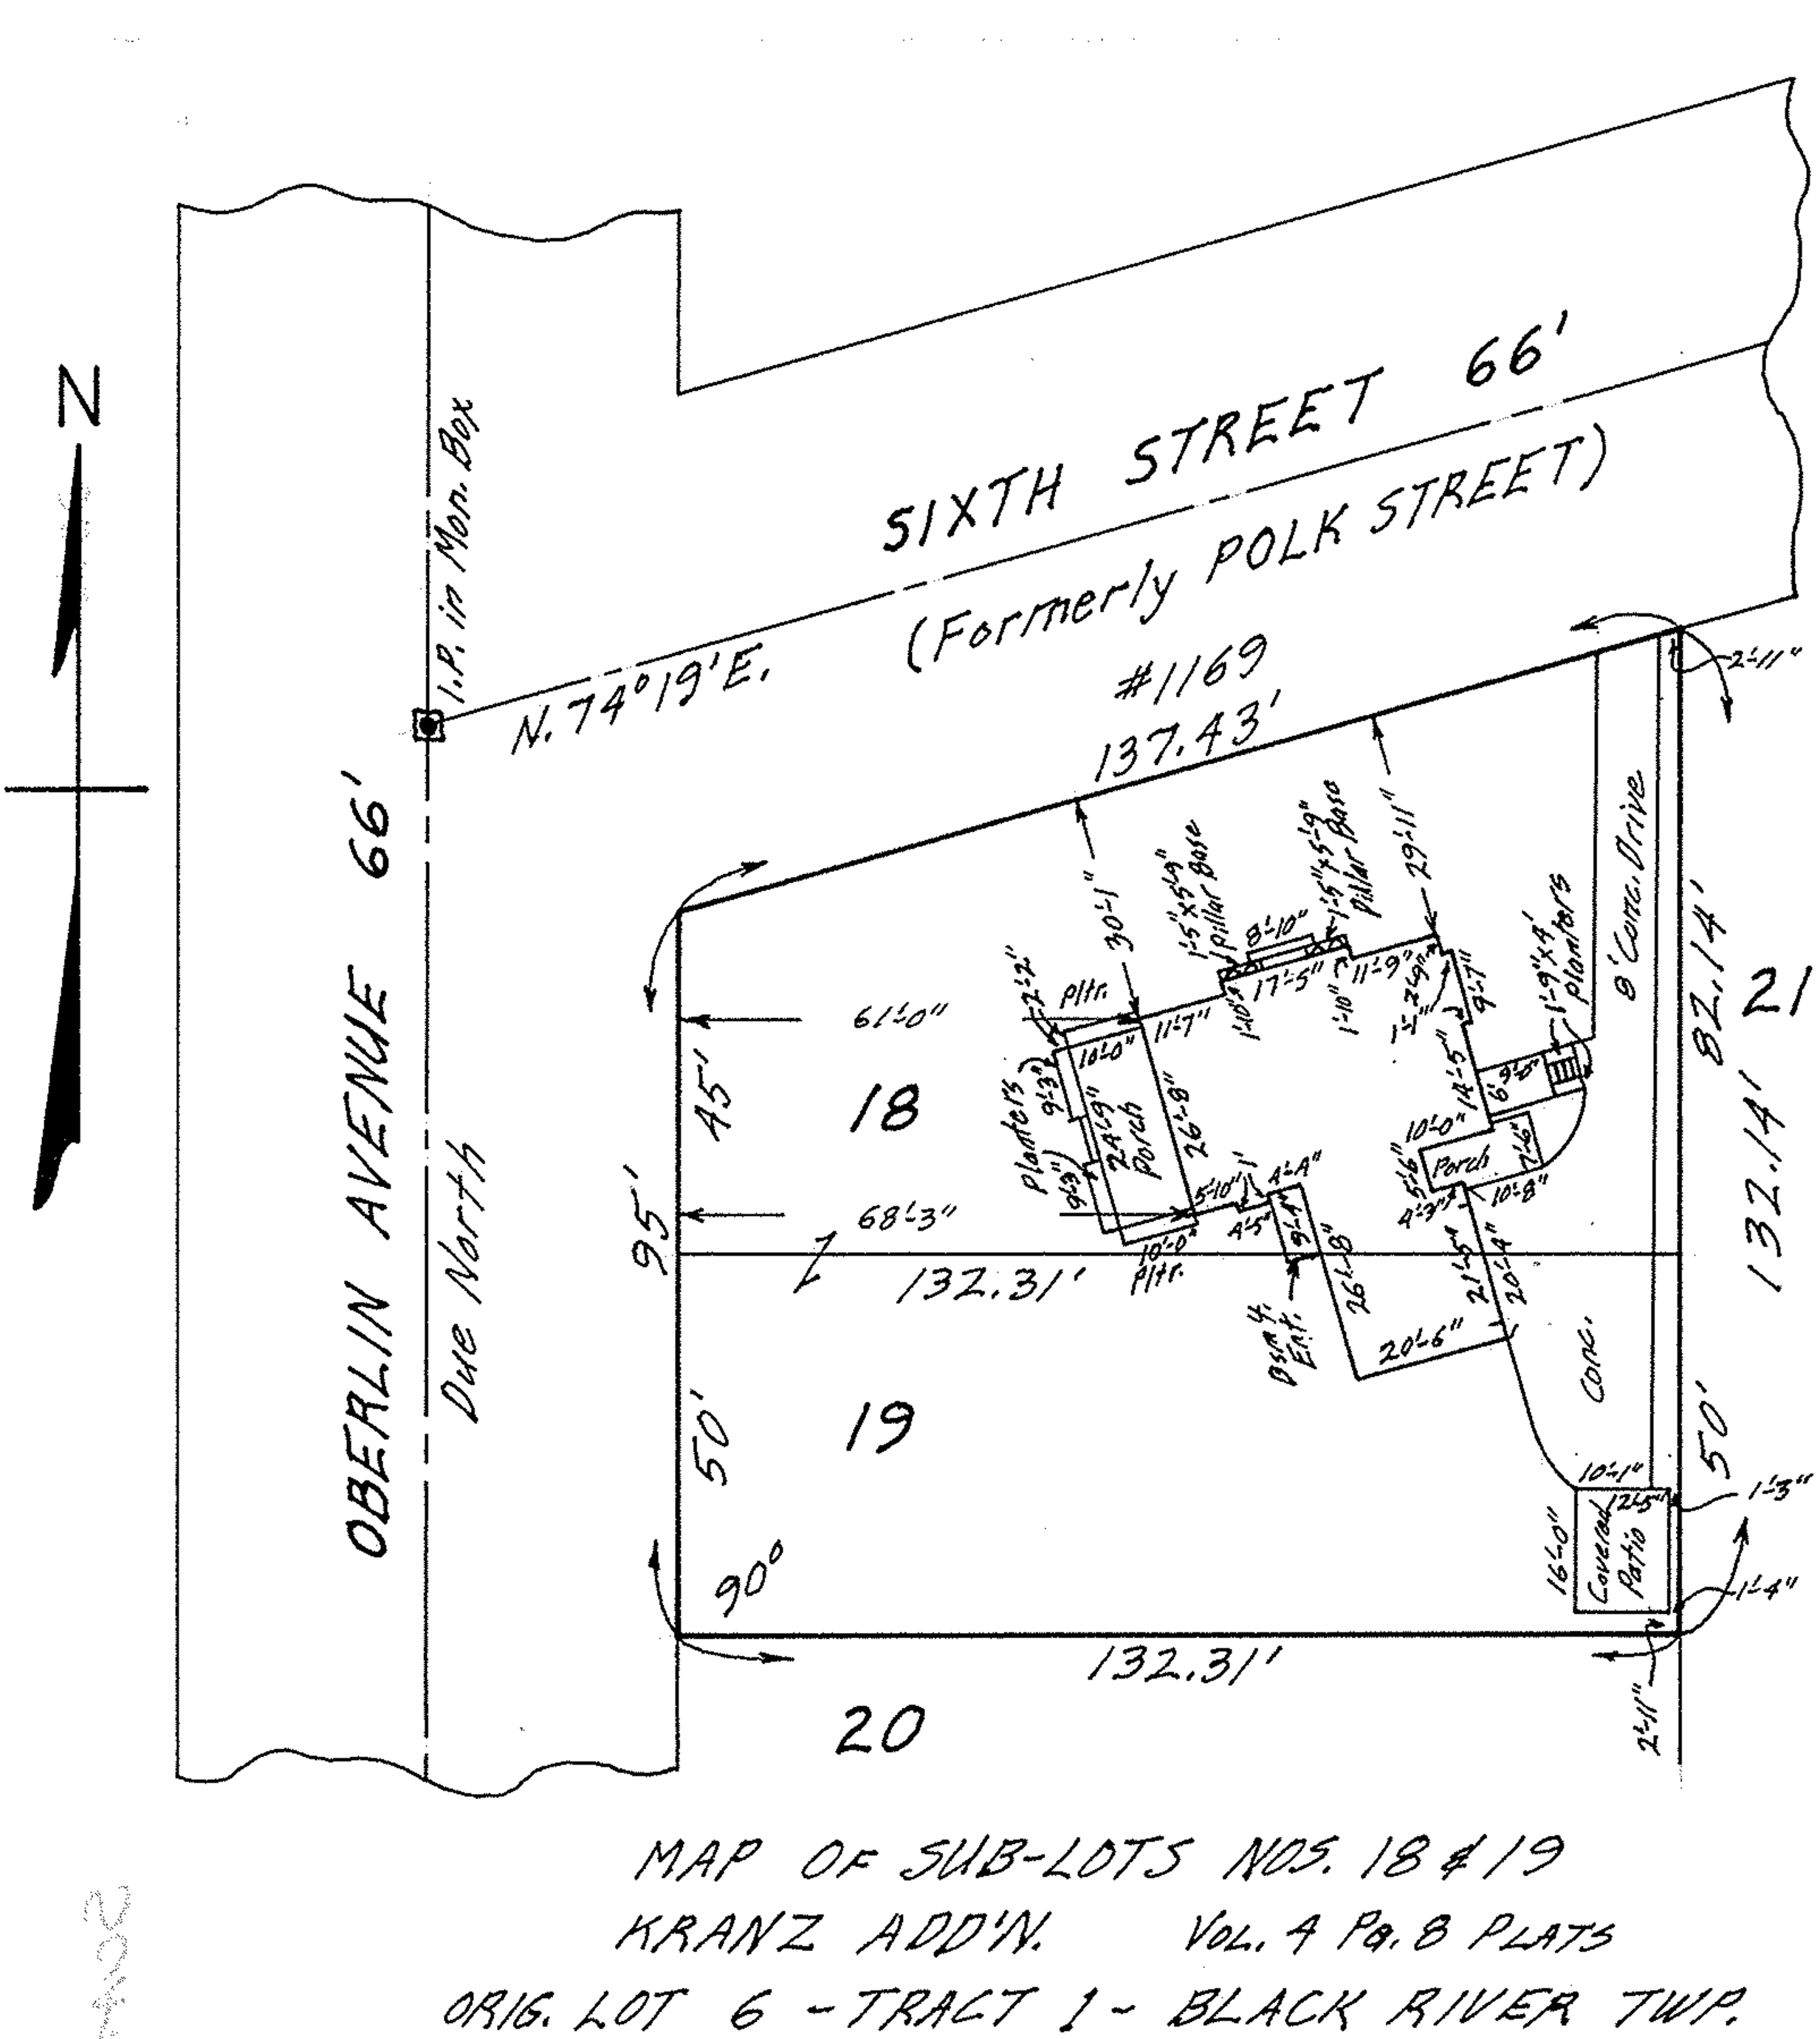

MAP OF SUB-LOTS NOS. 18 & 19
KRANZ ADD'N. VOL. 4 PG. 8 PLATS
ORIG. LOT 6 - TRACT 1 - BLACK RIVER TWP.
LORAIN CITY - LORAIN COUNTY - OHIO
SCALE: 1" = 30' APRIL 25-1969 3:00 P.M.
Gary E. Penfound REG. SURVEYOR

Mary Ross Ventura - Parcel No. 1

02-01-006