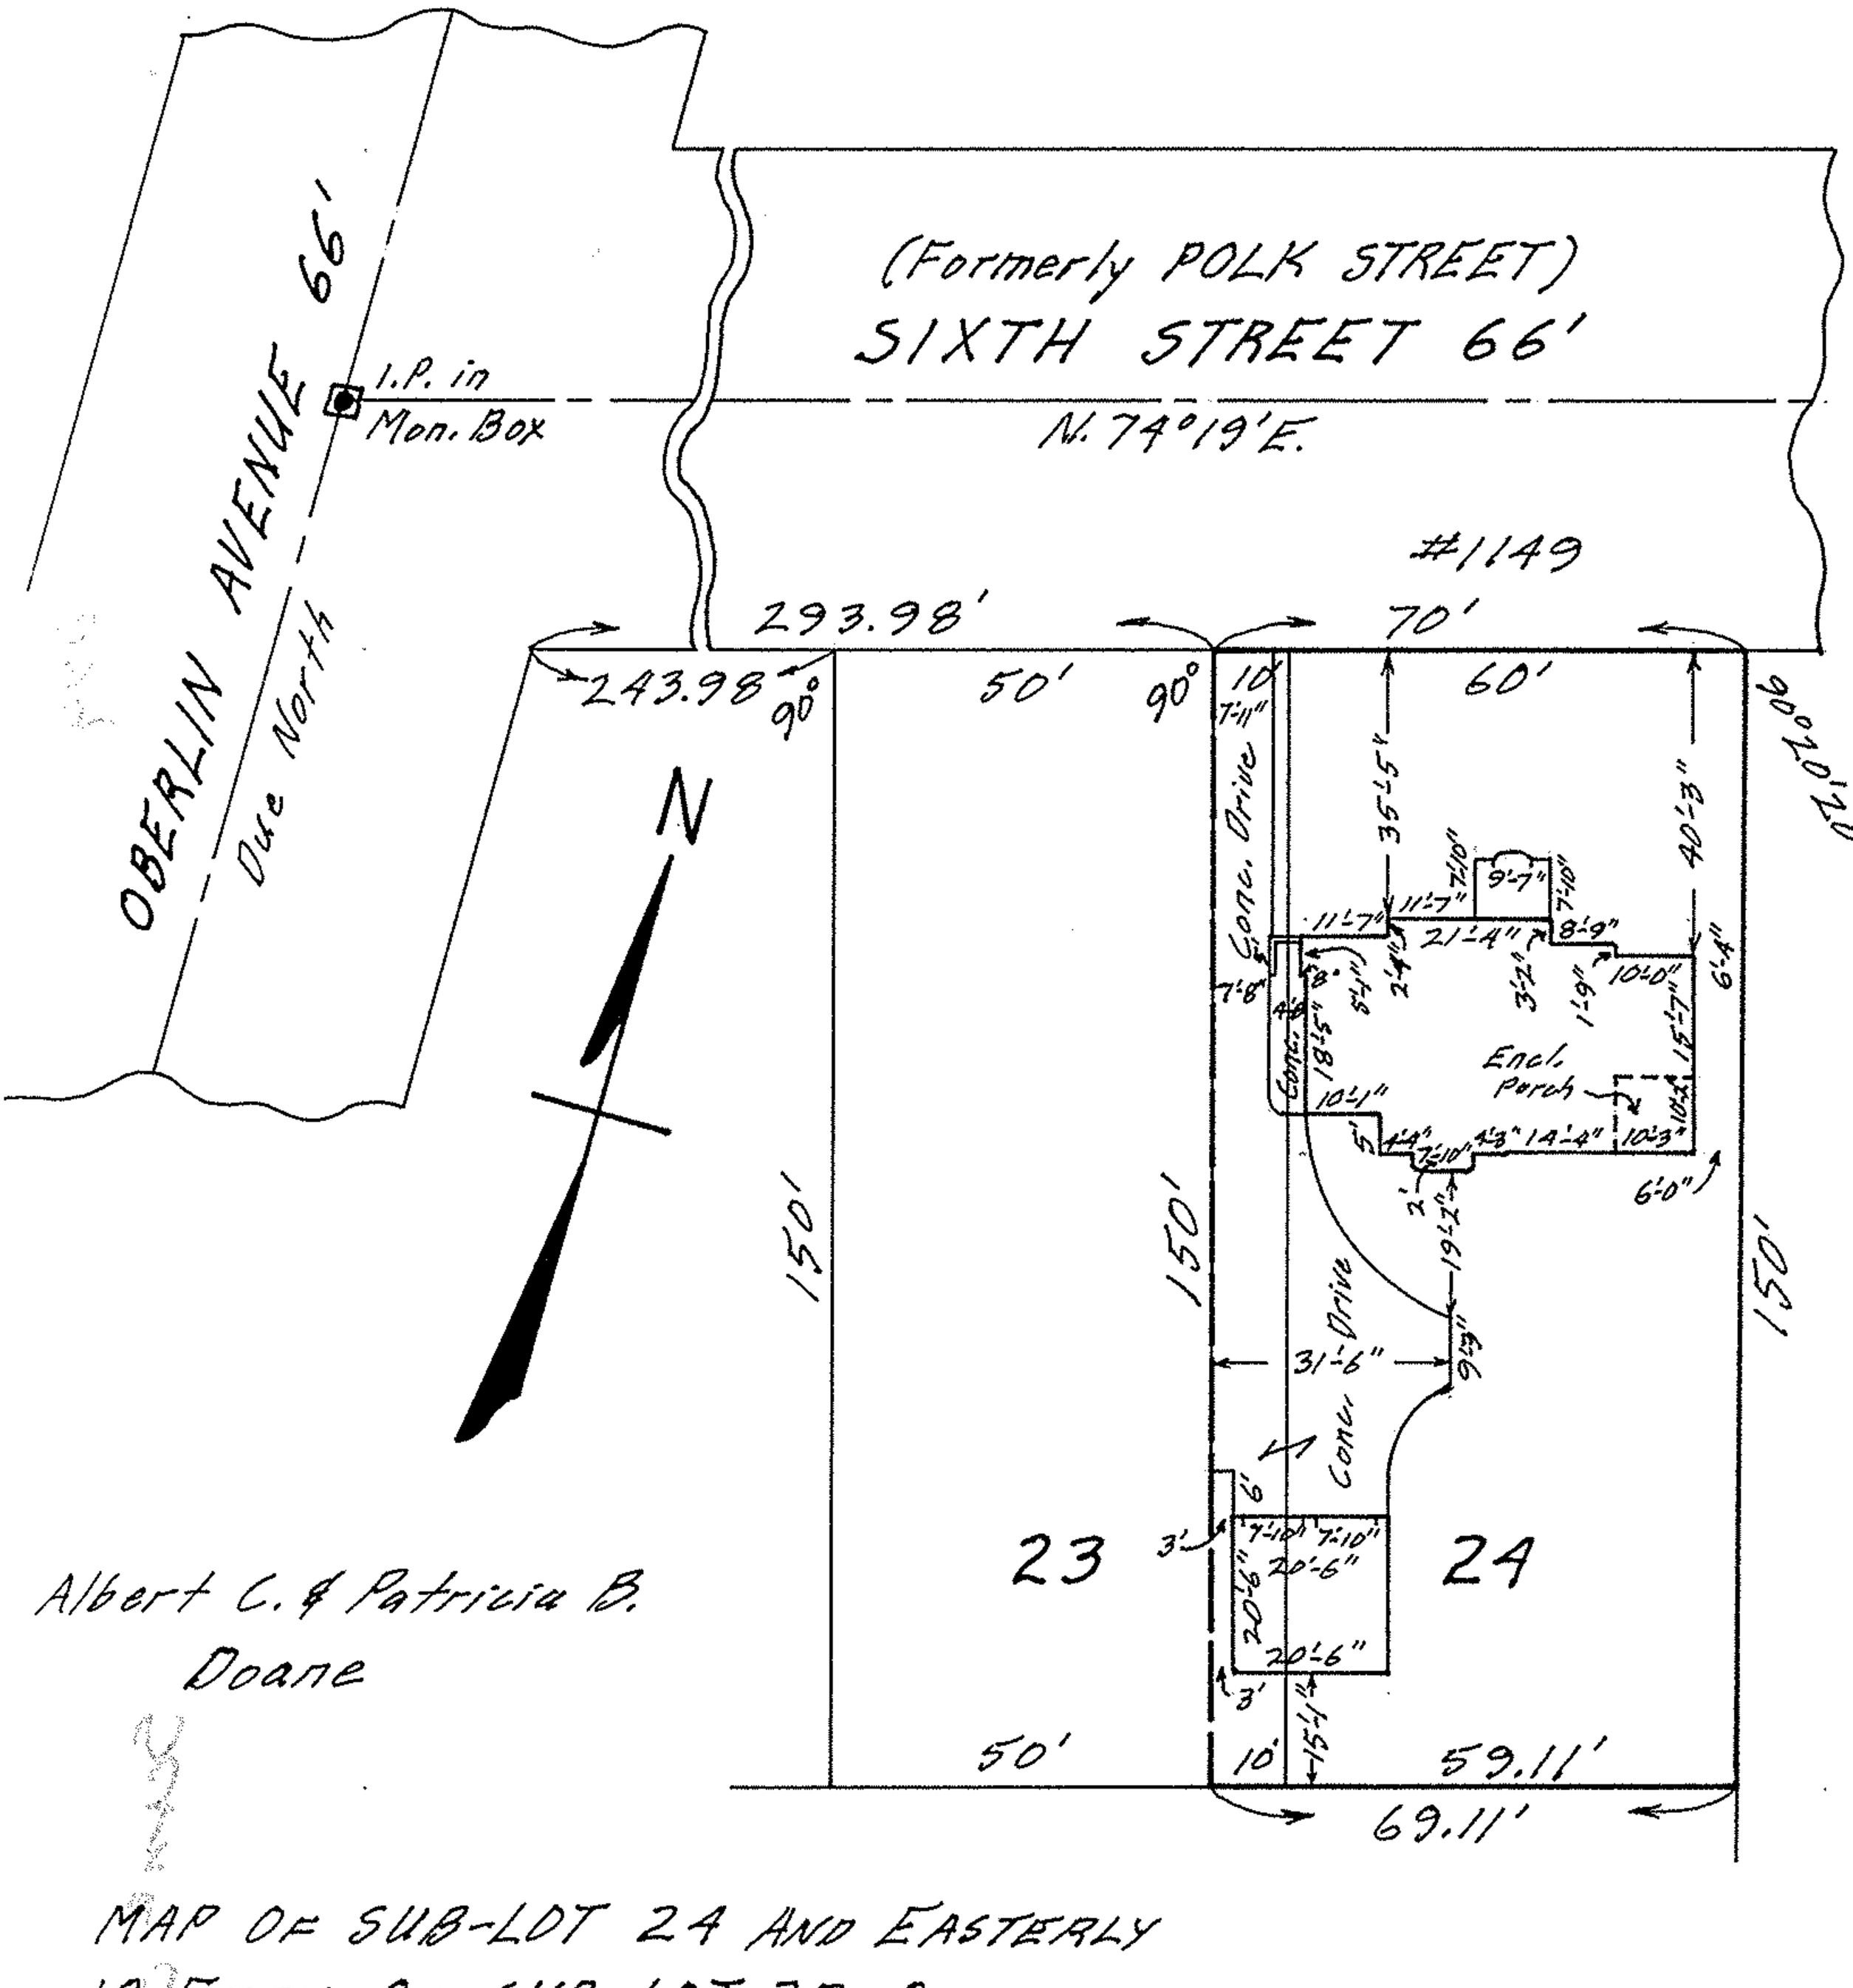

Albert C. & Patricia B. Doane

MAP OF SUB-LOT 24 AND EASTERLY 10 FEET OF SUB-LOT 23 OF CONRAD KRANZ ADD'N. - VOL. 4 PG. 8 O.L. 6 - TR. 1 - BLACK RIVER TWP. LORAIN CITY - LORAIN COUNTY - OHIO

SCALE: 1"=30' MAY 21-1968 4:00 P.M.

Gary E. Penfound REG. SURVEYOR

02-01-006 PL