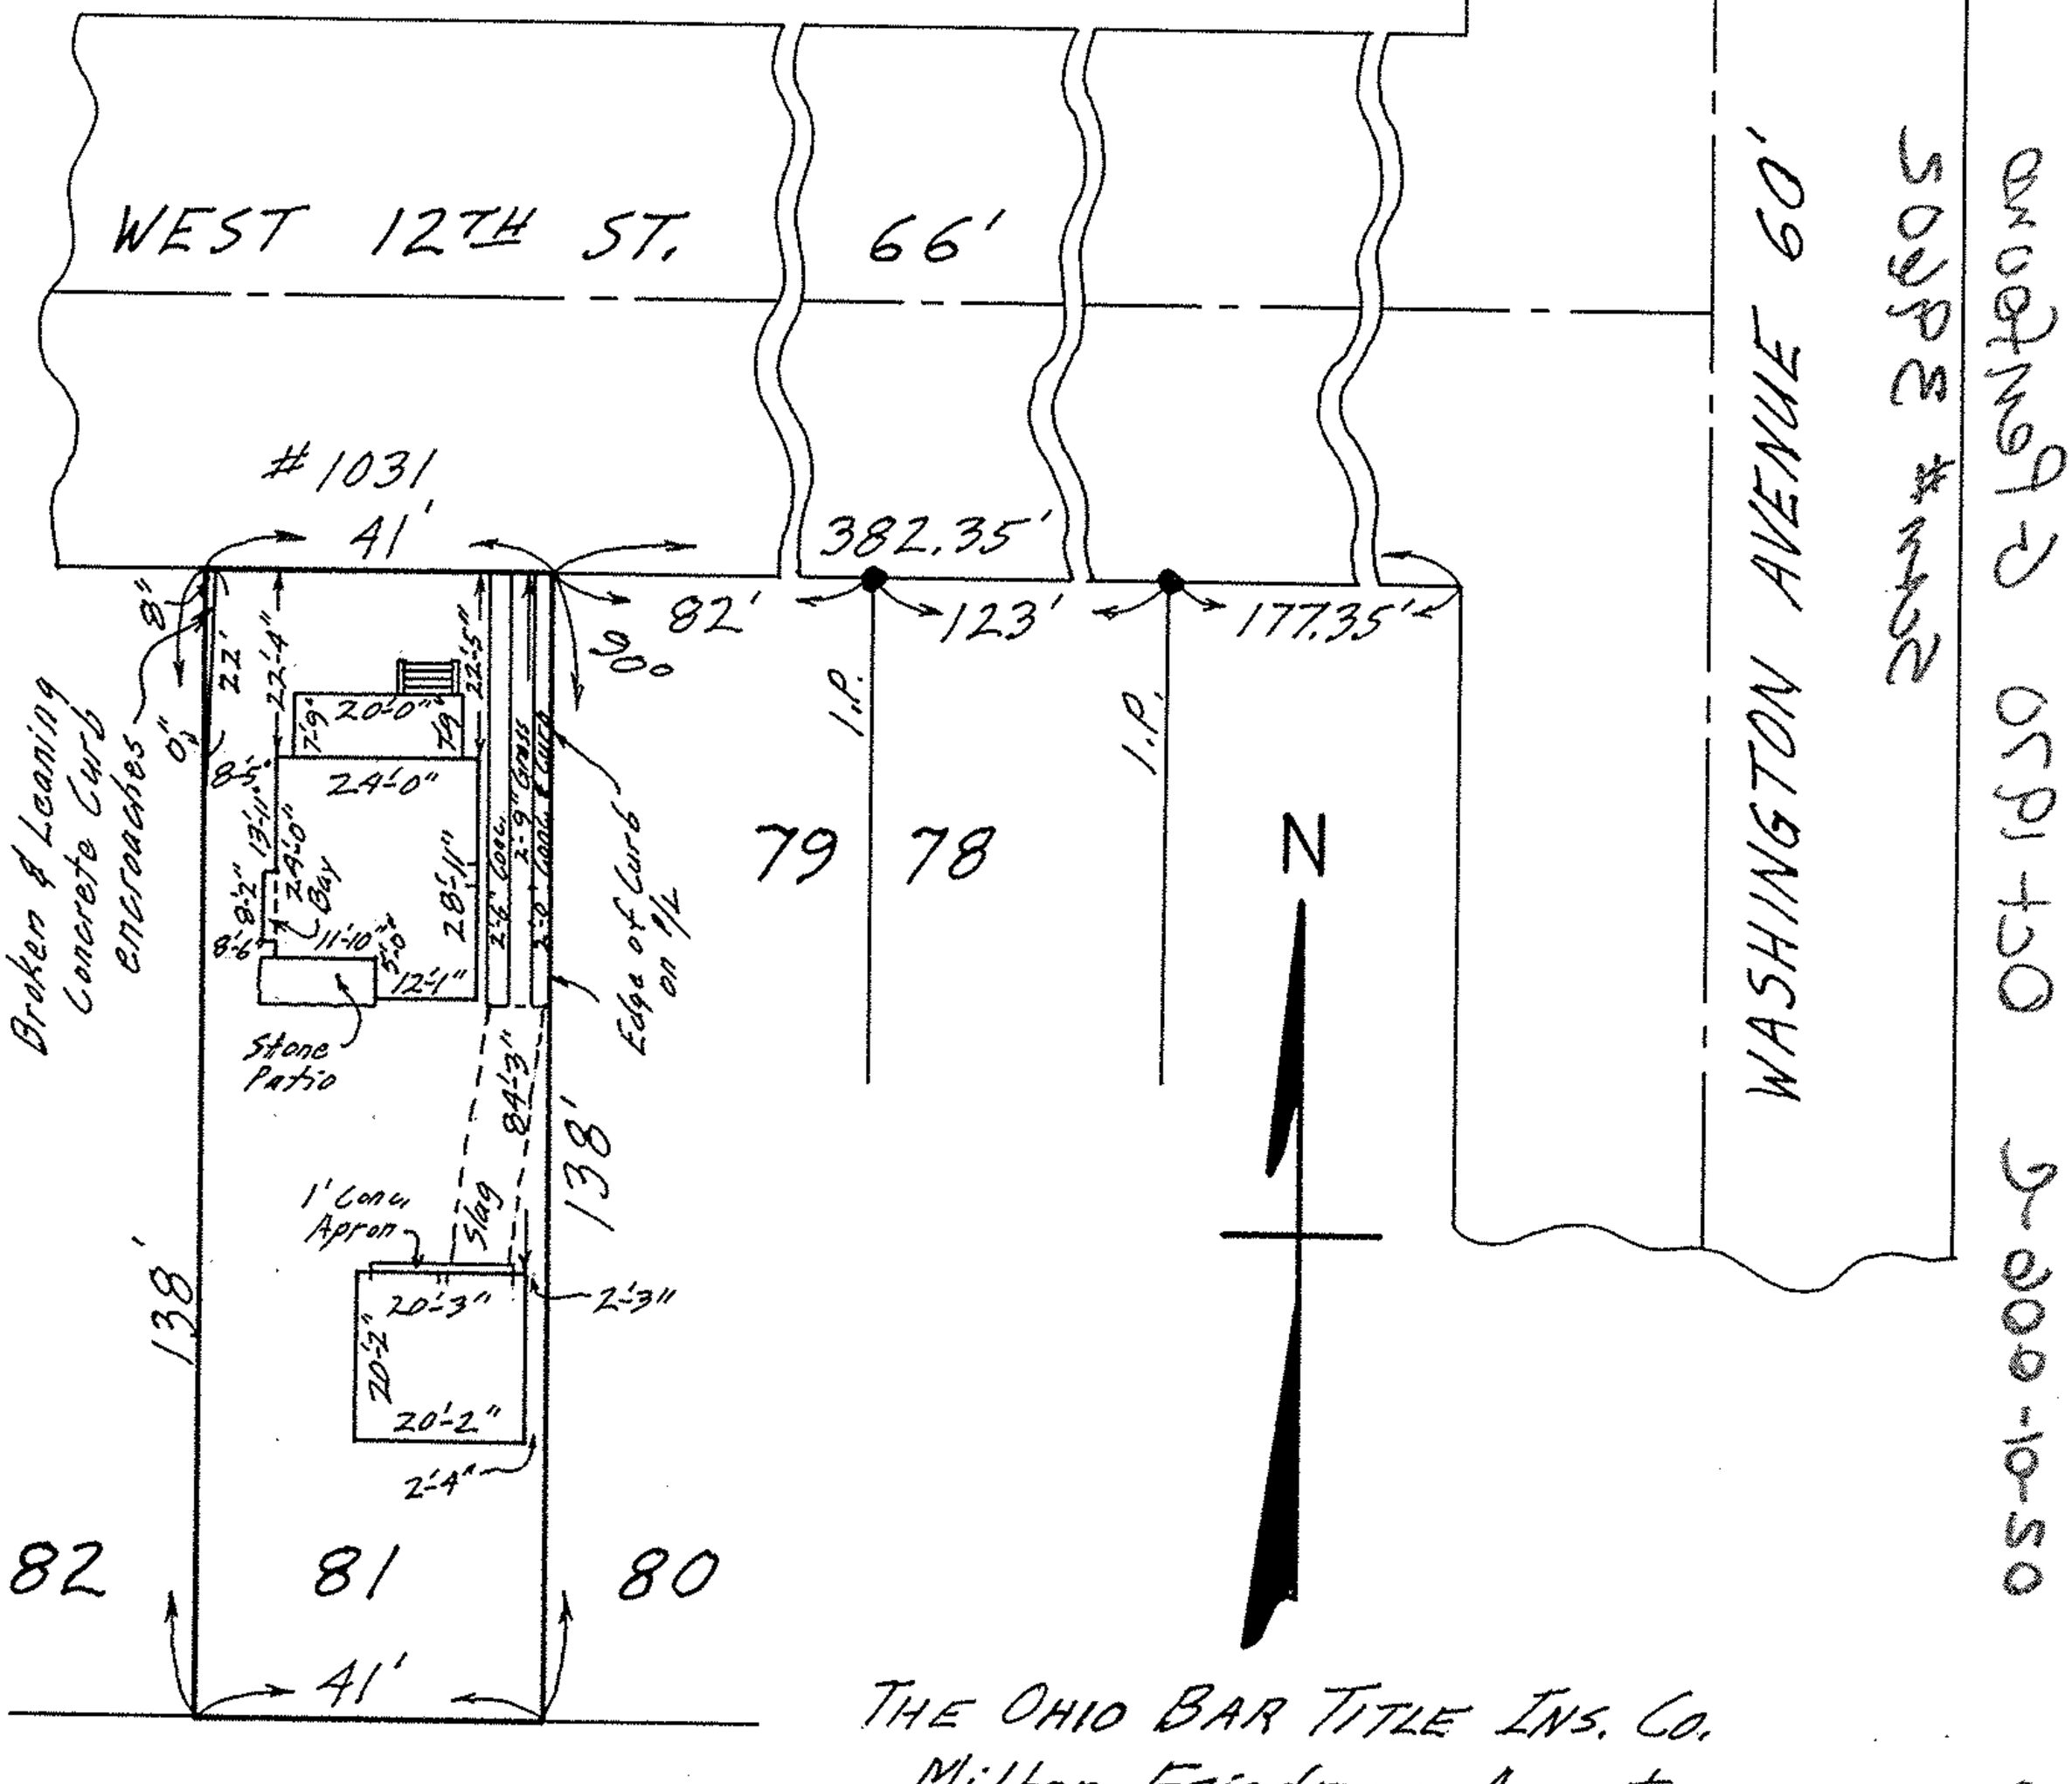

THE OHIO BAR TITLE INS. CO.

Milton Friedman, Agent

Sofo to Kulick

MAP OF SUB-LOT NO. 81

E. R. PERKIN'S TRUSTEES ADD'N. VOL. 7 PG. 21

ORIG. LOT 6 - TRACT NO. 1 - BLACK RIVER TWP.

LORAIN CITY - LORAIN COUNTY - OHIO

SCALE: 1"=30' OCT. 1 - 1970 4:30 P.M.

NOTE: The only encroachment on this property is broken & leaning concrete curb as shown.

Gary E. Penfound REG. SURVEYOR NO. 4457

Oct-19-70 9:00 A.M. 70-1-1-81