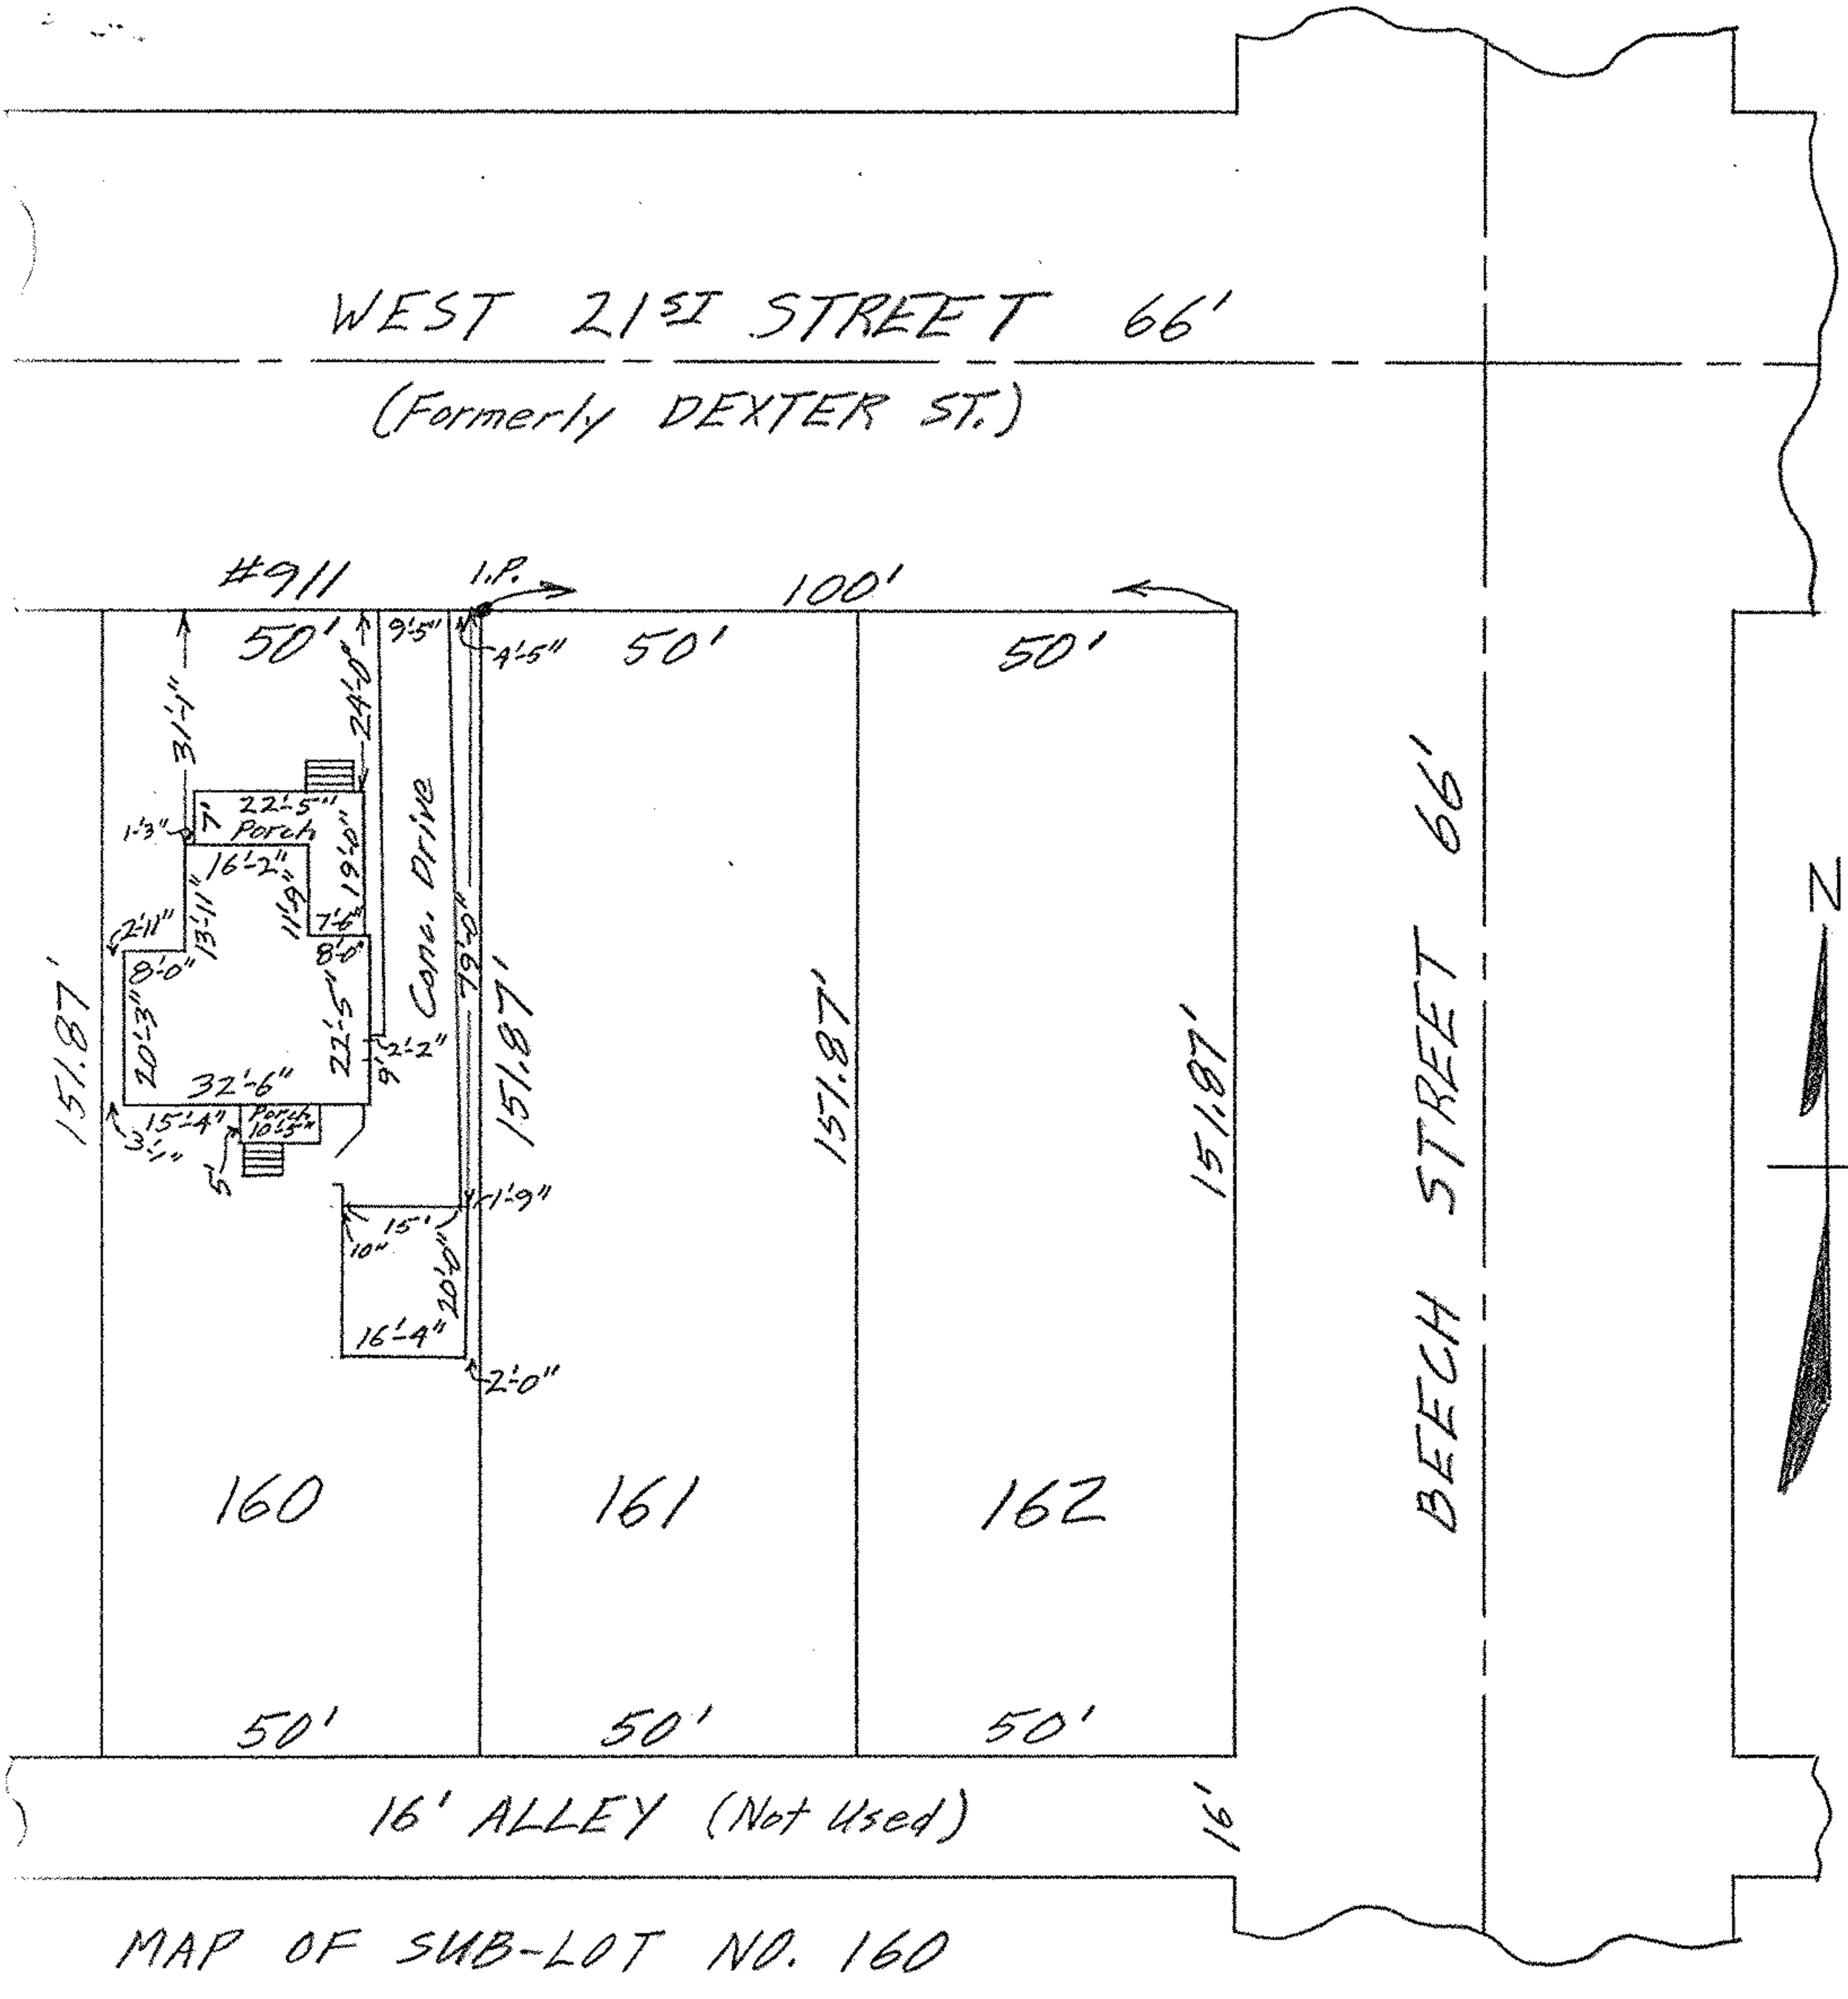


MAP OF SUB-LOT NO. 160

STANG'S SECOND SUB/N. VOL. 4 PG. 18
LOT 6 - TRACT 1 - BLACK RIVER TWP.
LORAIN CITY - LORAIN COUNTY - OHIO
SCALE: 1"=30' APRIL 1 - 1964 7:00 P.M.
Gary E. Benfound REG. SURVEYOR
Paul W. & Judy M. Glover W.W.
02-01-006