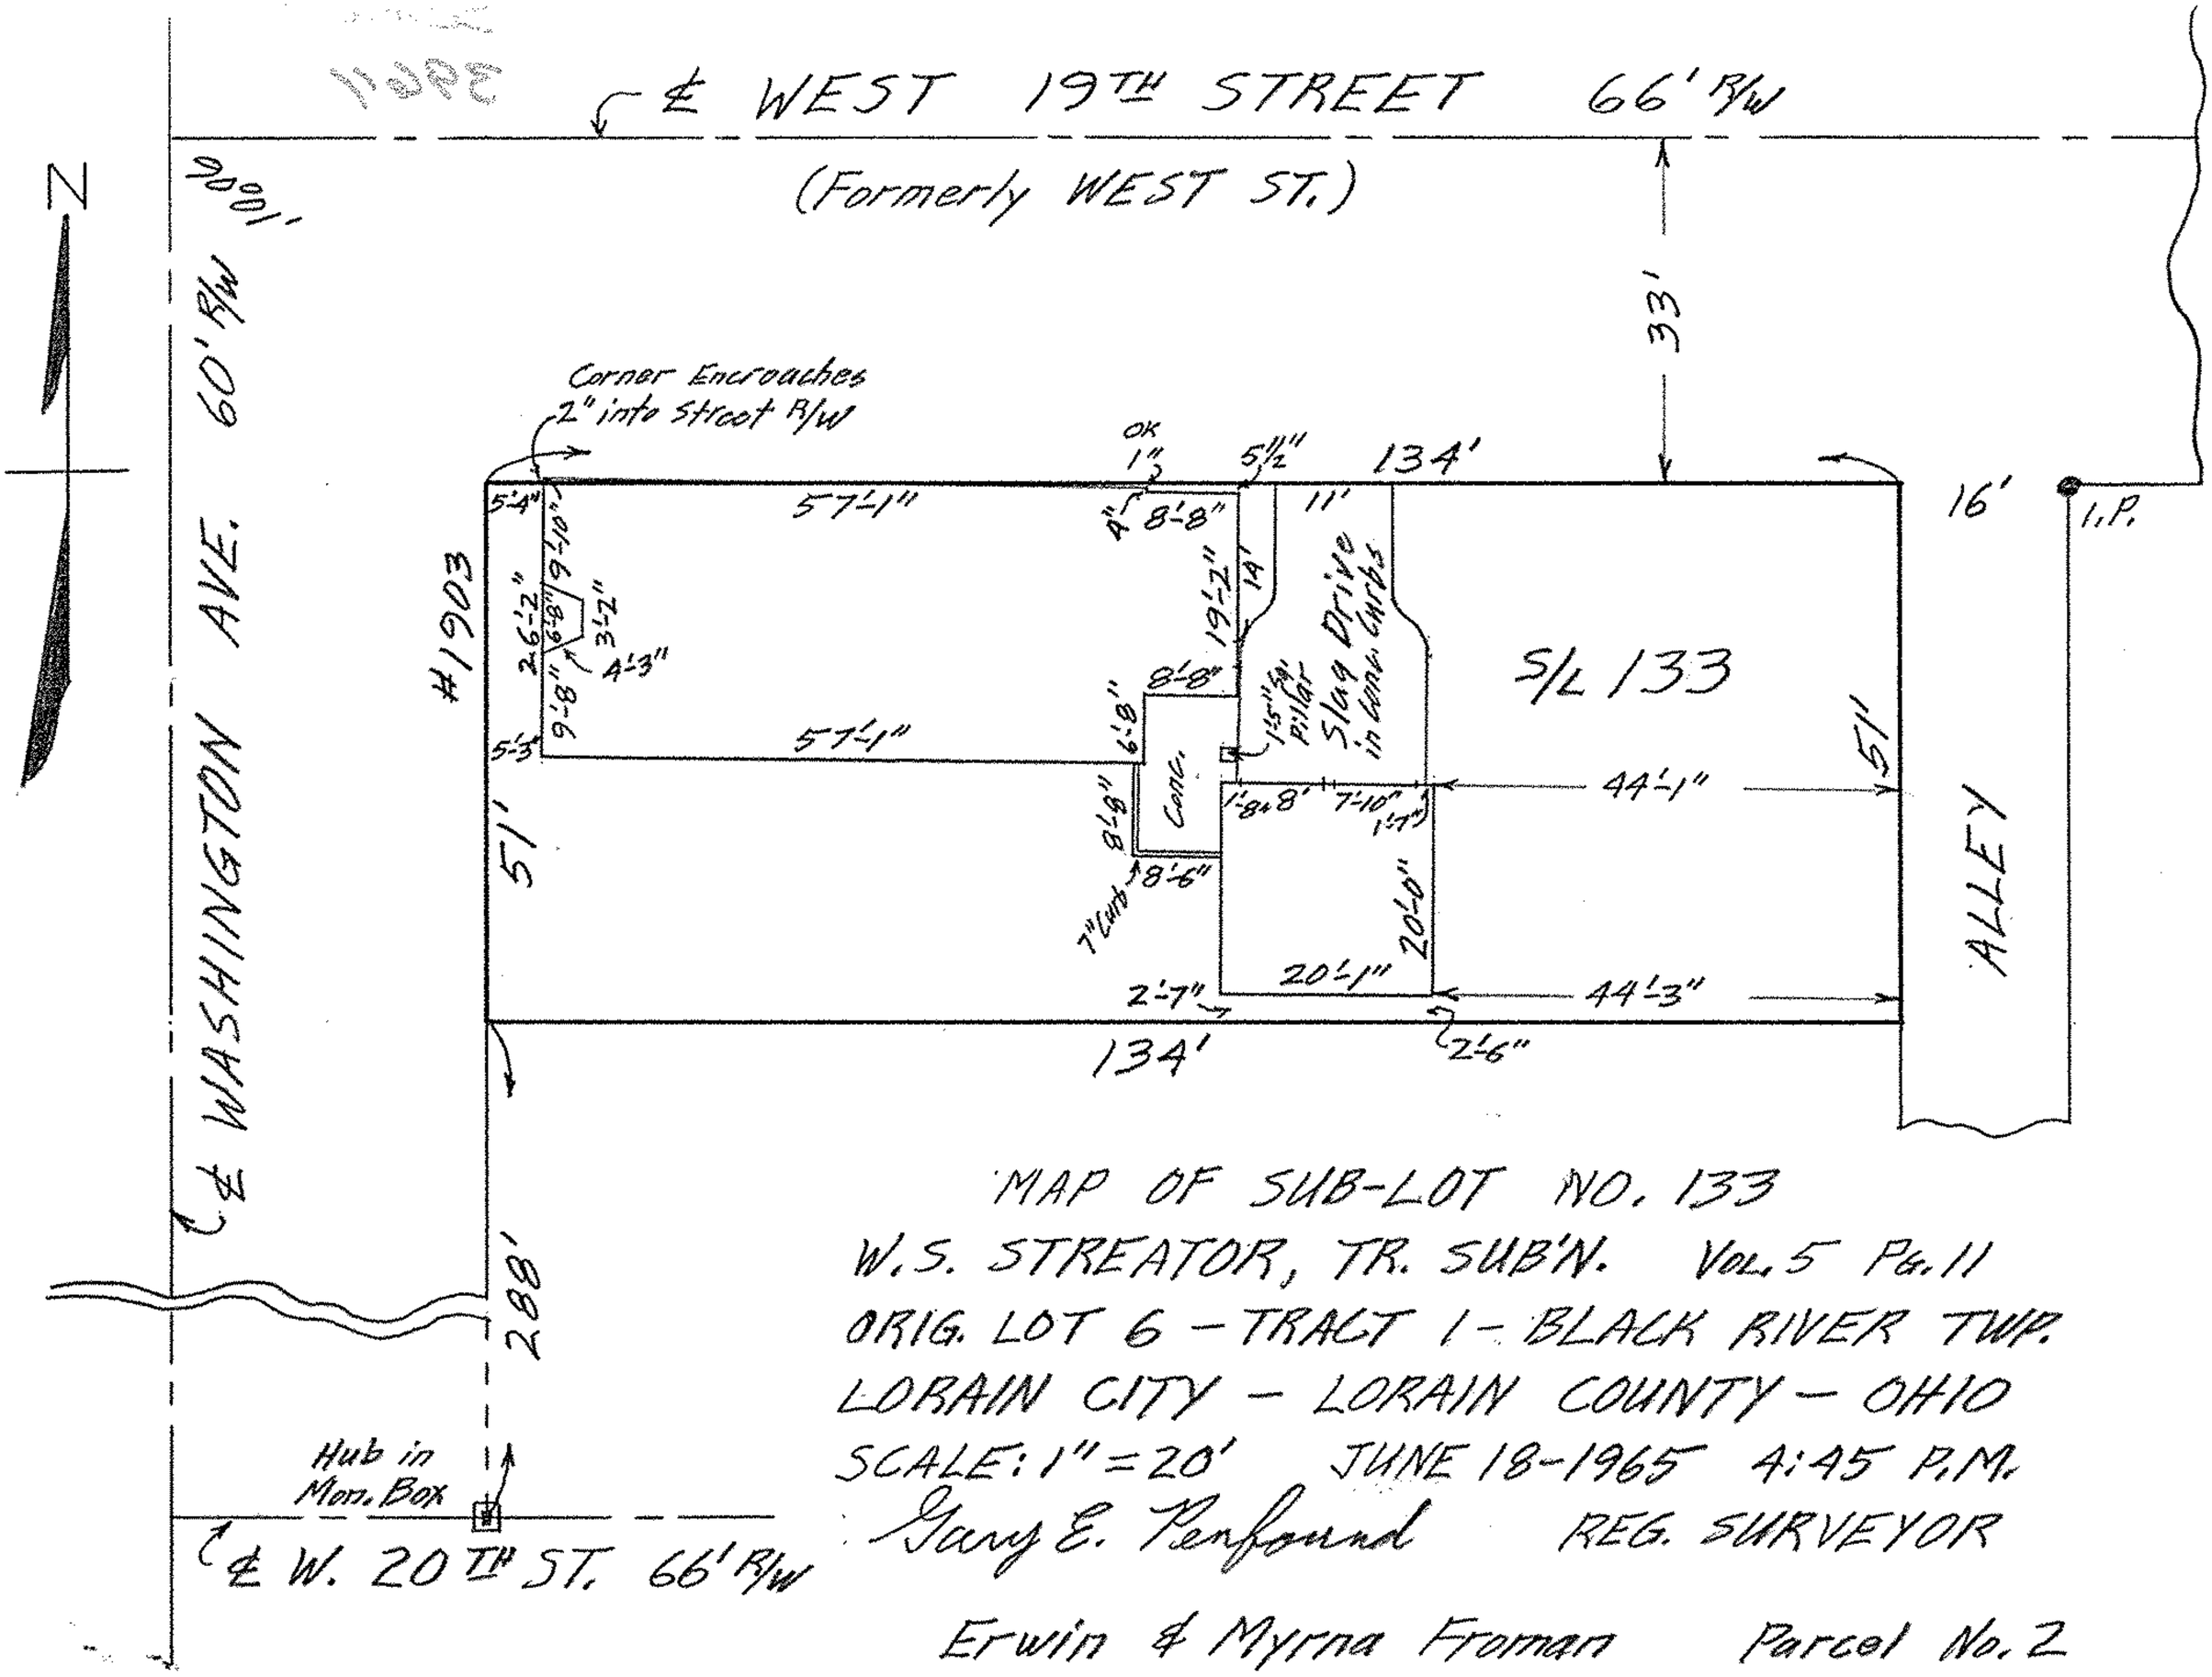

MAP OF SUB-LOT NO. 133

W.S. STREATOR, TR. SUB'N. VOL. 5 PG. 11

ORIG. LOT 6 – TRACT 1 – BLACK RIVER TWP.

LORAIN CITY – LORAIN COUNTY – OHIO

SCALE: 1" = 20' JUNE 18-1965 4:45 P.M.

Gary E. Penfound REG. SURVEYOR

Erwin & Myrna Froman Parcel No. 2

02-01-006 BH