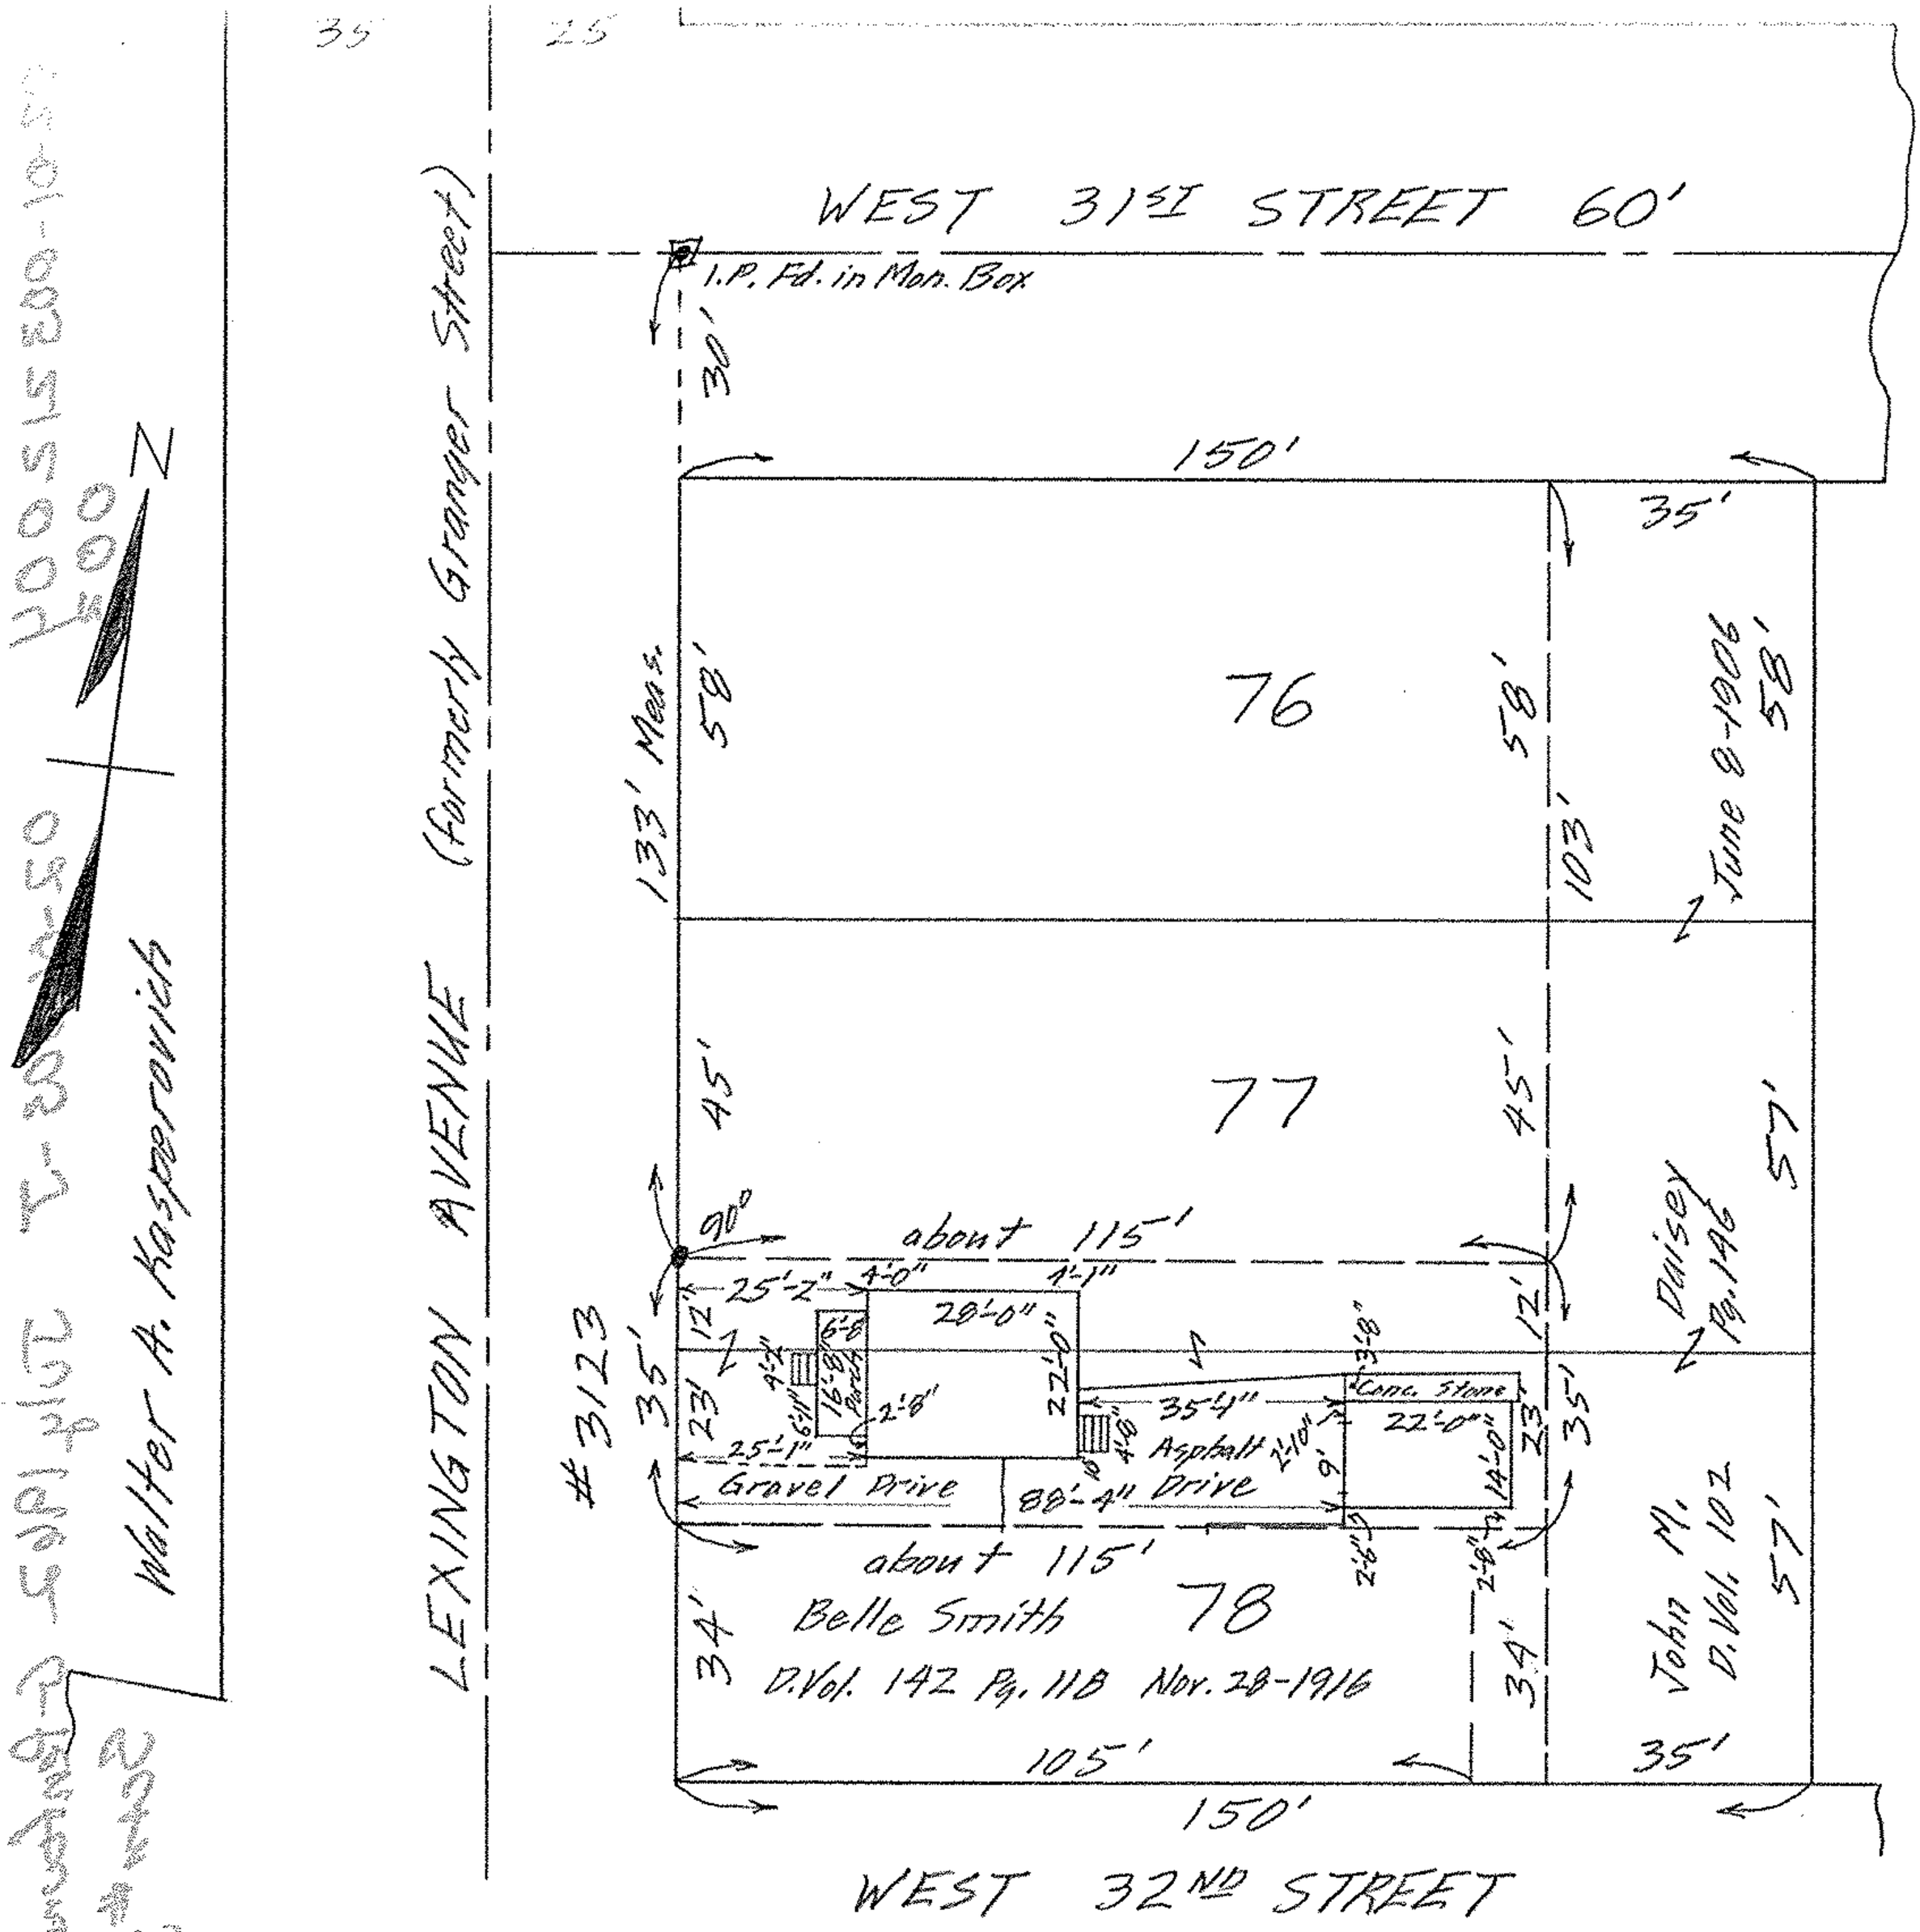

MAP OF PART OF SUB-LOTS NOS. 77 AND 78
DANIELS AND BRAUN'S ADD'N. VOL. 4 PG. 41
O.L. 3 - TRACT NO. 1 - BLACK RIVER TWP.
LORAIN CITY - LORAIN COUNTY - OHIO
SCALE: 1" = 30' JULY 31-1962 9:30 A.M.

Gary E. Benfound REG. SURVEYOR BH
62-01-003