SURVEY

OF PART OF

ORIGINAL RIDGEVILLE TWP. LOT NO. 28

CITY OF N. RIDGEVILLE COUNTY OF LORAIN

STATE OF OHIO

APPROVED LORAIN CO. EAP DEPT
DATE: 5-18-07
07-00-028-103-015
PAGE: 7-00-028-D
BY JHatfield
OT-02374
N.O. 2374

DATE: JAN 2007
SCALE: 1" = 50

STATE OF OHIO
DANE A. HAPONEK
S-8211
REGISTERED PROFESSIONAL SURVEYOR

PREPARED BY:
HAPONEK AND ASSOC.
SURVEYORS AND ENGINEERS

PREPARED FOR:
CITY OF NORTH RIDGEVILLE
7307 AVON BELDEN RD
AND
ELIZABETH JANE NOLL
38490 DETROIT RD
AVON, OHIO

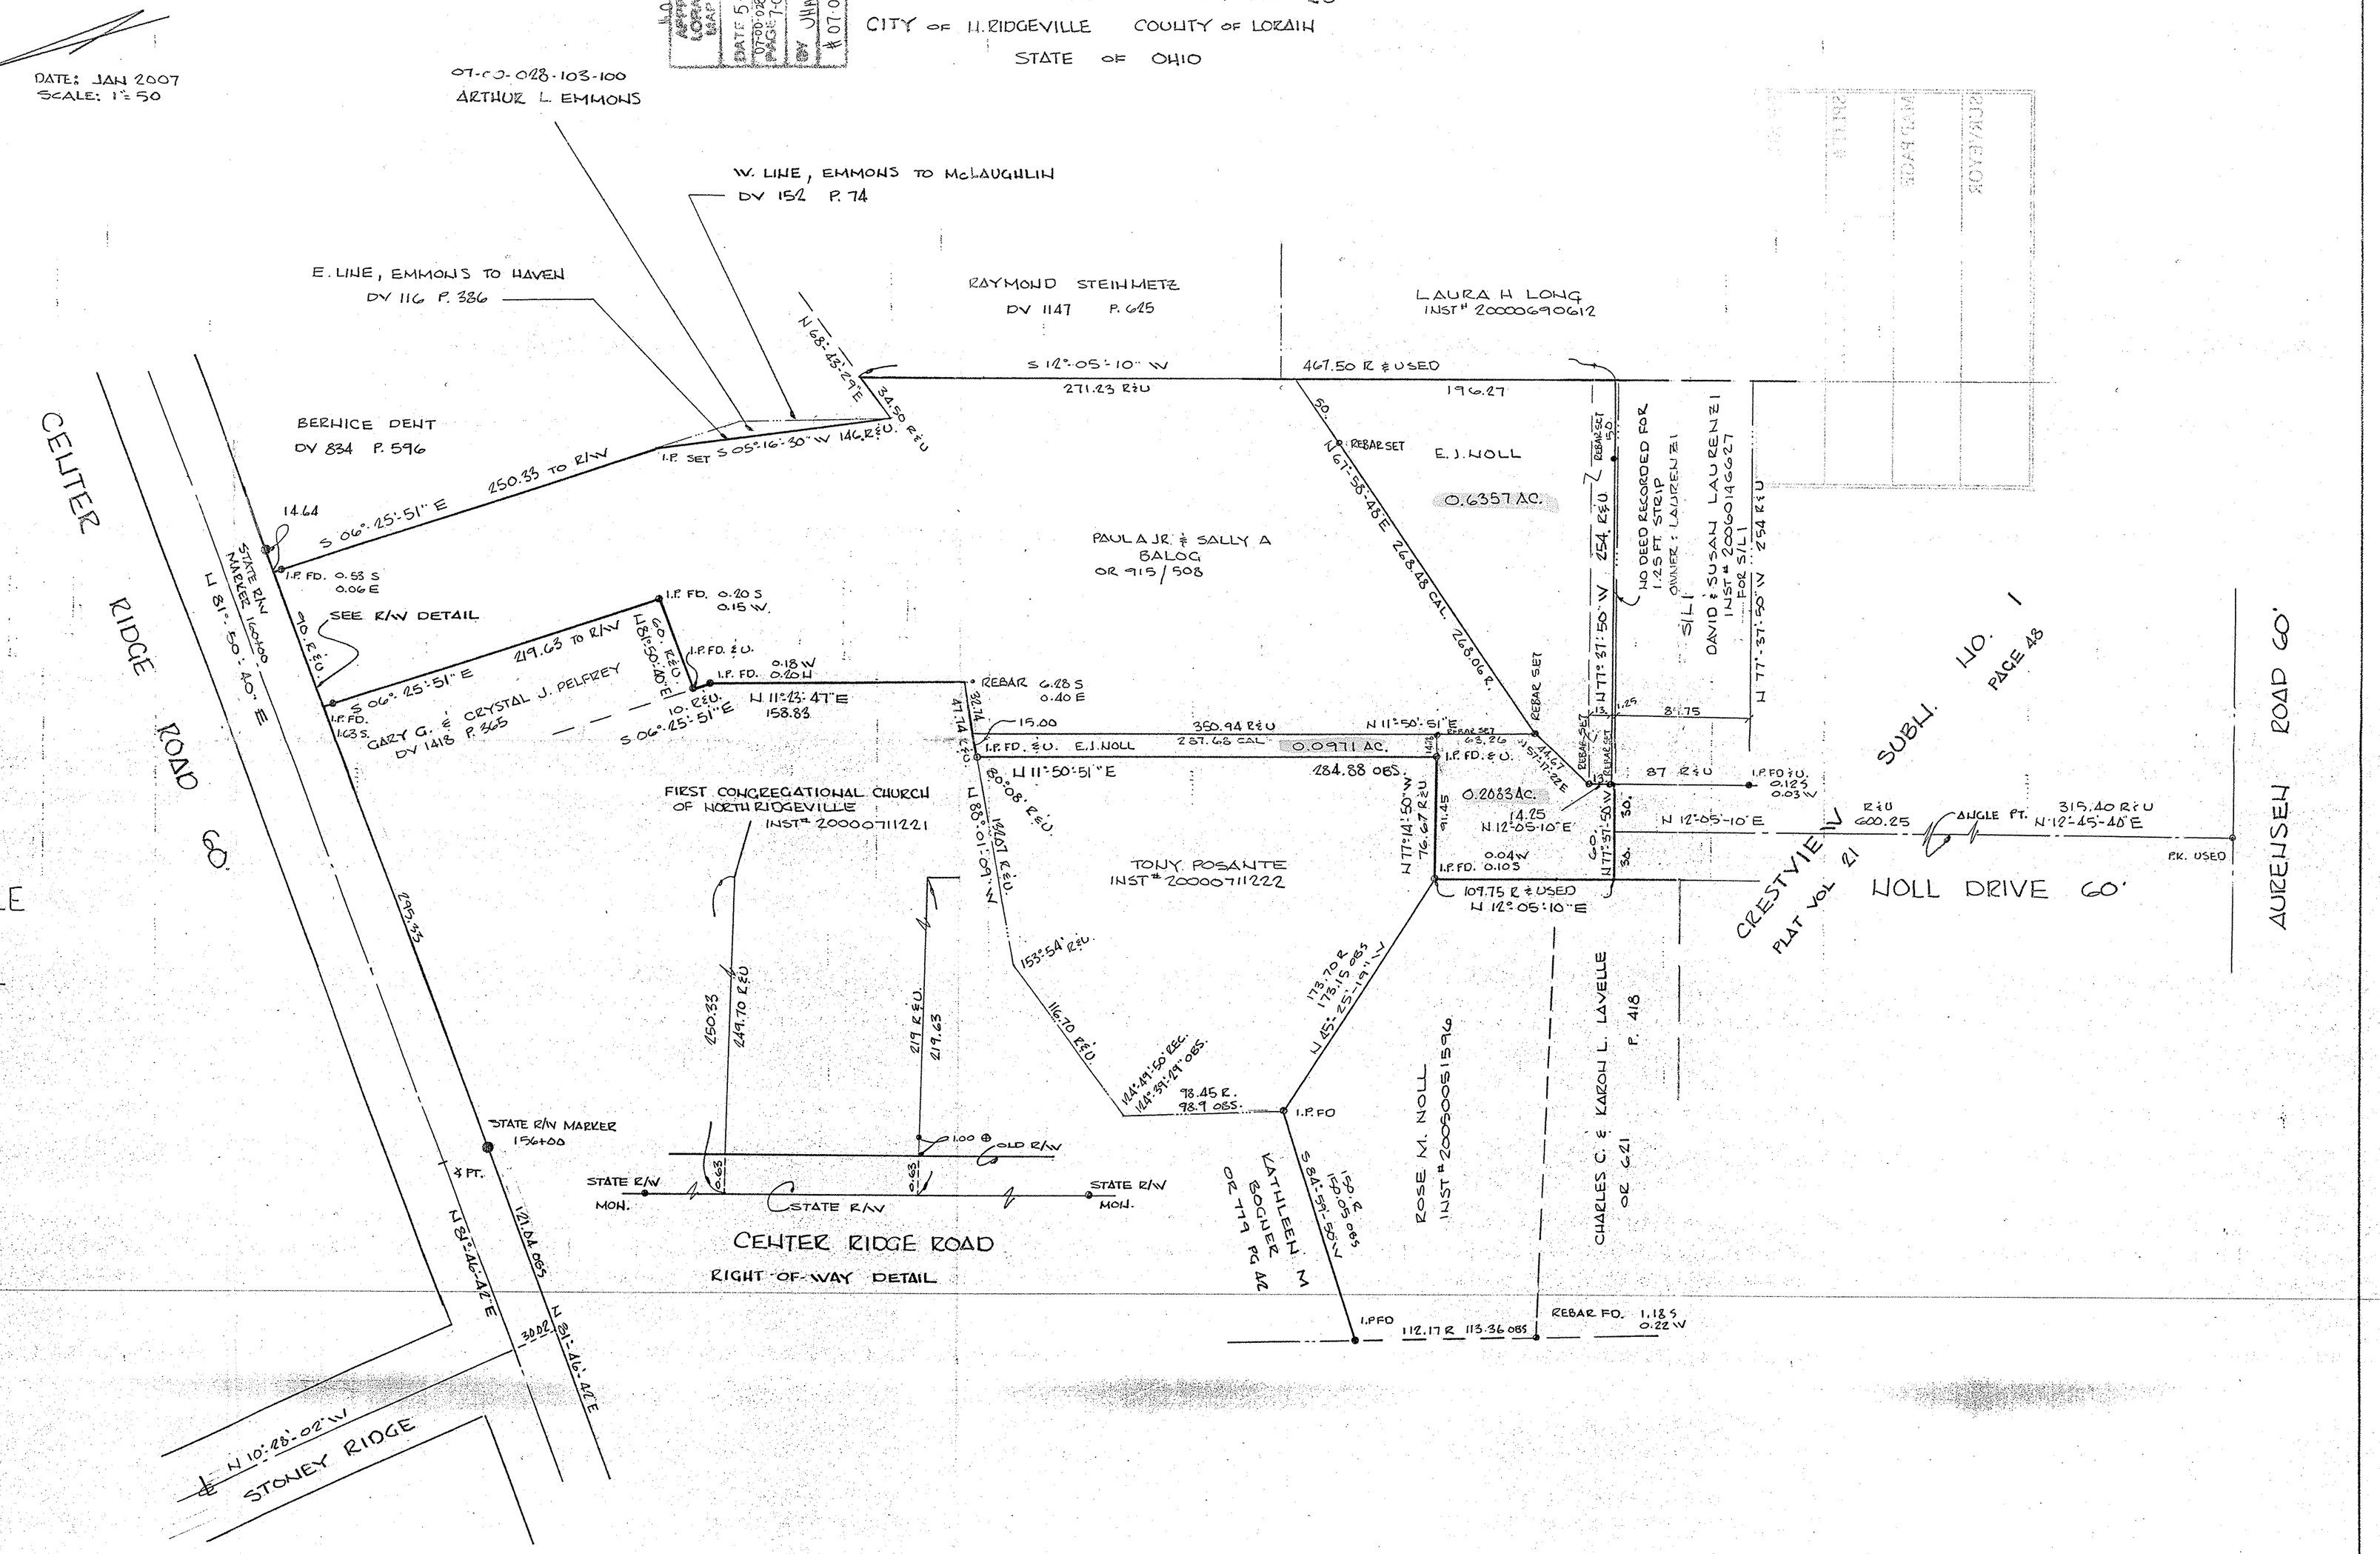

94-57