DATE: MARCH 2001
SCALE: 1" = 100'

SURVEY

OF PART OF

ORIGINAL CAMDEN TOWNSHIP

LOTS № 18 & 23

TRACT II

TOWNSHIP OF CAMDEN COUNTY OF LORAIN

STATE OF OHIO

PREPARED FOR:

JOE & JUDY YAKUNOVICH
14970 BAIRD RD.
OBERLIN, OH

AND

GILLEN CONCRETE & EXCAVATING INC.
750 SUGAR LA.
ELYRIA, OH.

PREPARED BY

DANE A. HAPONEK
5444 STONEY RIDGE RD.
N RIDGEVILLE, OH.

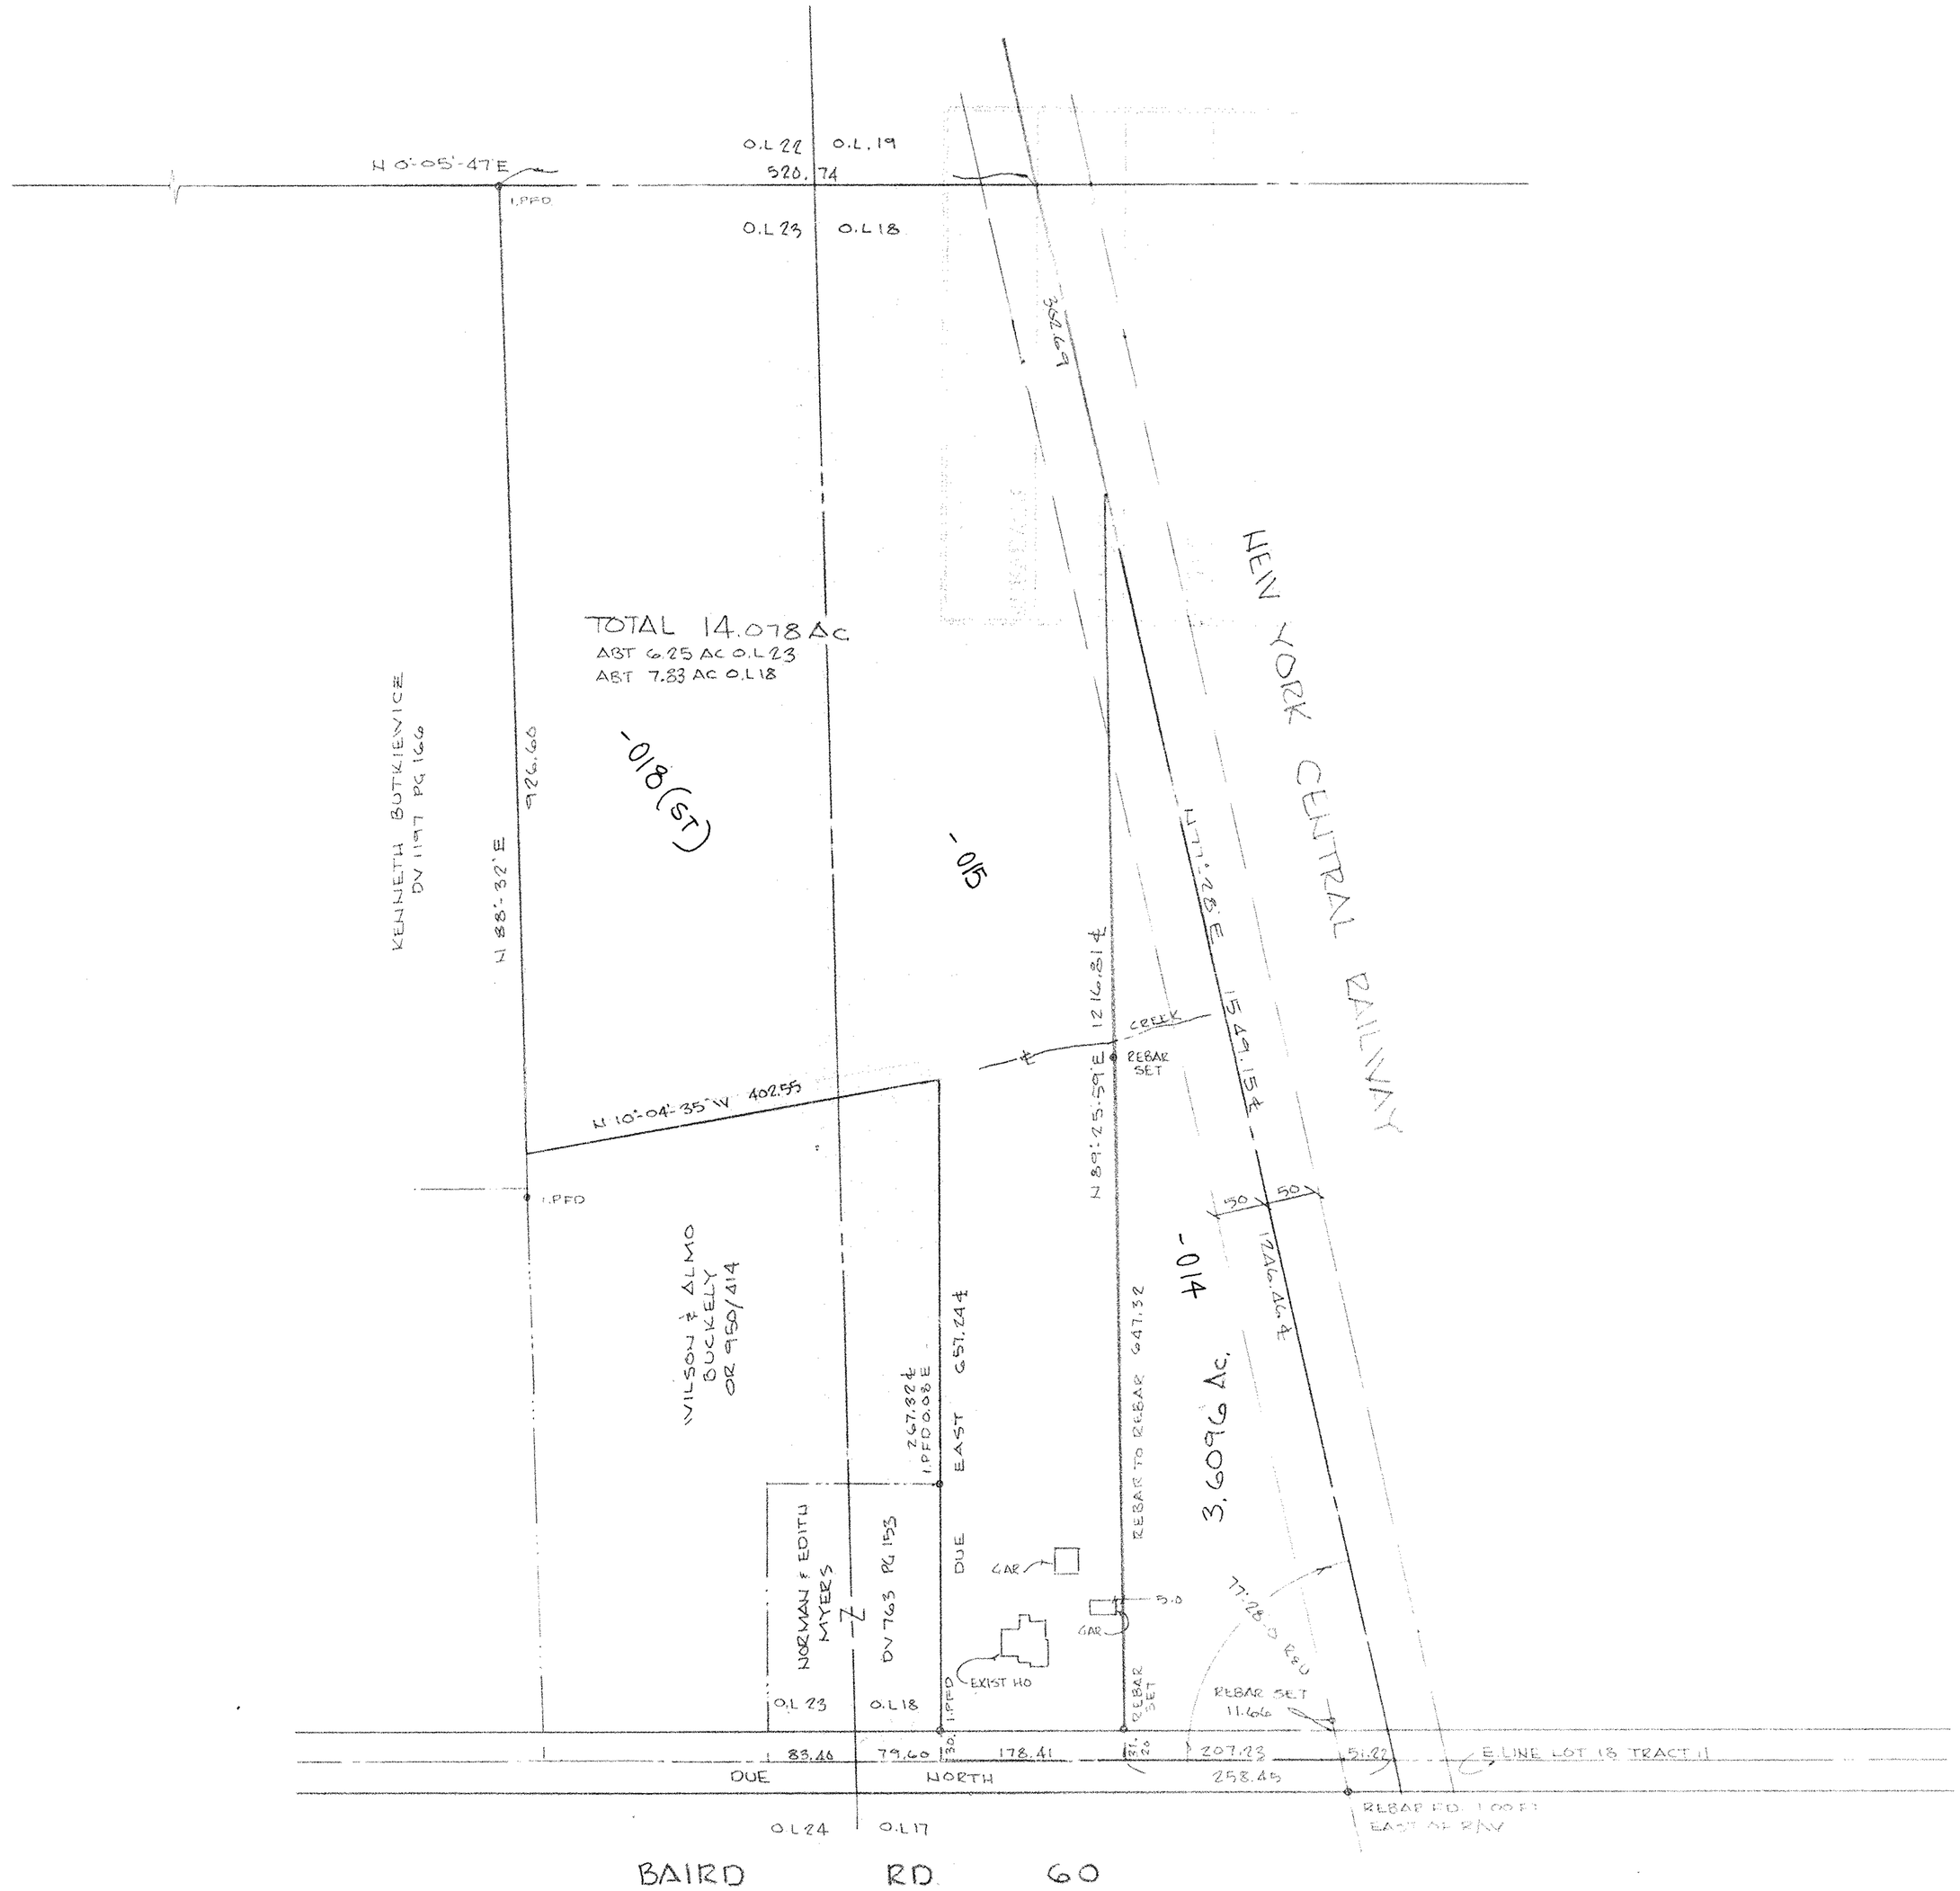

APPROVED
LORAIN COUNTY
SANITARY ENGINEER
DATE 10-10-01
PAGE 13-B
BY JHATFIELD
01-00892

#00892