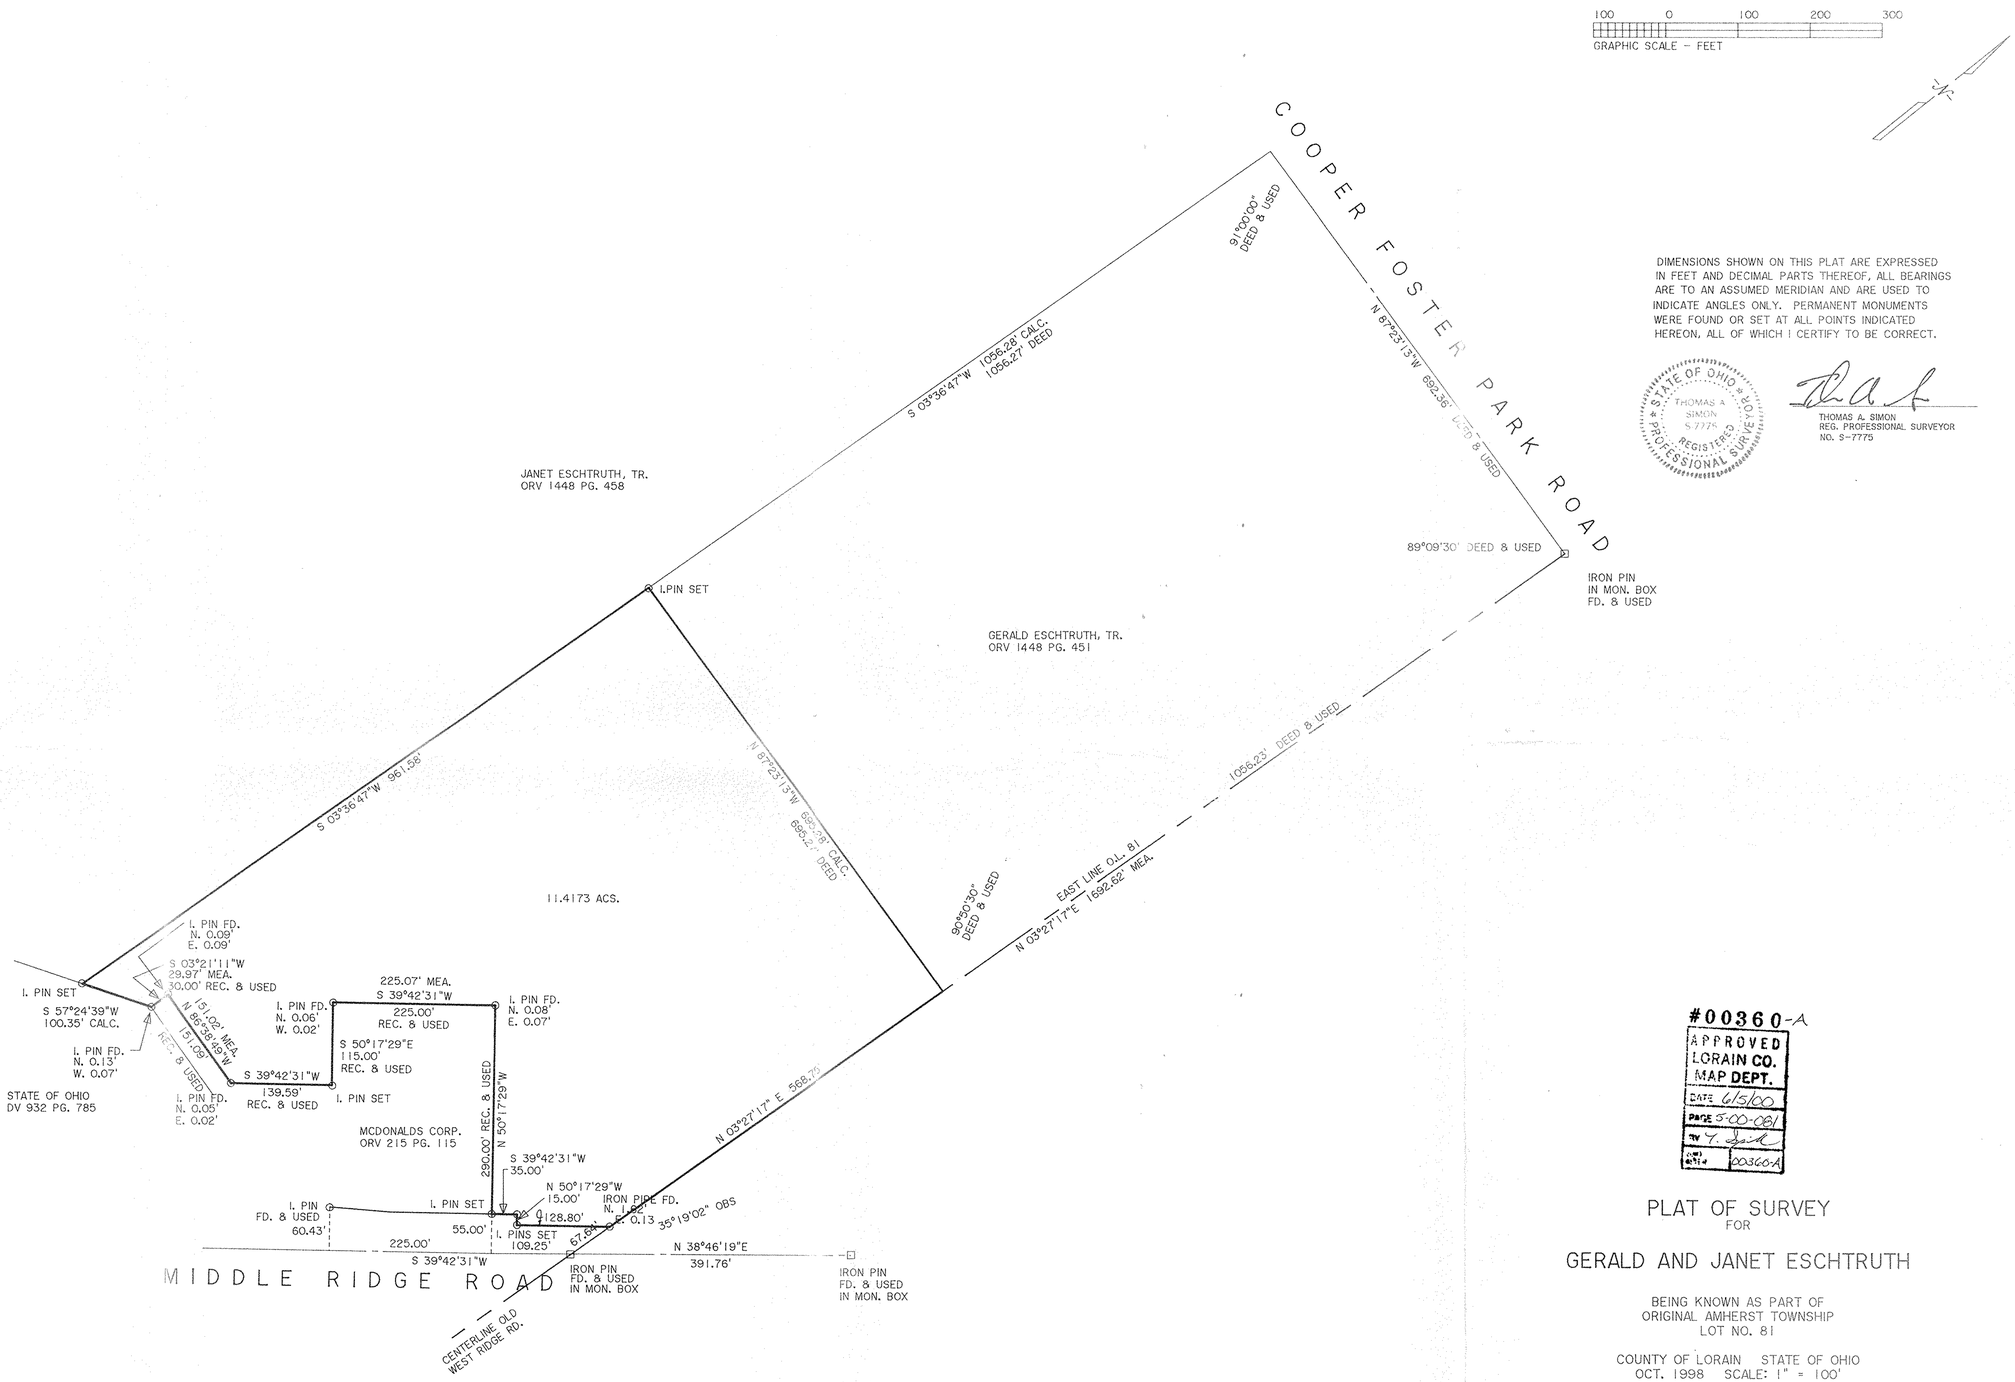

DIMENSIONS SHOWN ON THIS PLAT ARE EXPRESSED IN FEET AND DECIMAL PARTS THEREOF, ALL BEARINGS ARE TO AN ASSUMED MERIDIAN AND ARE USED TO INDICATE ANGLES ONLY. PERMANENT MONUMENTS WERE FOUND OR SET AT ALL POINTS INDICATED HEREON, ALL OF WHICH I CERTIFY TO BE CORRECT.

STATE OF OHIO
THOMAS A. SIMON
S-7775
REGISTERED
PROFESSIONAL SURVEYOR

THOMAS A. SIMON
REG. PROFESSIONAL SURVEYOR
NO. S-7775

#00360-A

APPROVED
LORAIN CO.
MAP DEPT.
DATE 6/5/00
PAGE 5-00-081
BY Y. Jack
ORIG. 00360-A
REV.

PLAT OF SURVEY
FOR
GERALD AND JANET ESCHTRUTH

BEING KNOWN AS PART OF
ORIGINAL AMHERST TOWNSHIP
LOT NO. 81

COUNTY OF LORAIN STATE OF OHIO
OCT. 1998 SCALE: 1" = 100'

THOMAS SIMON & ASSOCIATES, INC.
PROFESSIONAL LAND SURVEYORS
28901 CLEMENS ROAD
SUITE 119
WESTLAKE, OHIO 44145
(440) 871-1391
FAX (440) 871-7335

00-06346-A