#00368-D

APPROVED
LORAIN CO.
MAP DEPT.
DATE 7-18-00
PAGE 14-B
BY TJMcNair
00368-D

THIS CORRECTS DEEDS FOR # 00352

MAP OF SURVEY AND LOT SPLIT

PREPARED FOR

LEROY F. AND SHARON M. JORDAN

SITUATED IN THE TOWNSHIP OF PITTSFIELD, COUNTY OF LORAIN, STATE OF OHIO AND BEING KNOWN AS PART OF ORIGINAL PITTSFIELD TOWNSHIP LOT 68 AND 73

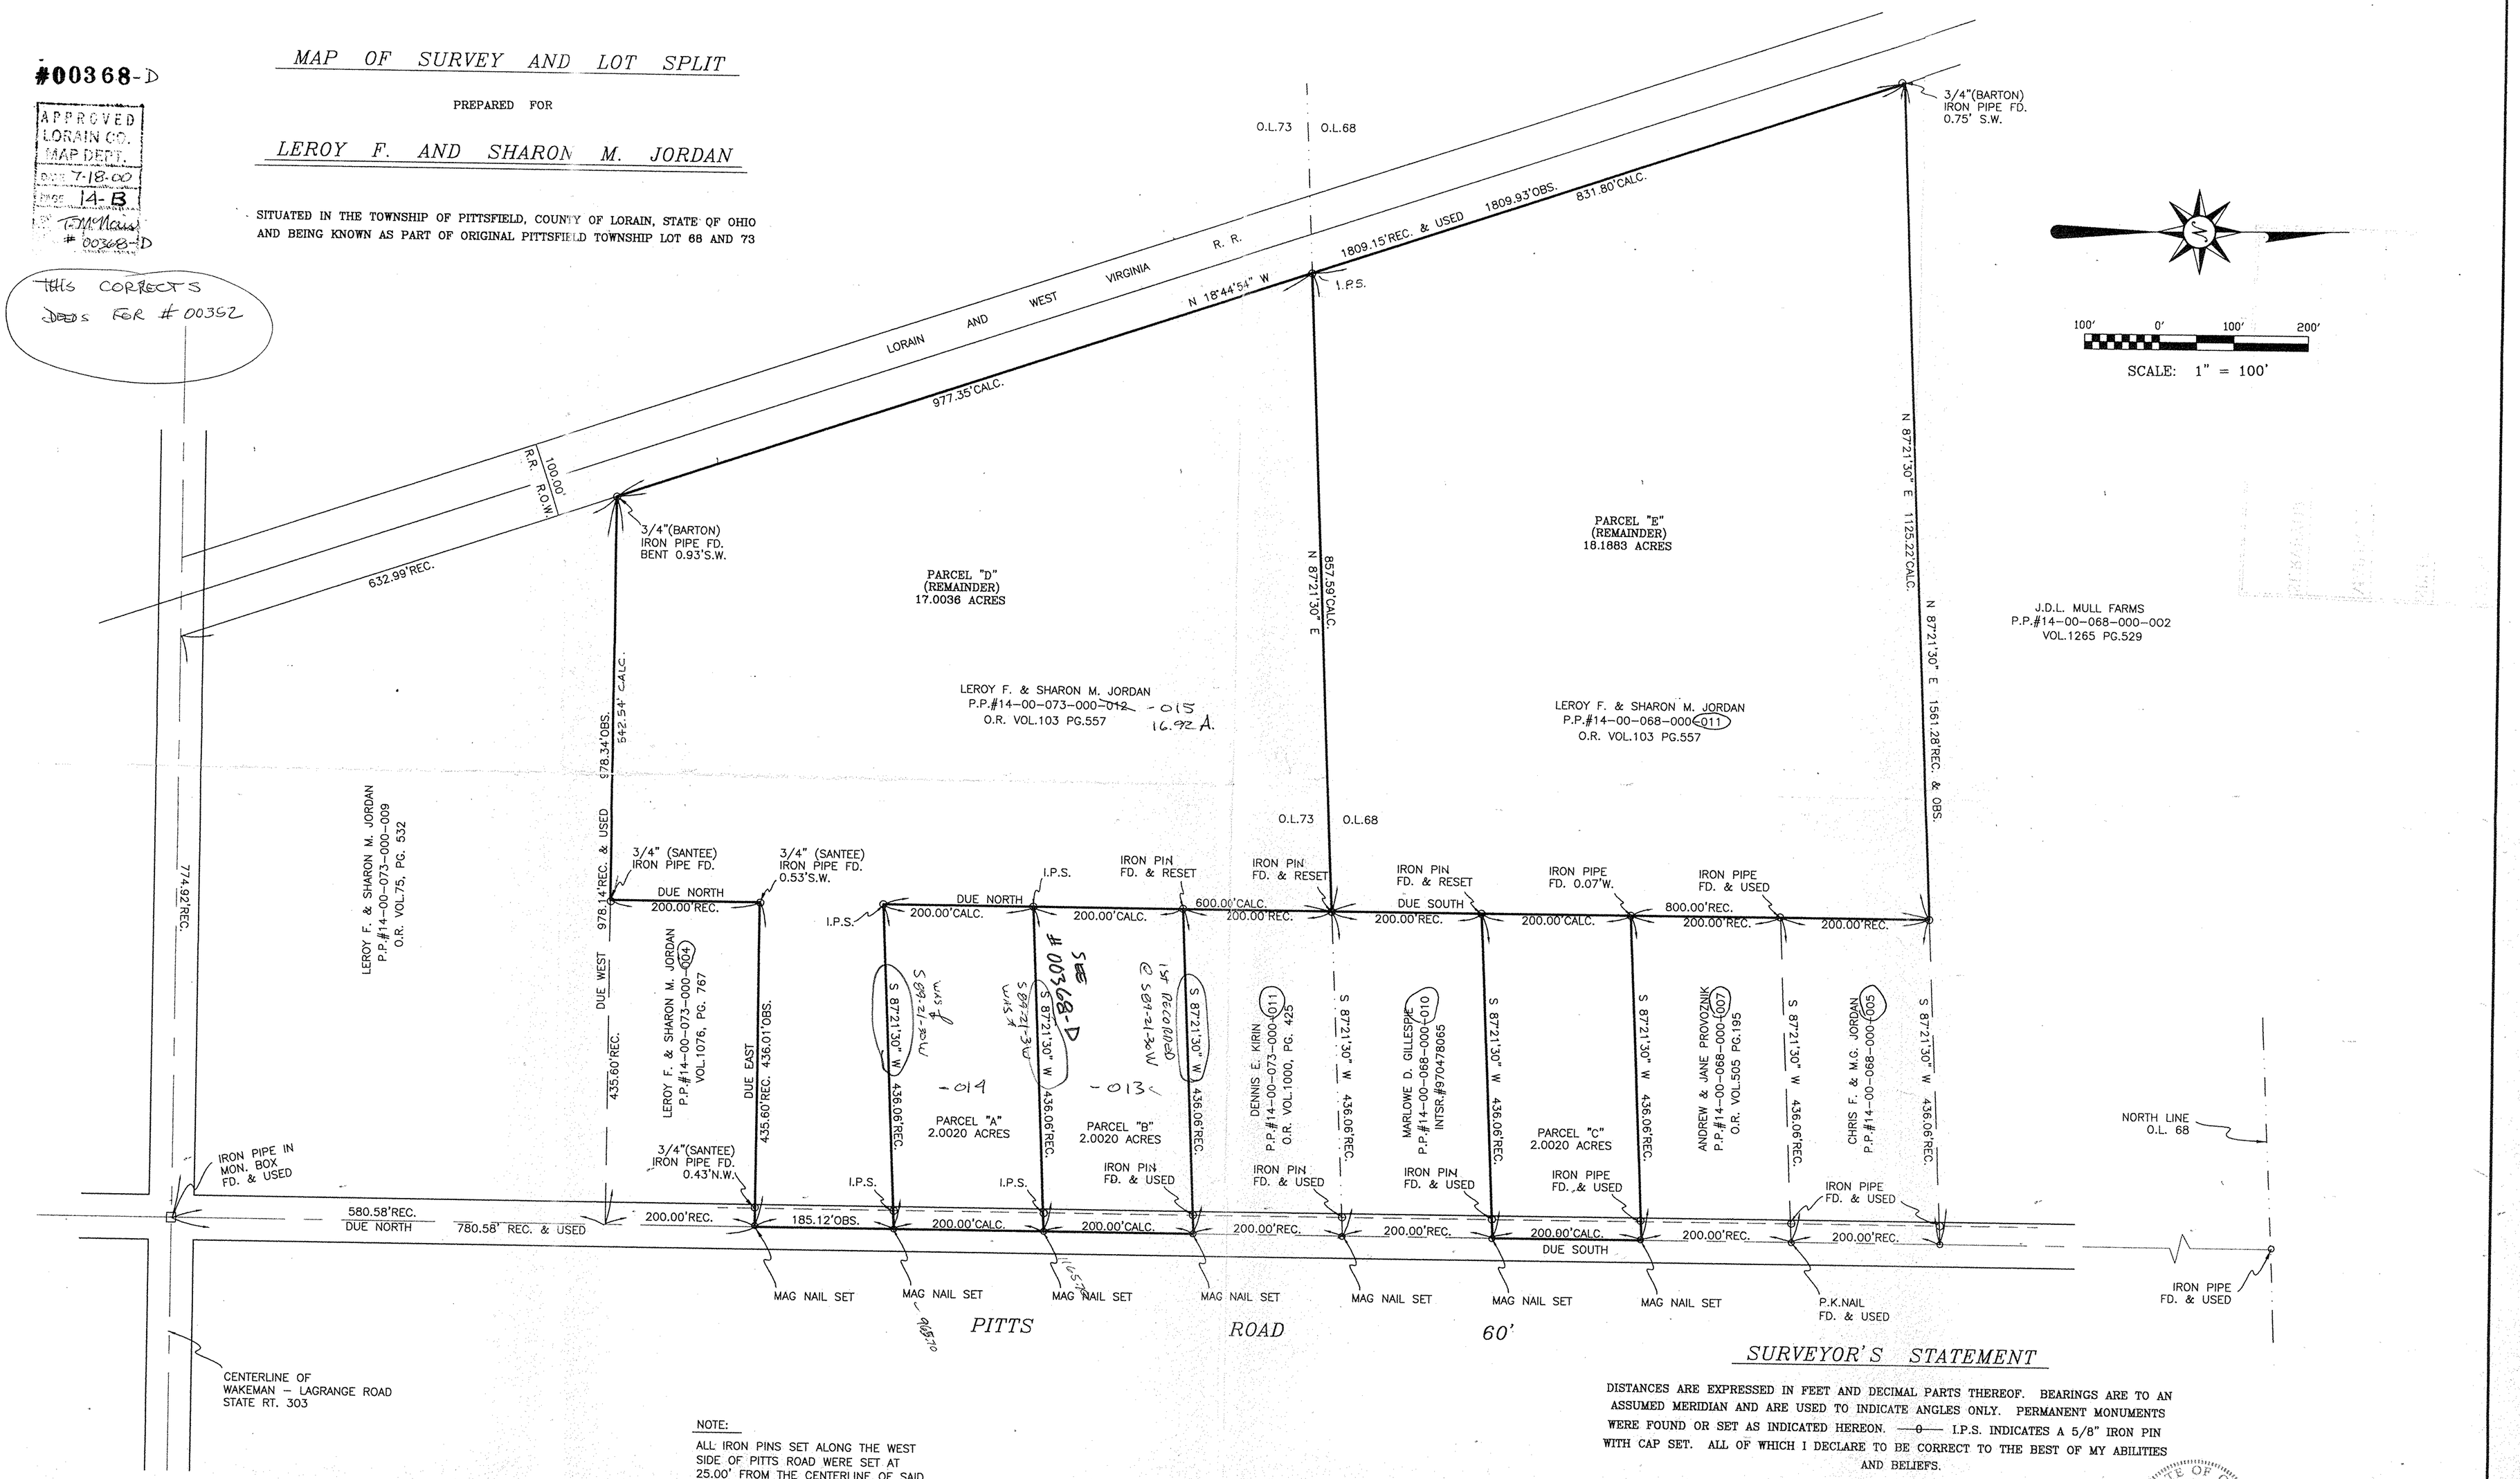

NOTE:

ALL IRON PINS SET ALONG THE WEST SIDE OF PITTS ROAD WERE SET AT 25.00' FROM THE CENTERLINE OF SAID ROADWAY CONSISTANT WITH ALL EXISTING IRON PINS AND PIPES FOUND

SURVEYOR'S STATEMENT

DISTANCES ARE EXPRESSED IN FEET AND DECIMAL PARTS THEREOF. BEARINGS ARE TO AN ASSUMED MERIDIAN AND ARE USED TO INDICATE ANGLES ONLY. PERMANENT MONUMENTS WERE FOUND OR SET AS INDICATED HEREON. —0— I.P.S. INDICATES A 5/8" IRON PIN WITH CAP SET. ALL OF WHICH I DECLARE TO BE CORRECT TO THE BEST OF MY ABILITIES AND BELIEFS.

Thomas M. Snezek
THOMAS M. SNEZEK, R.L.S. #7051

5-19-00
DATE

STATE OF OHIO THOMAS M. SNEZEK 7051 SURVEYOR

REVISED 4/14/00
PROJECT NO. 0002 1/24/00