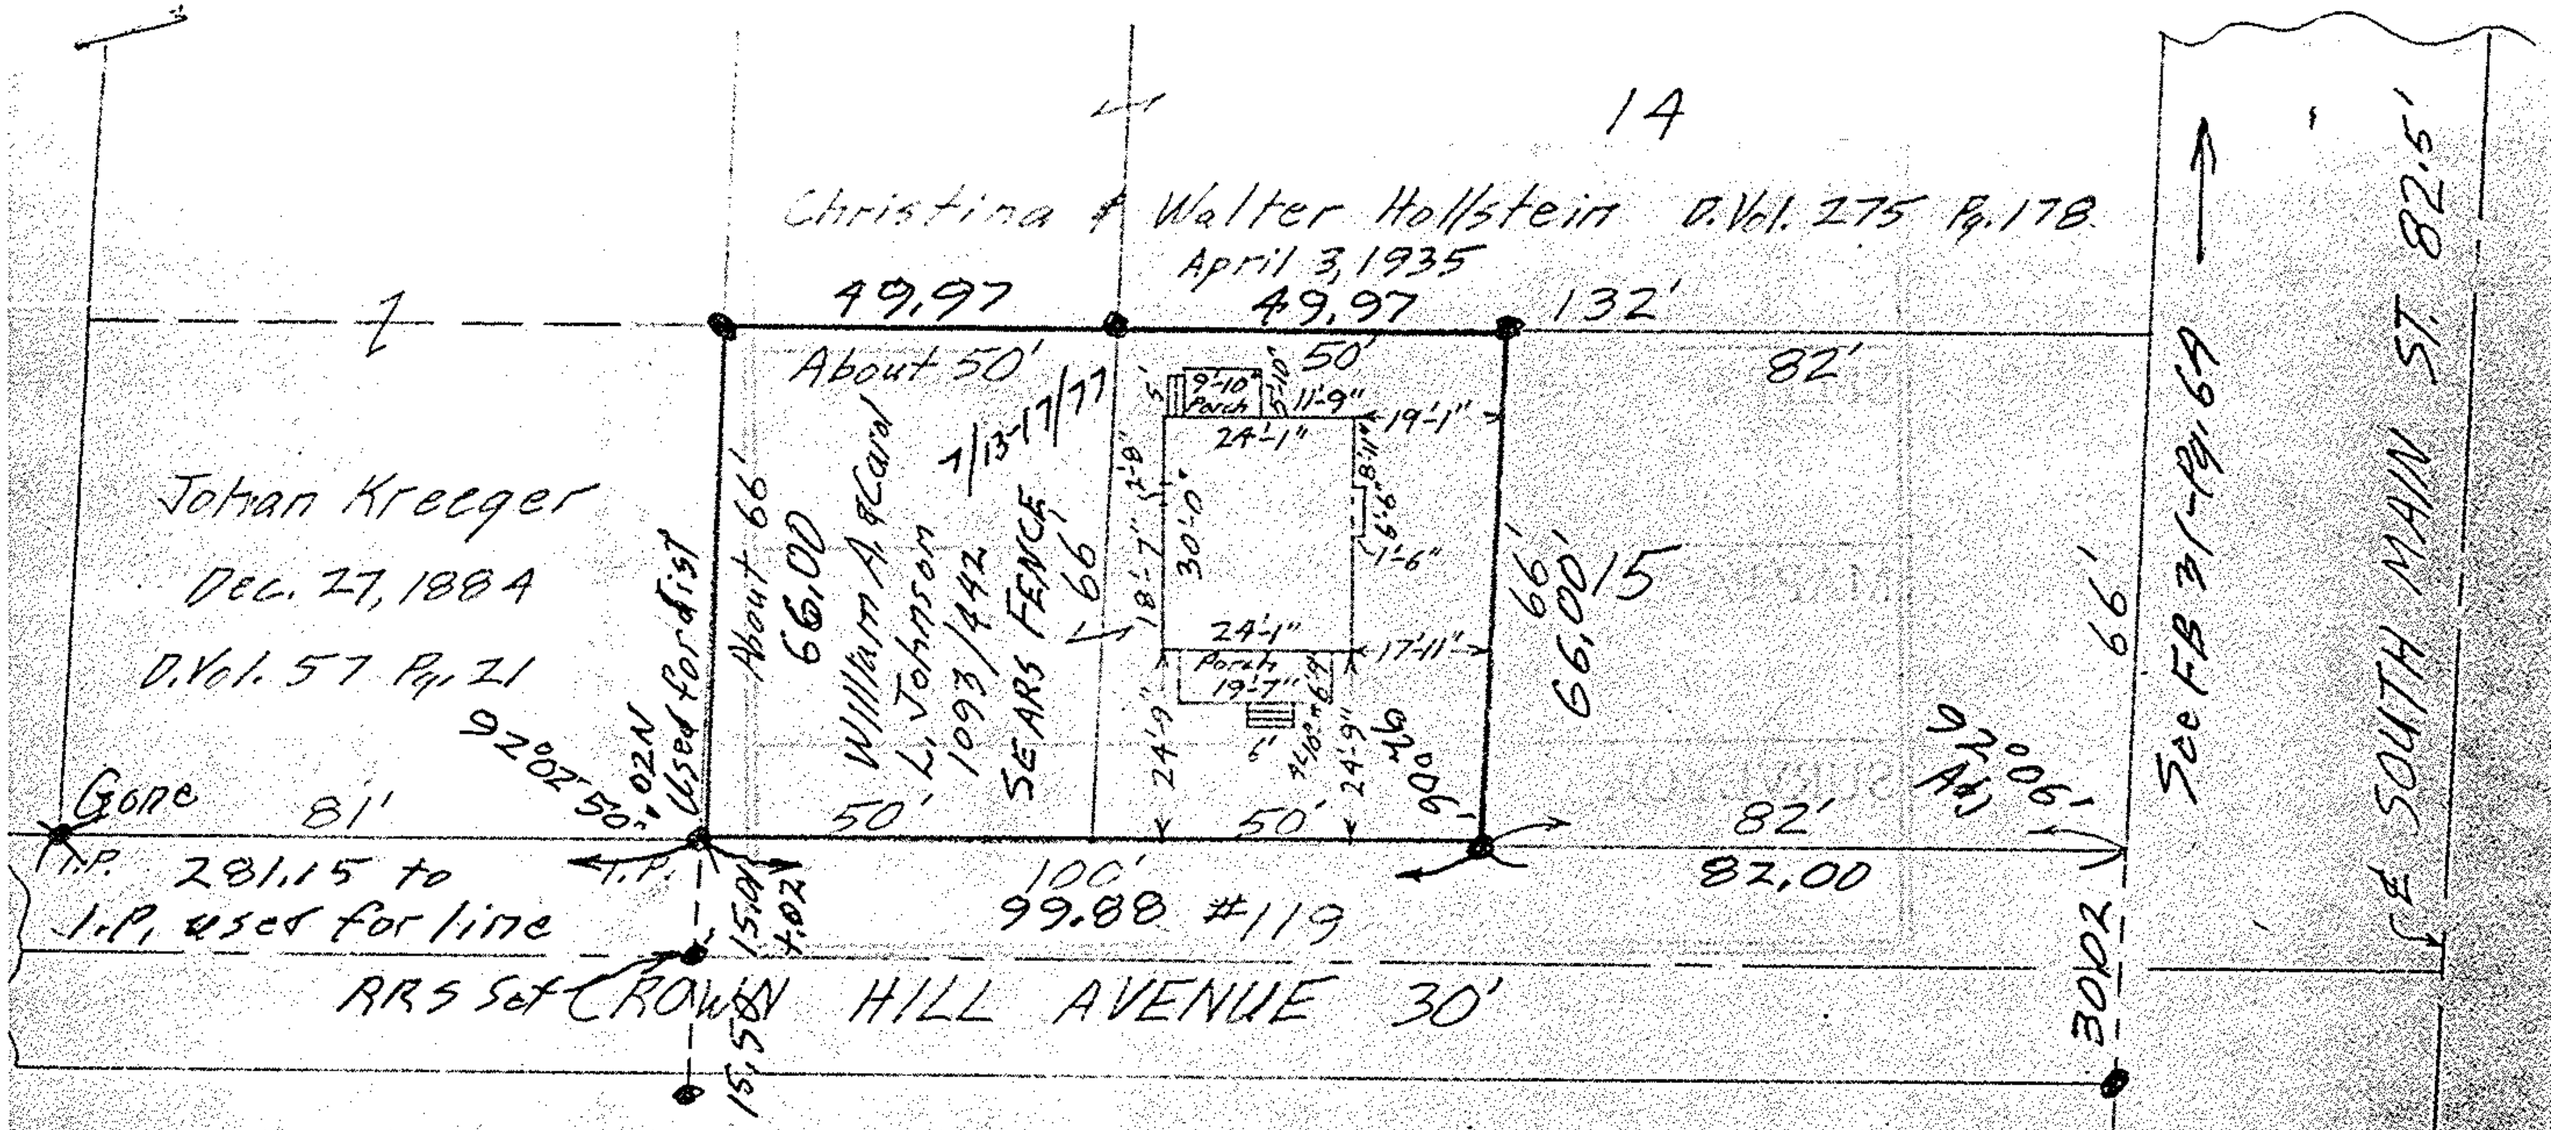

See Field Book 31-Pg. 64 & 65

MAP OF WESTERLY 50' OF SUB-LOT NO. 15 OF THE VILLAGE PLAT OF NORTH AMHERST D. VOL. 1 PG. 187 AND PART OF ORIGINAL LOT NO. 24 OF AMHERST TWP. (1)

AMHERST CITY LORAIN COUNTY OHIO

SCALE: 1" = 30' APRIL 9 - 1965 5:30 P.M.

Guy E. Penfound REG. SURVEYOR NO. 4457

Jack R. & Frances L. Vogel