


OBERLIN NORTH ROAD (S.R. 58)

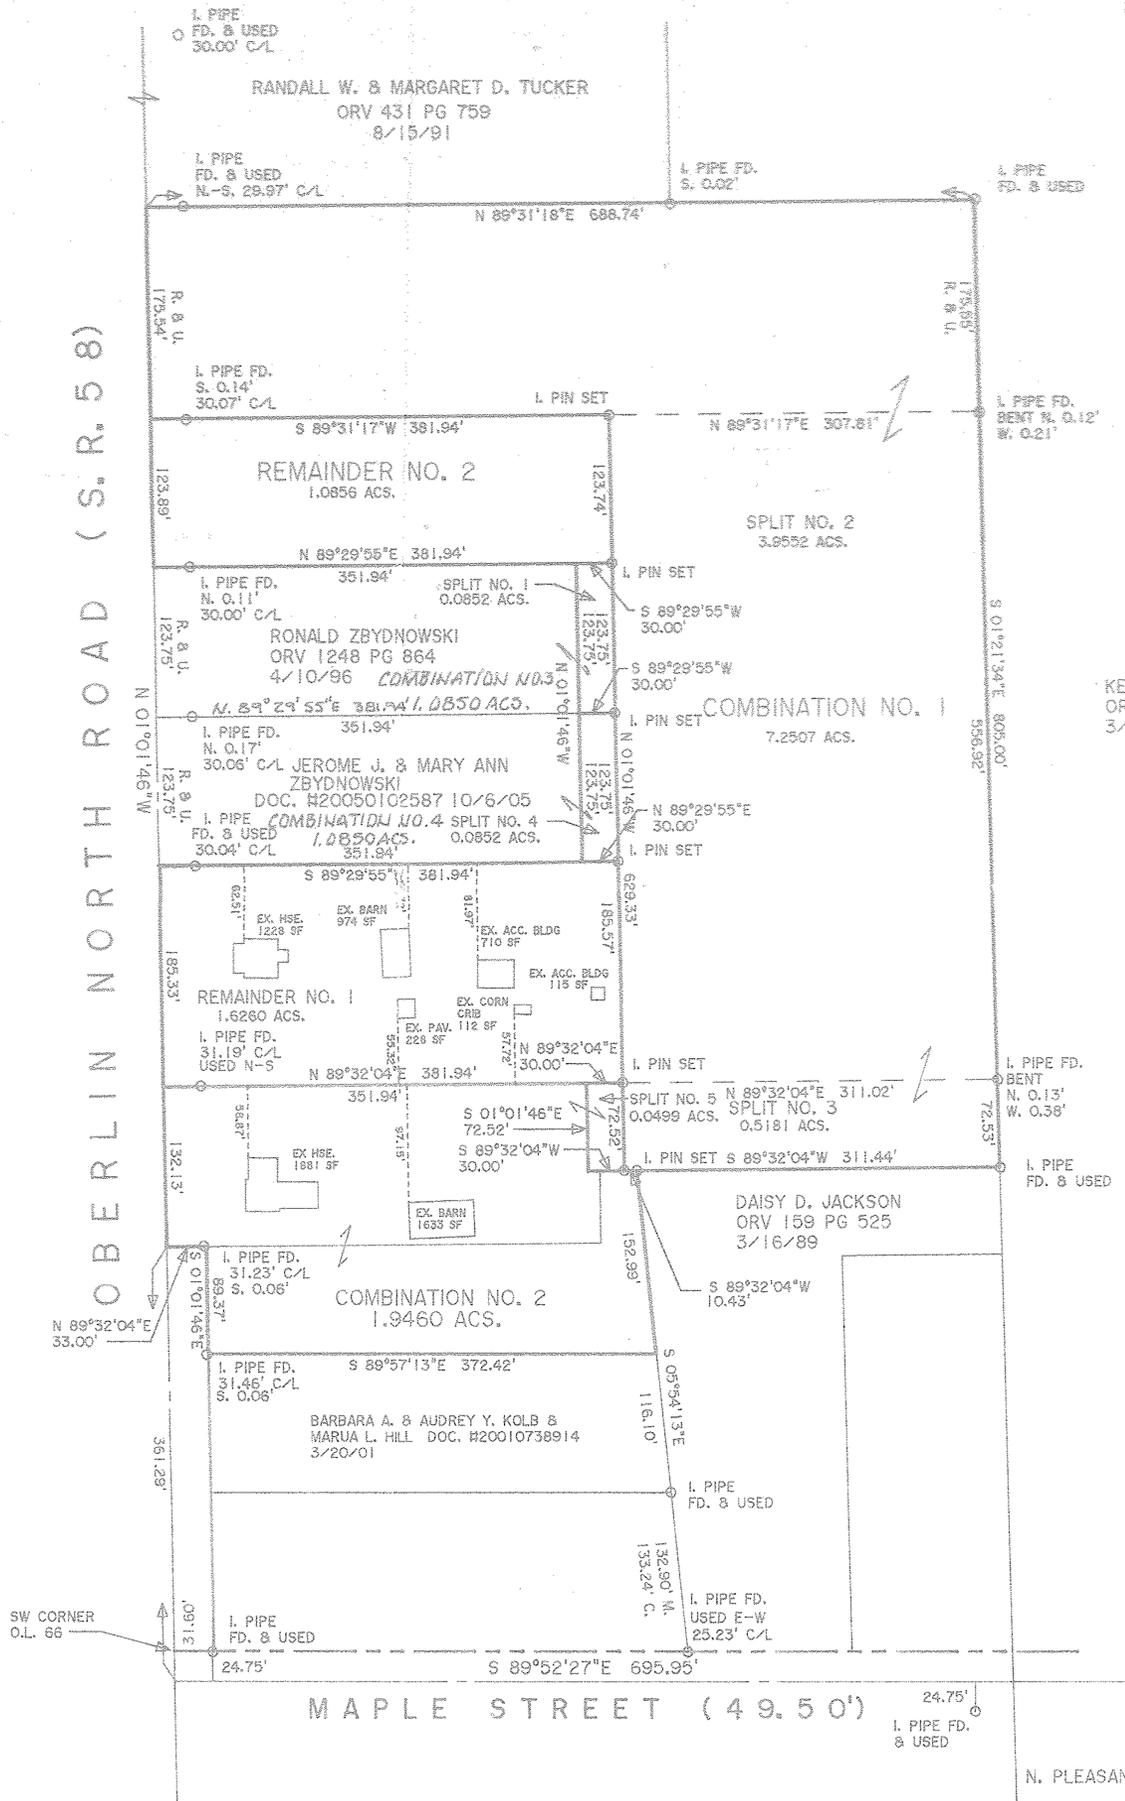

DIMENSIONS SHOWN ON THIS PLAT ARE EXPRESSED IN FEET AND DECIMAL PARTS THEREOF, ALL BEARINGS ARE TO AN ASSUMED MERIDIAN AND ARE USED TO INDICATE ANGLES ONLY. PERMANENT MONUMENTS WERE FOUND OR SET AT ALL POINTS INDICATED HEREON, ALL OF WHICH I CERTIFY TO BE CORRECT.

Thomas A. Simon

THOMAS A. SIMON
REG. PROFESSIONAL SURVEYOR
NO. S-7775



BASIS OF BEARINGS IS THE CENTERLINE OF OBERLIN ROAD NORTH (STATE ROUTE 58), (NORTH 01°01'46" WEST). IRON PINS SET ARE 5/8" DIAMETER, 30" LONG WITH PLASTIC CAPS, "T. SIMON, S-7775".

PLAT OF SURVEY, SPLIT & COMBINATION FOR IRENE ZBYDNOWSKI, TRUSTEE

BEING KNOWN AS PART OF ORIGINAL NEW RUSSIA TOWNSHIP LOT NO. 66

COUNTY OF LORAIN STATE OF OHIO
NOVEMBER, 2006 SCALE: 1" = 100'

THOMAS SIMON & ASSOCIATES, INC.
PROFESSIONAL LAND SURVEYORS

150 SOUTH OLIVE STREET
ELYRIA, OHIO 44035

(440) 327-2925
FAX 327-2964

REV. 4/25/07
REV. 1/18/07 - CREATE COMB. NO. 2
ADD EX. BUILDINGS