THE KRYSTOWSKI LOT SPLIT CITY OF AVON ÷ LORAIN COUNTY ÷ OHIO

PART OF AVON TOWNSHIP SECTION NO. 2

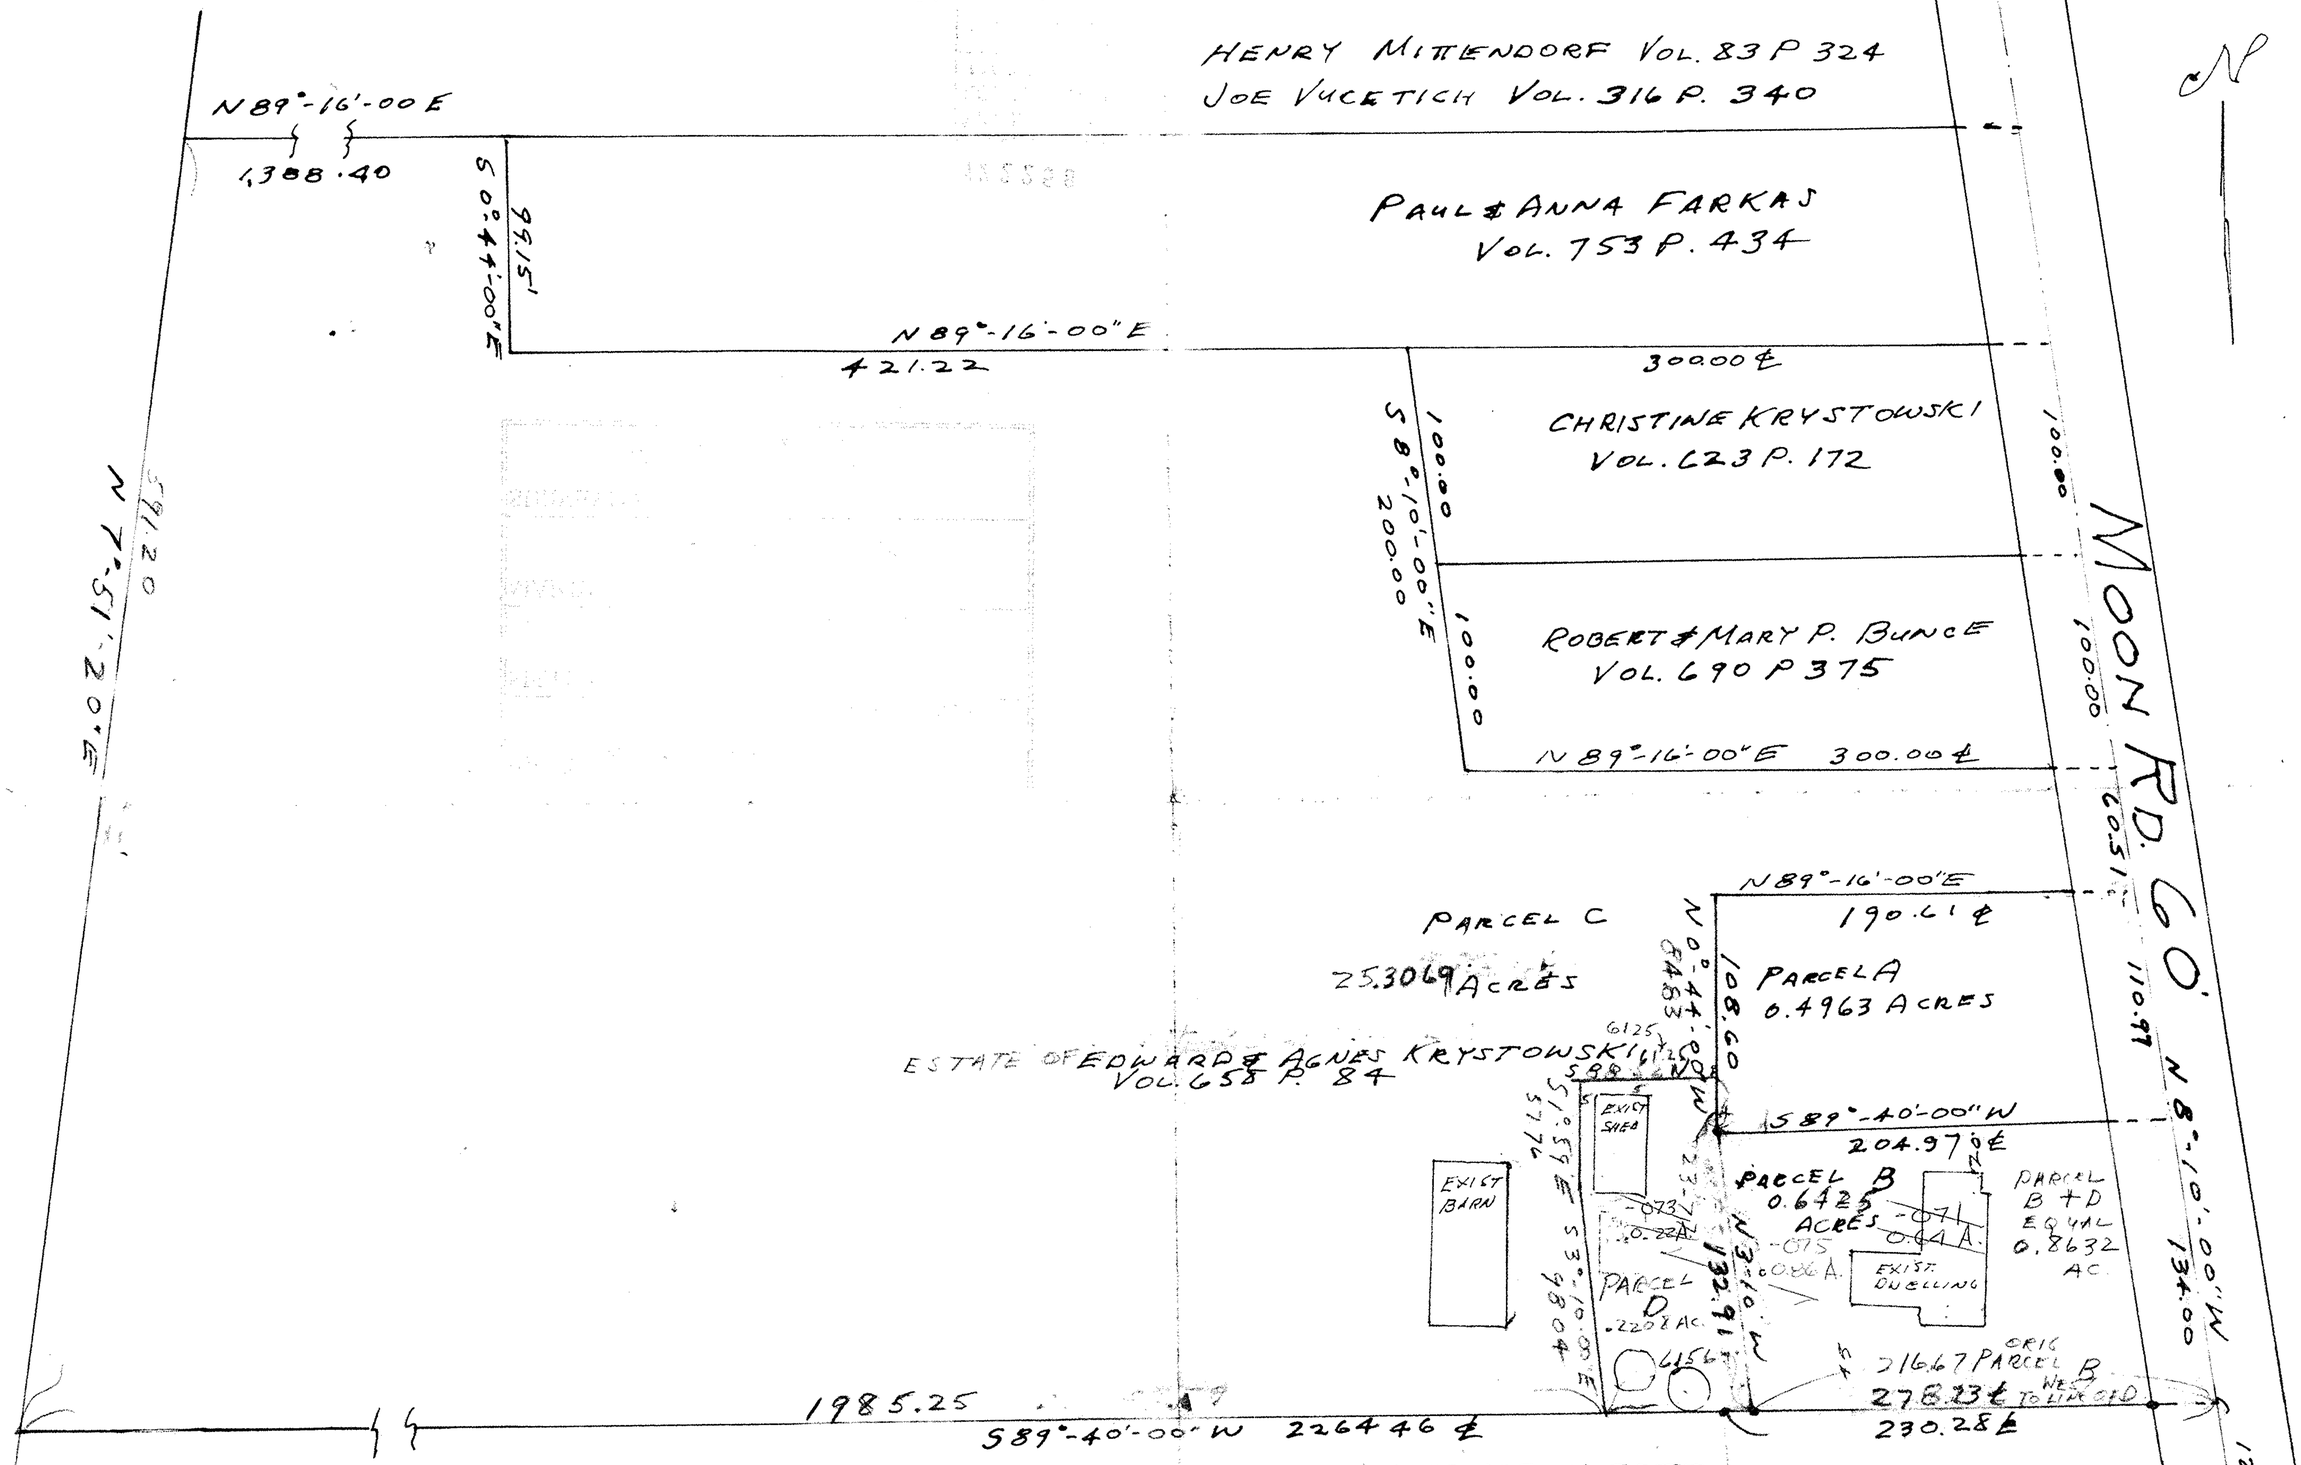

CONSULTING ENGINEER & SURVEYOR #4289
2643 JOSEPH ST.
AVON OHIO 44011

871-4075
937-5353