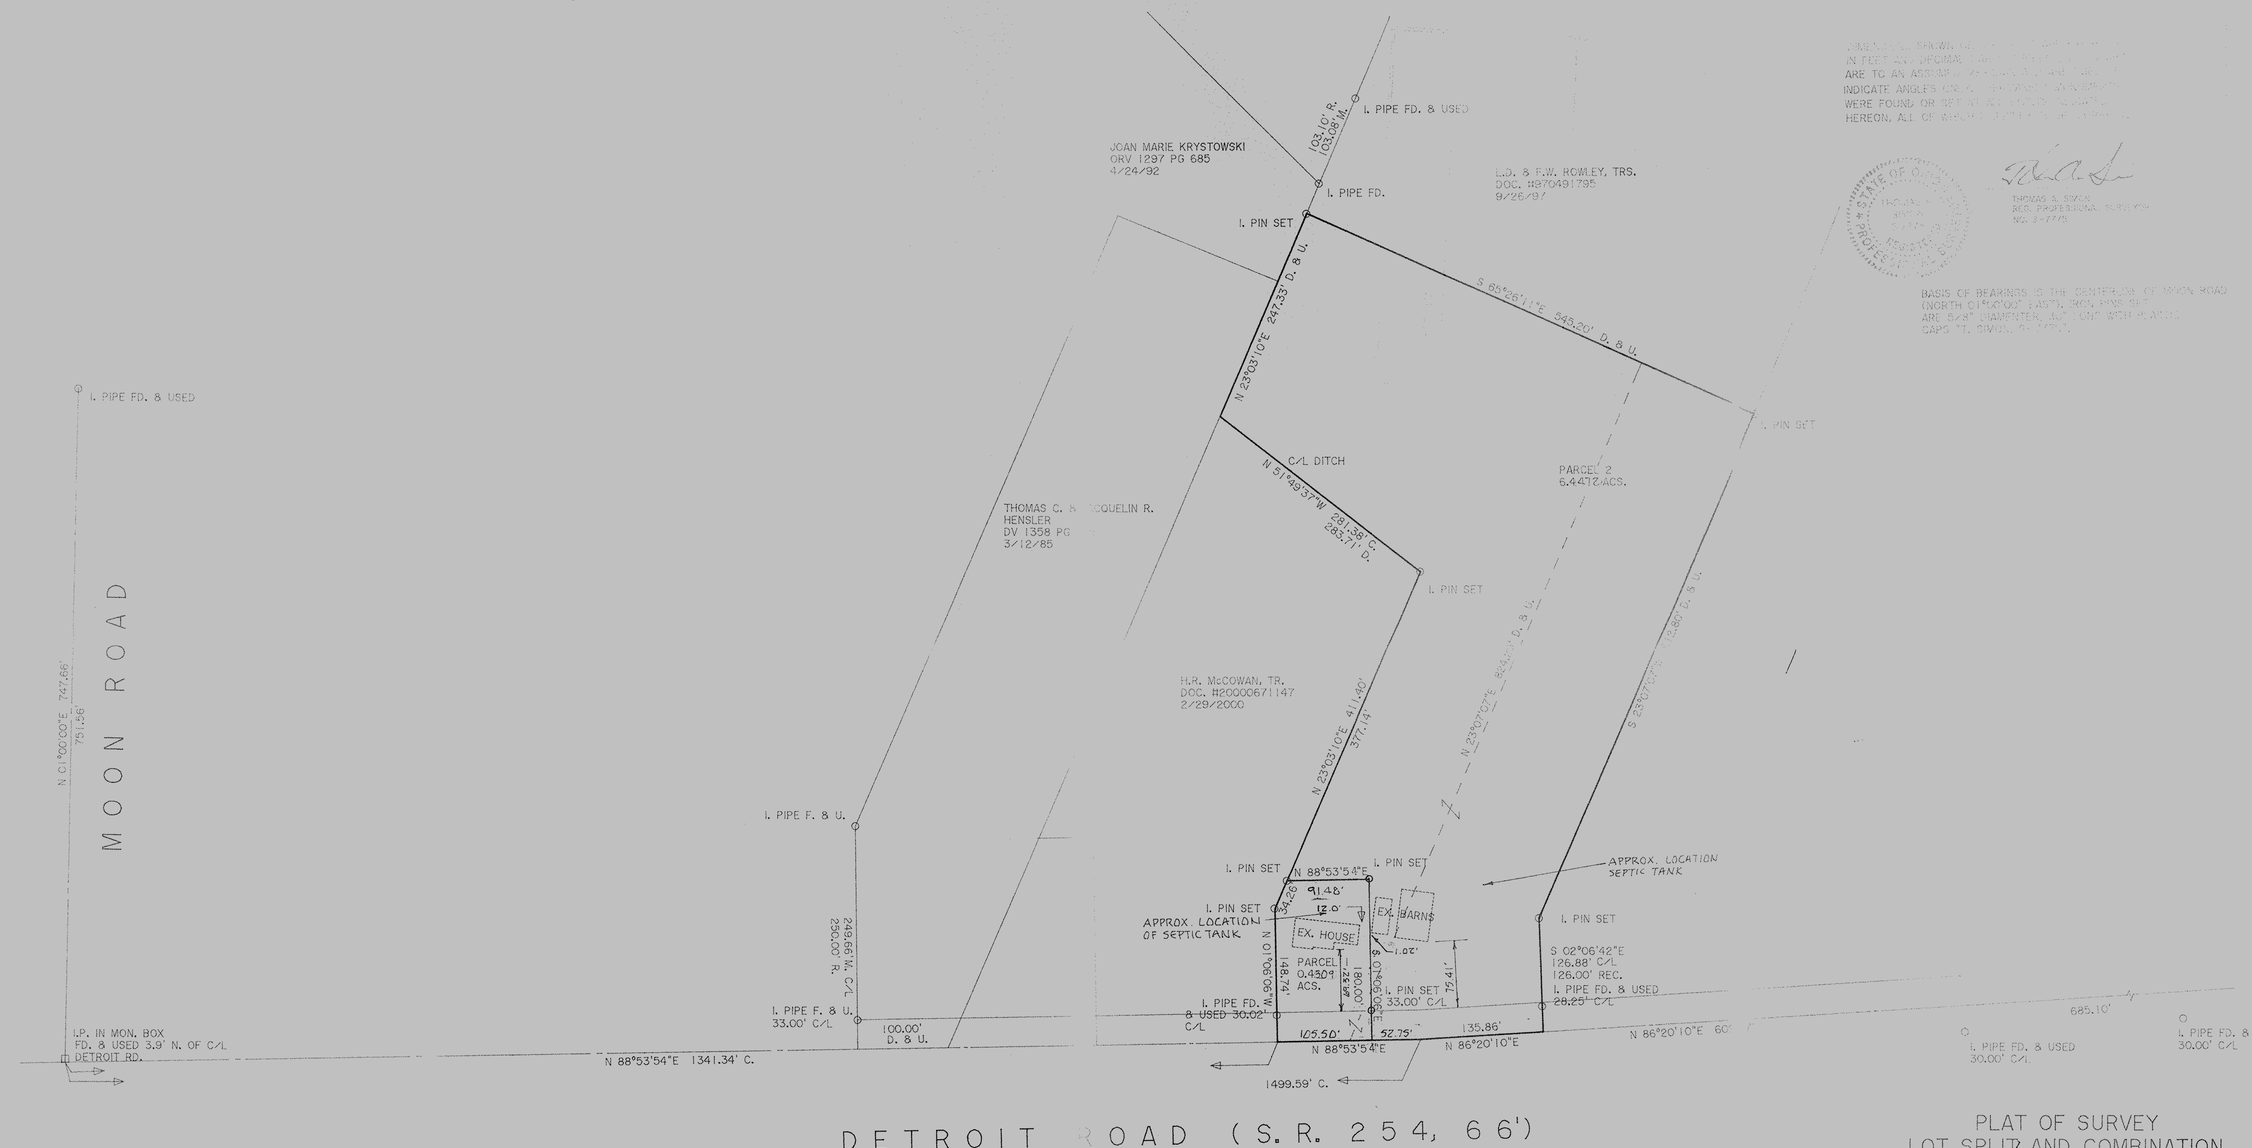

DETROIT ROAD (S.R. 254, 66')

BASIS OF BEARINGS IS THE CENTERLINE OF MOON ROAD (NORTH 01°00'00" EAST). IRON PINS SET ARE 5/8" DIAMETER, 30" LONG WITH PLASTIC CAPS "T. SIMON, S-7770".

THOMAS A. SIMON
REG. PROFESSIONAL SURVEYOR
NO. S-7770

STATE OF OHIO
THOMAS A. SIMON
S-7770
REGISTERED
PROFESSIONAL SURVEYOR

PLAT OF SURVEY
LOT SPLIT AND COMBINATION
FOR

REGIS KLINGSHIRN

BEING KNOWN AS PART OF ORIGINAL AVON TOWNSHIP
SECTION NO. 2

CITY OF AVON COUNTY OF LORAIN
STATE OF OHIO

MARCH, 2001 SCALE: 1" = 80'

THOMAS SIMON & ASSOCIATES, INC.
PROFESSIONAL LAND SURVEYORS

COBBLESTONE CORNER PROFESSIONAL CENTER
39049 CENTER RIDGE ROAD
NORTH RIDGEVILLE, OHIO 44039
(440) 327-2925
FAX 327-2964

JOB NO. 2000-057
20000578