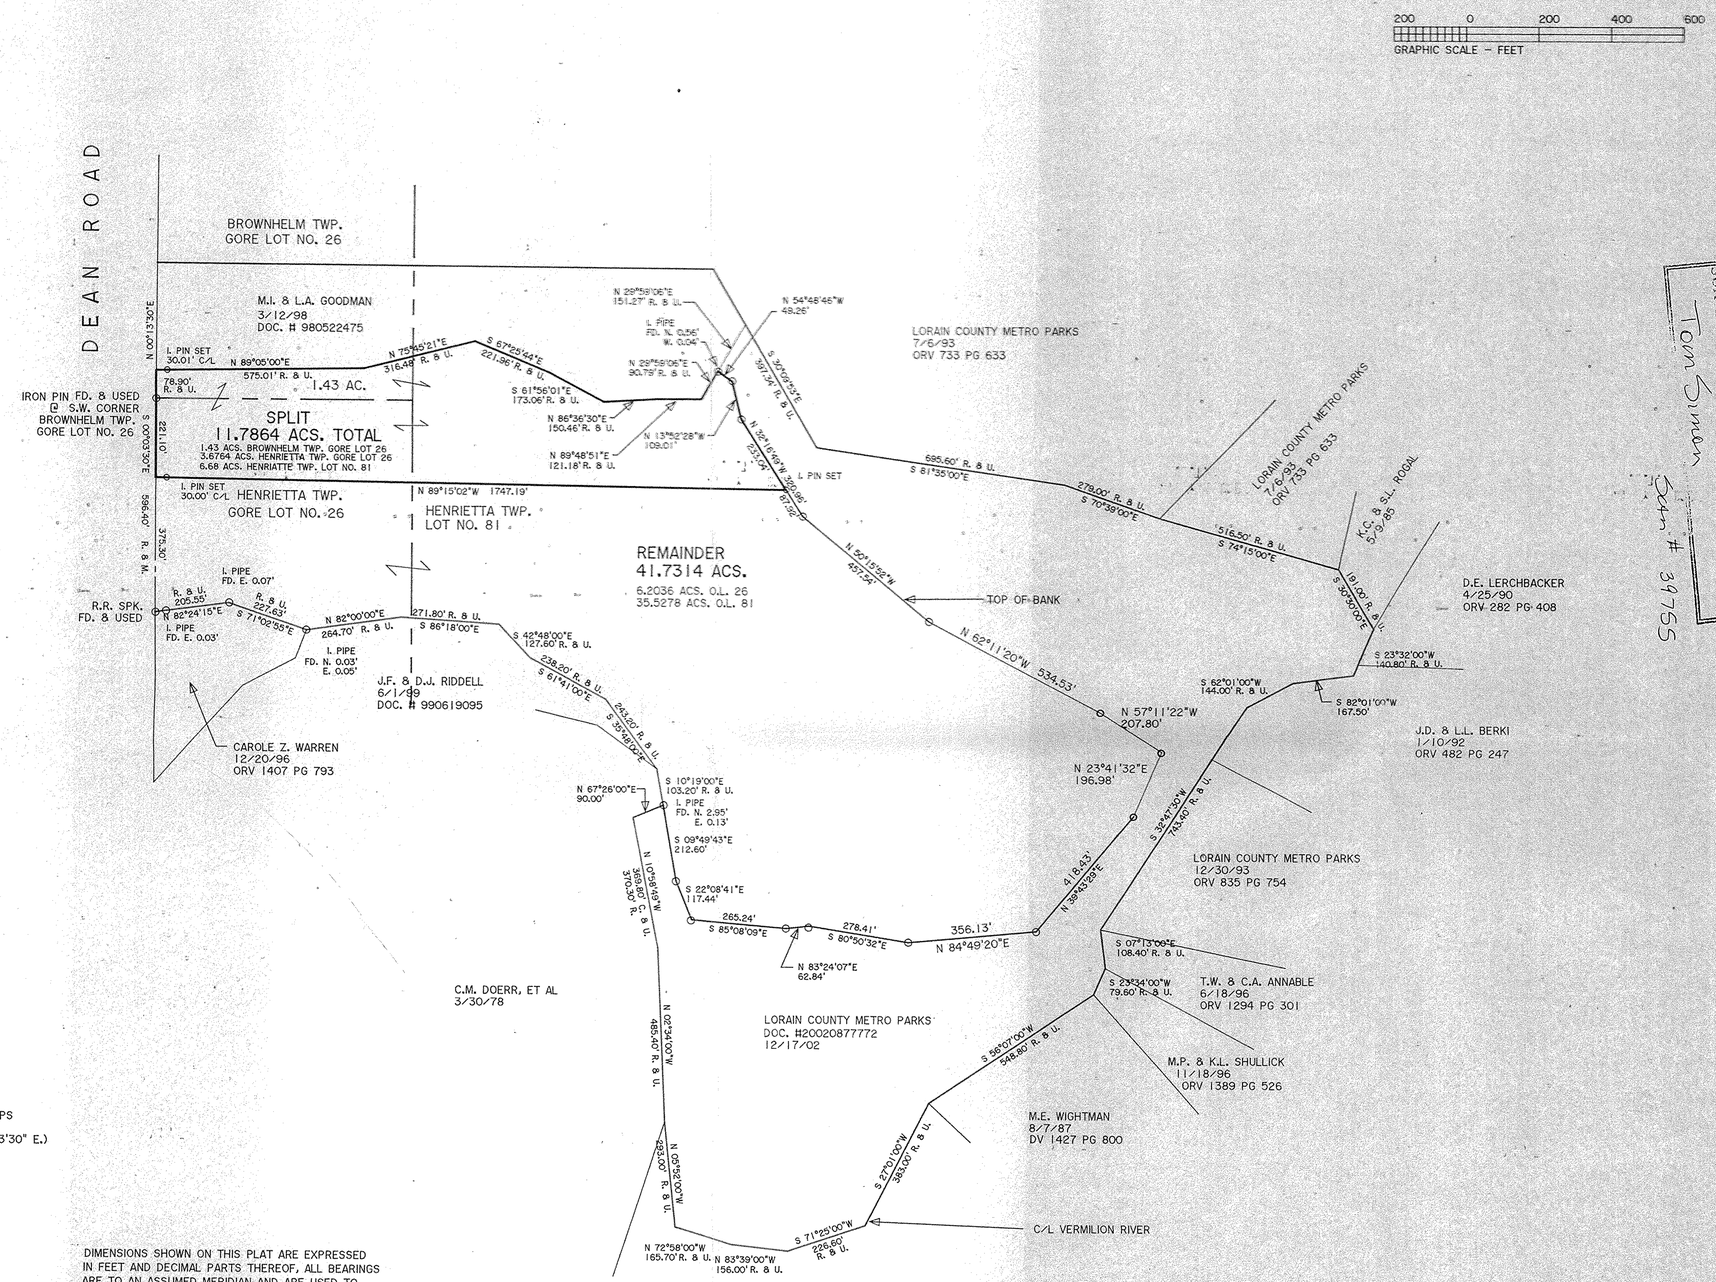

O = IRON PIN SET

IRON PINS SET ARE 5/8" DIAMETER, 30" LONG WITH PLASTIC CAPS
"T. SIMON S-7775"
BASIS OF BEARINGS IS THE CENTERLINE OF DEAN ROAD (S. 00°03'30" E.)

DIMENSIONS SHOWN ON THIS PLAT ARE EXPRESSED IN FEET AND DECIMAL PARTS THEREOF, ALL BEARINGS ARE TO AN ASSUMED MERIDIAN AND ARE USED TO INDICATE ANGLES ONLY. PERMANENT MONUMENTS WERE FOUND OR SET AT ALL POINTS INDICATED HEREON, ALL OF WHICH I CERTIFY TO BE CORRECT.

THOMAS A. SIMON
REG. PROFESSIONAL SURVEYOR
NO. S-7775

THOMAS A. SIMON S-7775 REGISTERED PROFESSIONAL SURVEYOR

THOMAS SIMON & ASSOCIATES, INC.
PROFESSIONAL LAND SURVEYORS

150 SOUTH OLIVE STREET
ELYRIA, OHIO 44035

(440) 327-2925
FAX 327-2964

PPN: Parent 08-20-036-000-005
09-00-031-000-005, 09-00-031-000-007, 08-00-081-000-033
Split # 34755
Chnl. 08-20-036-000-006
SPLIT #
07-02418
MAP/PARCEL
08-00-081-A
NOV 2006
SURVEYED
Tom Simon

№ 02418
APPROVED
COMMISSIONER
DATE 7-5-07
08-00-081-000-033
PARCEL 08-00-081-A
BY
JHatfield

PLAT OF SURVEY AND SPLIT
FOR
MELINDA O'TOOLE

BEING KNOWN AS PARTS OF ORIGINAL HENRIETTA TOWNSHIP LOT NO. 81 AND ORIGINAL HENRIETTA TOWNSHIP GORE LOT 26 AND PART OF ORIGINAL BROWNHELM TOWNSHIP GORE LOT 26

COUNTY OF LORAIN STATE OF OHIO
NOVEMBER, 2006 SCALE: 1" = 200'

REV. 11/6/06
REV. 6/27/02

JOB. NO. 99-019