
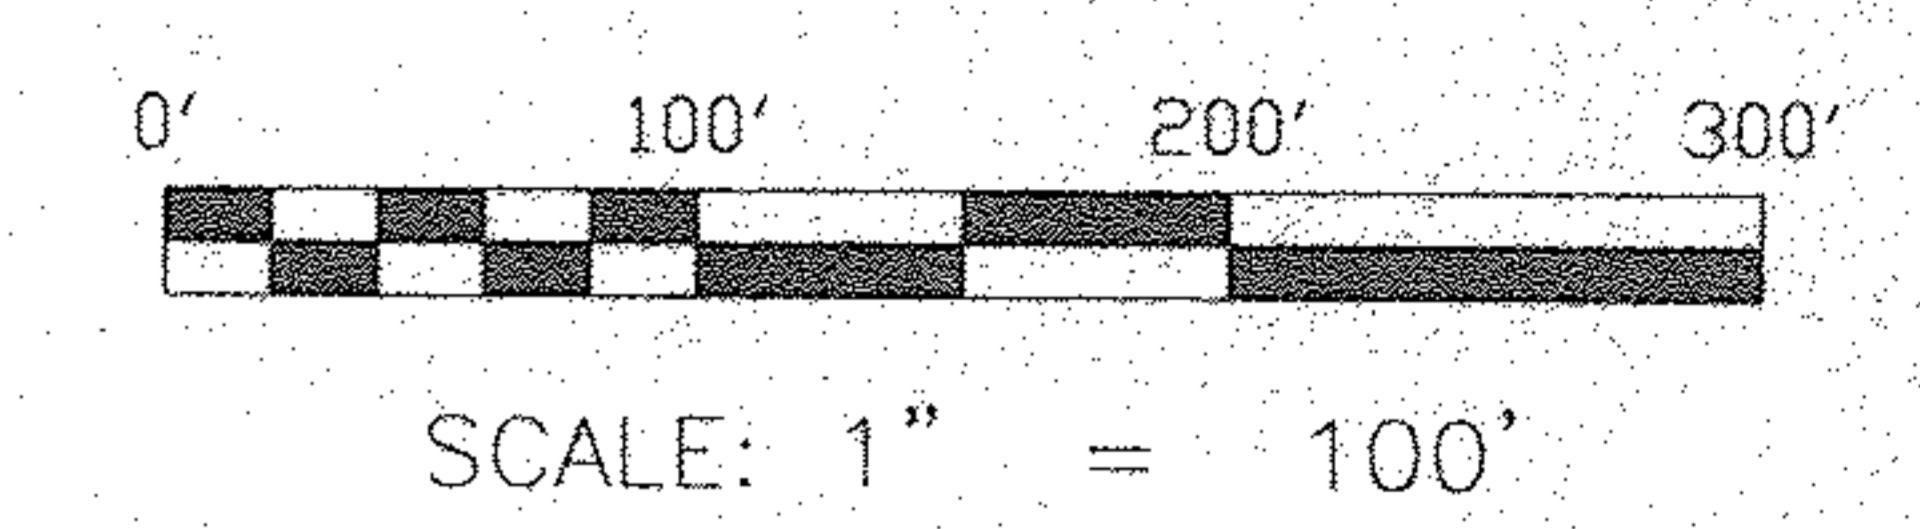
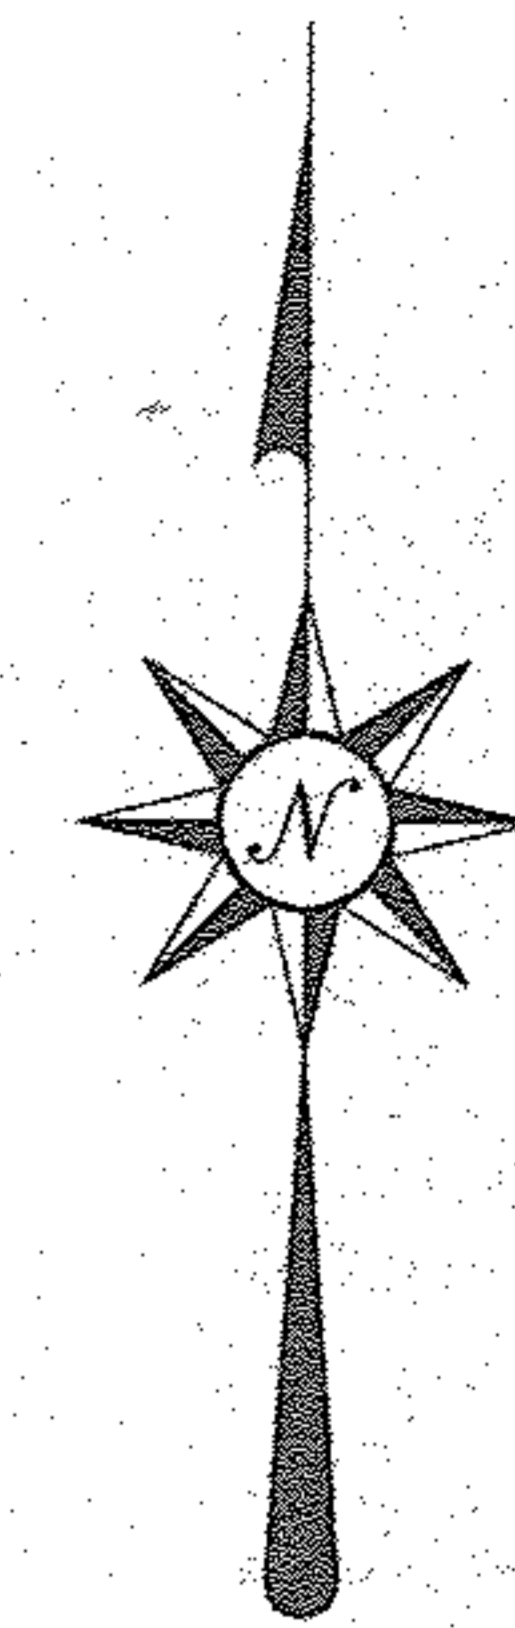


MAP OF SURVEY, LOT SPLIT AND ASSEMBLY

PREPARED FOR

DEAN AND BEVERLY ROICE


SITUATED IN THE TOWNSHIP OF HUNTINGTON, COUNTY OF LORAIN AND STATE OF OHIO AND BEING KNOWN AS PART OF HUNTINGTON TOWNSHIP TRACT 10 AND ALSO BEING KNOWN AS ALL OF THOSE LANDS DEEDED TO BEVERLY ROICE IN DEED INSTRUMENT #2004-0983353 OF LORAIN COUNTY DEED RECORDS.

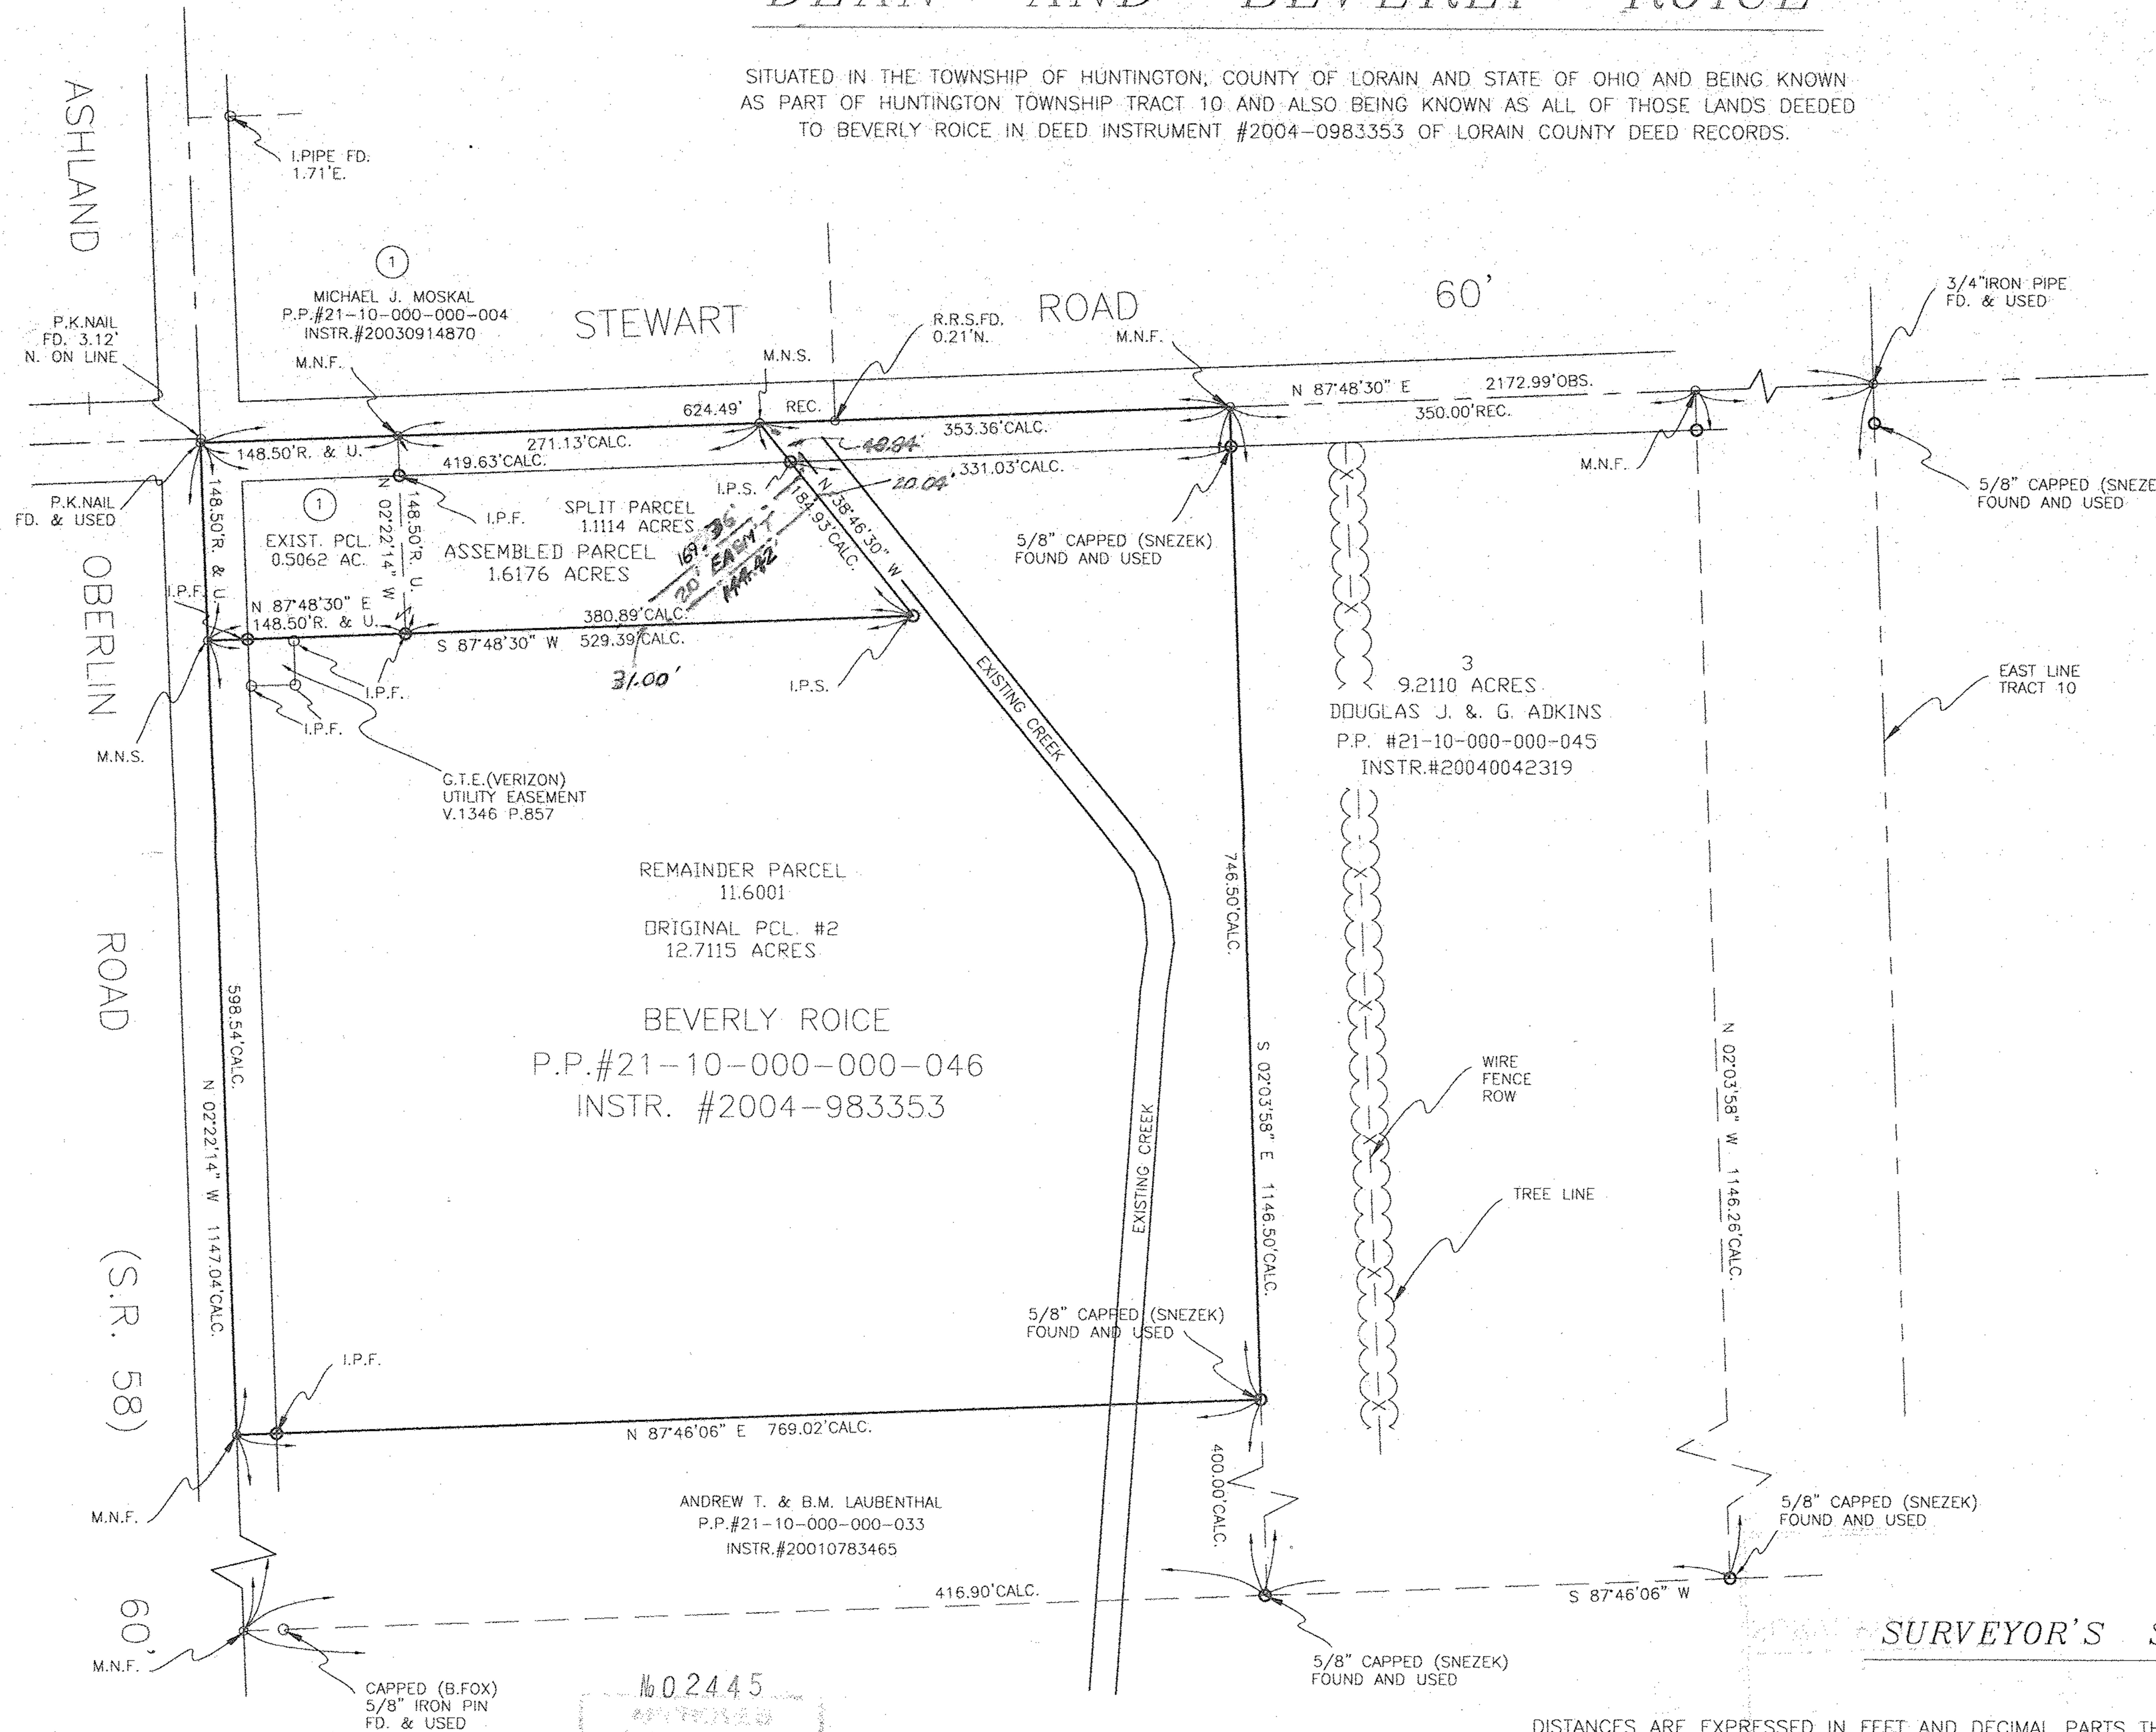

SURVEYOR'S STATEMENT

DISTANCES ARE EXPRESSED IN FEET AND DECIMAL PARTS THEREOF. BEARINGS ARE TO AN ASSUMED MERIDIAN AND ARE USED TO INDICATE ANGLES ONLY. PERMANENT MONUMENTS WERE FOUND OR SET AS INDICATED HEREON. —○— I.P.S. INDICATES A 5/8" IRON PIN WITH IDENTIFICATION CAP SET. —○— M.N.S. INDICATES A MAGNETIC NAIL SET. ALL OF WHICH I DECLARE TO BE CORRECT TO THE BEST OF MY ABILITIES AND BELIEF.

Thomas M. Snezek
 THOMAS M. SNEZEK, R.L.S. #7051

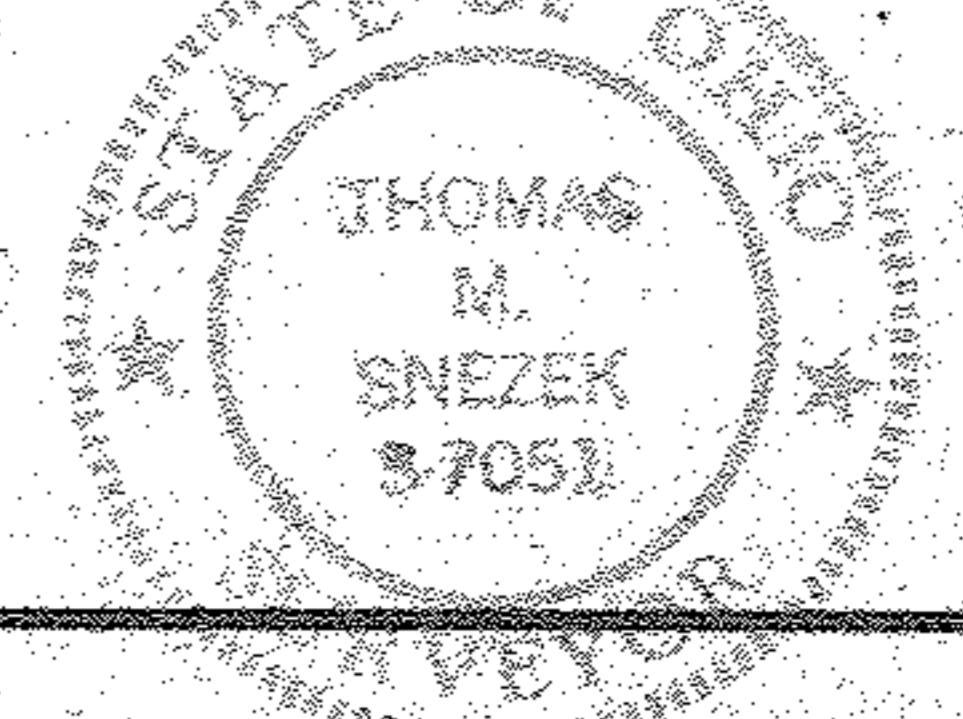

7-11-07
 DATE

7-16-07
 REV. ADD DRAINAGE ESMT
 PROJECT #0706 7/9/07

1602445
 LORAIN CO. M.P. 11111
 DATE 8-16-07
 21-10-000-000-046
 21-B
 BY UHAFeld
 #07-02113