P.P. NO.	06-23-004-102-002
SPLIT #	SURVEY
0	August 2007
MAP PAGE	06-22
SURVEYOR	Tom Simon

Scan 39790

DIMENSIONS SHOWN ON THIS PLAT ARE EXPRESSED IN FEET AND DECIMAL PARTS THEREOF, ALL BEARINGS ARE TO AN ASSUMED MERIDIAN AND ARE USED TO INDICATE ANGLES ONLY. PERMANENT MONUMENTS WERE FOUND OR SET AT ALL POINTS INDICATED HEREON, ALL OF WHICH I CERTIFY TO BE CORRECT.

THOMAS A. SIMON
REG. PROFESSIONAL SURVEYOR
NO. S-7775

BASIS OF BEARINGS IS THE CENTERLINE OF MURRAY RIDGE ROAD (NORTH 00°24'07" EAST). IRON PINS SET ARE 5/8" DIAMETER, 30" LONG WITH PLASTIC CAPS "T. SIMON, S-7775".

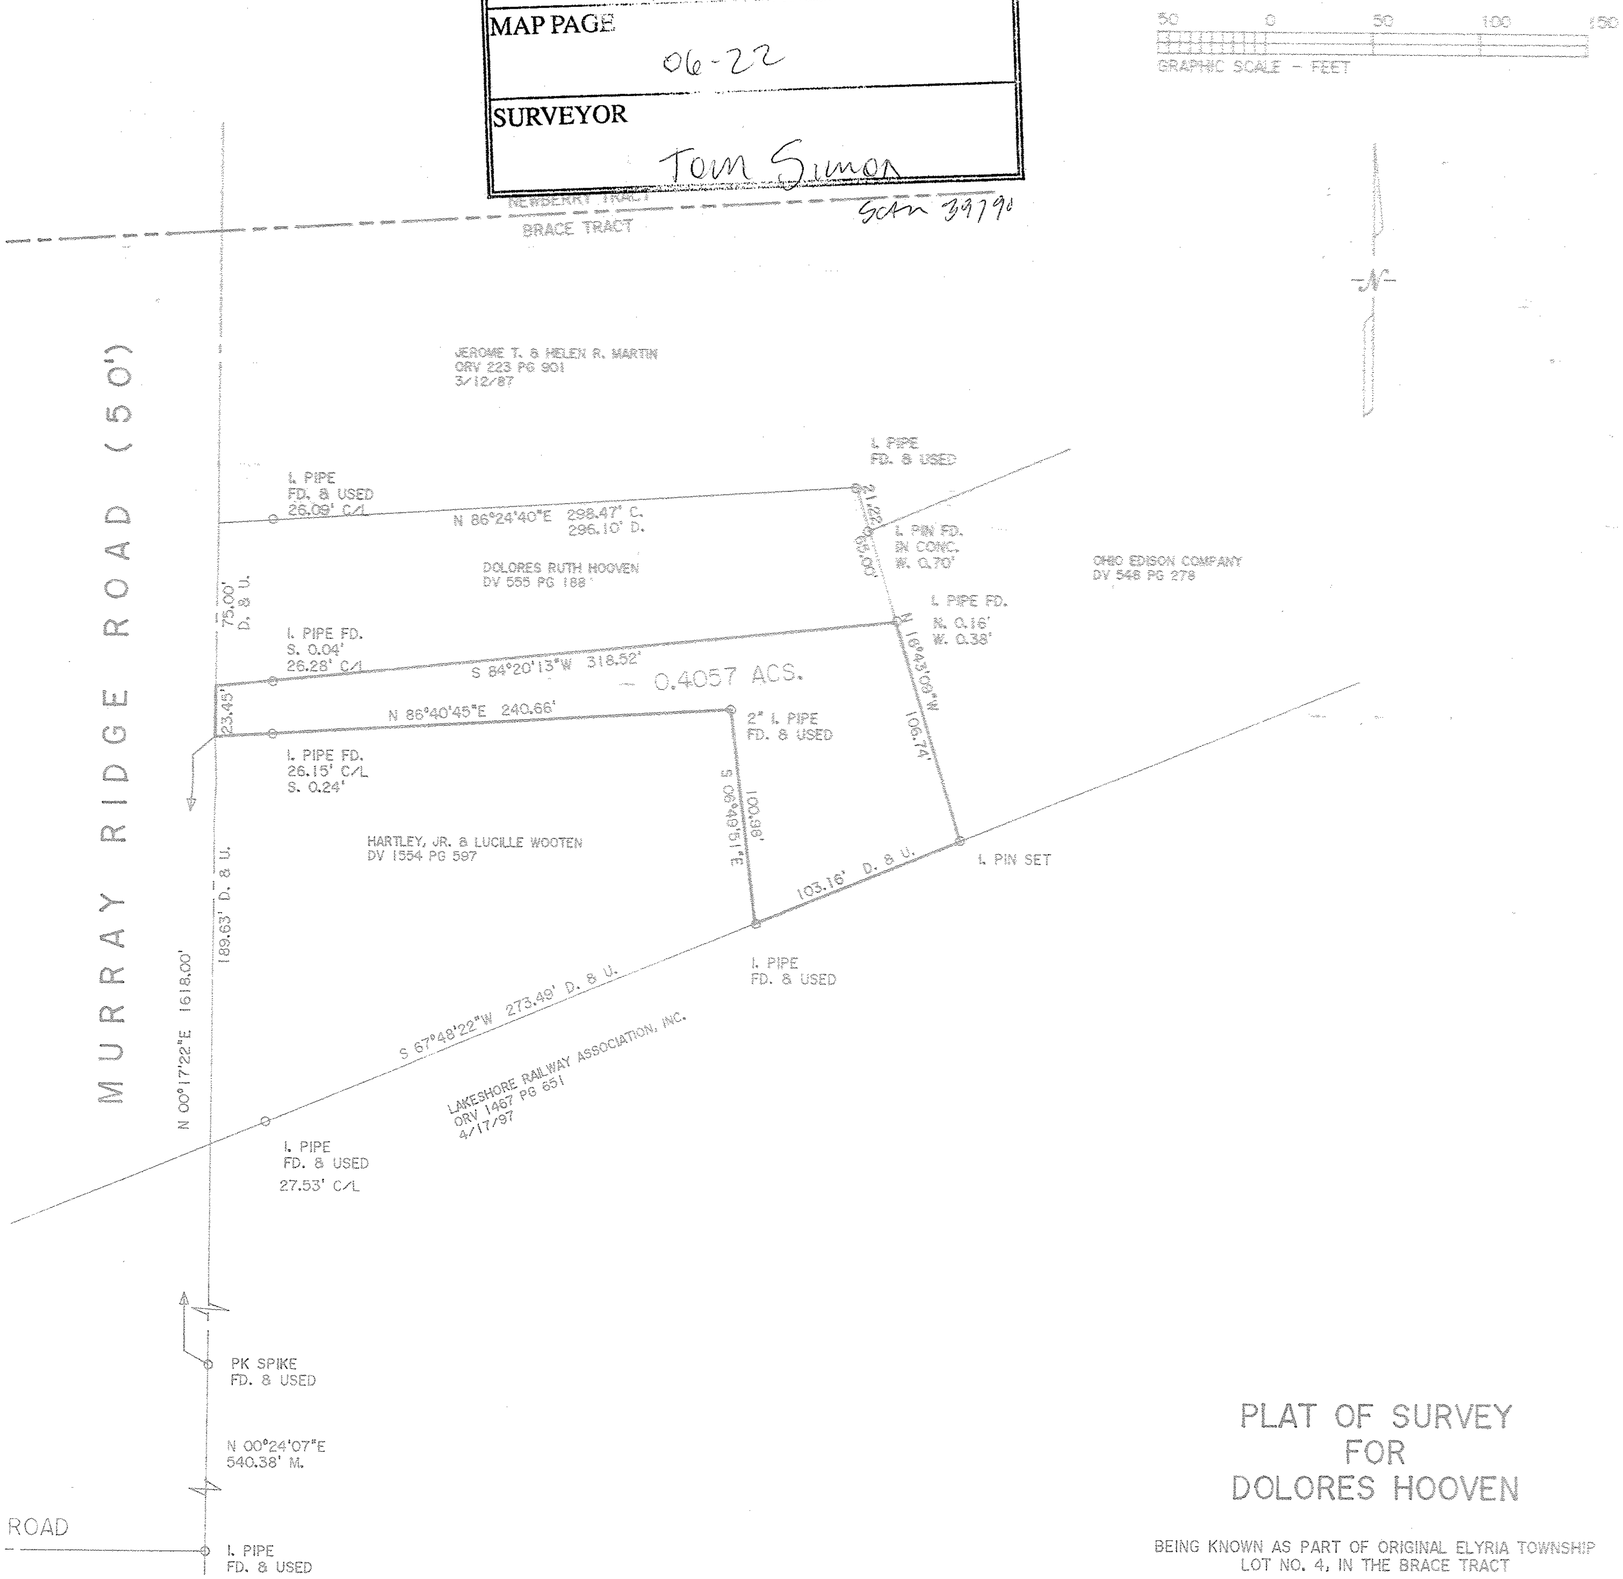

THOMAS SIMON & ASSOCIATES, INC.
PROFESSIONAL LAND SURVEYORS
150 SOUTH OLIVE STREET
ELYRIA, OHIO 44035
(440) 327-2825
FAX 327-2844

PLAT OF SURVEY FOR DOLORES HOOVEN

BEING KNOWN AS PART OF ORIGINAL ELYRIA TOWNSHIP LOT NO. 4, IN THE BRACE TRACT

COUNTY OF LORAIN STATE OF OHIO
AUGUST, 2007 SCALE: 1" = 50'

JOB NO. 2007-044