BOUNDARY SURVEY

for

MENTLER & THUNING

SITUATED IN THE CITY OF AVON, COUNTY OF LORAIN, STATE OF OHIO AND KNOWN AS BEING PART OF ORIGINAL AVON TOWNSHIP SECTION NUMBER 6.

P.P. NO. 04-00-010-117-038	
SPLIT # 06-01420-A	FIELD SURVEY 06-02-06
MAP PAGE 04-00-010-G	
SURVEYOR Christopher M. Hirzel	

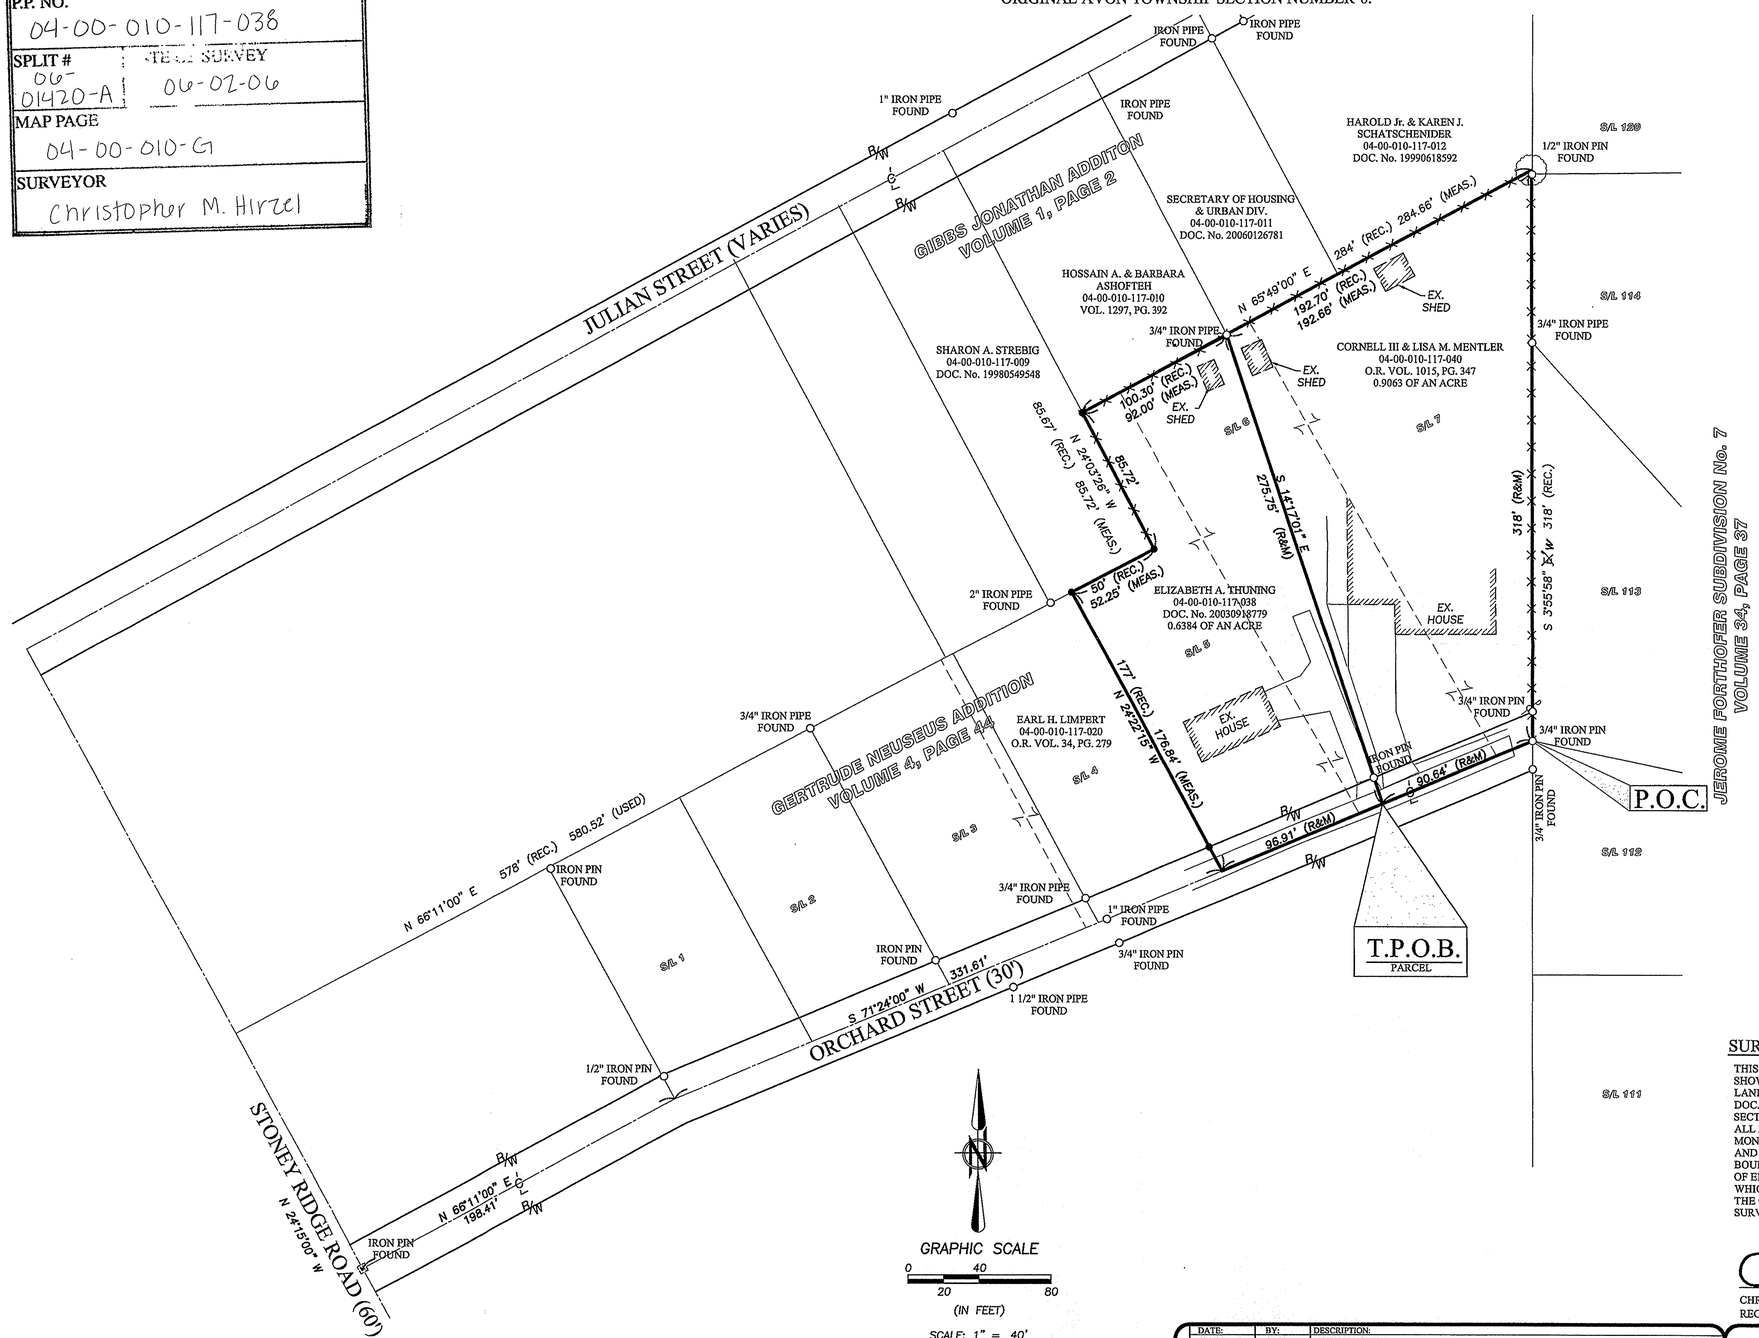

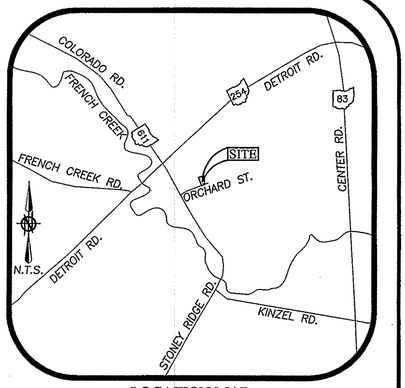

LOCATION MAP

LEGEND OF SYMBOLS AND LINETYPES

	CENTERLINE OF RIGHT-OF-WAY
○	IRON PIPE OR PIN FOUND AS INDICATED
●	5/8" IRON REBAR W/CAP STAMPED "BRAMHALL 8073" SET
○ M.N.F.	MASONRY NAIL FOUND
● M.N.S.	MASONRY NAIL SET
P.O.C.	POINT OF COMMENCEMENT
T.P.O.B.	TRUE PLACE OF BEGINNING
—x—	FENCE
(F) (FND.)	FOUND
(R) (REC.)	RECORD
(M) (MEAS.)	MEASURED
(C) (CALC.)	CALCULATED
R/W	RIGHT-OF-WAY LINE
[M]	MONUMENT BOX WITH IRON PIPE OR PIN FOUND AS INDICATED
	TREE

SURVEYOR'S CERTIFICATE:

THIS IS TO CERTIFY THAT, AT THE REQUEST OF THE OWNERS, I HAVE SURVEYED AND PLATTED THE BOUNDARY SURVEY AS SHOWN HEREON, SITUATED IN THE CITY OF AVON, COUNTY OF LORAIN, STATE OF OHIO AND KNOWN AS BEING A PARCEL OF LAND DESCRIBED IN A DEED TO CORNELL MENTLER & ELIZABETH A. THUNING AS RECORDED IN O.R. VOLUME 1015, PAGE 347 DOC. # 20030918779 OF THE LORAIN COUNTY DEED RECORDS, CONTAINING 1.5447 ACRES OF LAND IN ORIGINAL AVON TOWNSHIP SECTION NUMBER 6, BE THE SAME MORE OR LESS, BUT SUBJECT TO ALL LEGAL HIGHWAYS AND EASEMENTS OF RECORD. AT ALL POINTS THUSLY INDICATED ○ IRON PIN MONUMENTS WERE FOUND AND AT ALL POINTS THUSLY INDICATED ● IRON PIN MONUMENTS WERE SET. DISTANCES ARE SHOWN IN FEET AND DECIMAL PARTS THEREOF. BEARINGS SHOWN ARE ASSUMED AND USED TO DESCRIBE ANGLES ONLY. THE PLAN REPRESENTS A SURVEY IN WHICH A TRAVERSE OF THE EXTERIOR BOUNDARIES OF THE TRACT AND EACH BLOCK COMPUTED FROM FIELD MEASUREMENTS OF GROUND CLOSED WITHIN A LIMIT OF ERROR OF ONE (1) FOOT TO TEN THOUSAND (10,000) FEET OF THE PERIMETER BEFORE BALANCING THE SURVEY. ALL OF WHICH I CERTIFY TO BE CORRECT. THE SURVEY MEETS THE MINIMUM STANDARDS FOR LAND SURVEYS, IN SECTION 4733-37 OF THE OHIO ADMINISTRATIVE CODE AND ADJACENT PROPERTY DESCRIPTIONS HAVE BEEN CONSIDERED IN PERFORMING THIS SURVEY. ALL OF WHICH I CERTIFY TO BE CORRECT.

Christopher M. Hirzel — 06-02-06

STATE OF OHIO — CHRISTOPHER HIRZEL S-8081 — REGISTERED — PROFESSIONAL SURVEYOR

CHRISTOPHER M. HIRZEL, P.S.
REGISTERED SURVEYOR NO. 8081

DATE

BASIS OF BEARINGS:

A PORTION OF THE CENTERLINE OF ORCHARD STREET WHICH WAS ASSUMED TO BE SOUTH 71° 24' 00" WEST

AS SURVEYED IN MAY OF 2006

REVISION	DATE:	BY:	DESCRIPTION:
	6/01/06	CMH	ISSUED TO CLIENT

DRAWN BY: SJM

CHECKED BY: CMH

BRAMHALL
ENGINEERING AND SURVEYING CO., INC.
37307 HARVEST DRIVE AVON, OHIO 44011
(440) 934 - 7878 (440) 934 - 7879 FAX

SHEET 1 OF 1

JOB NO. 06-2319

J:\06231\9\DRAWINGS\DWG\MASTER.dwg