DANE A.HAPONEK
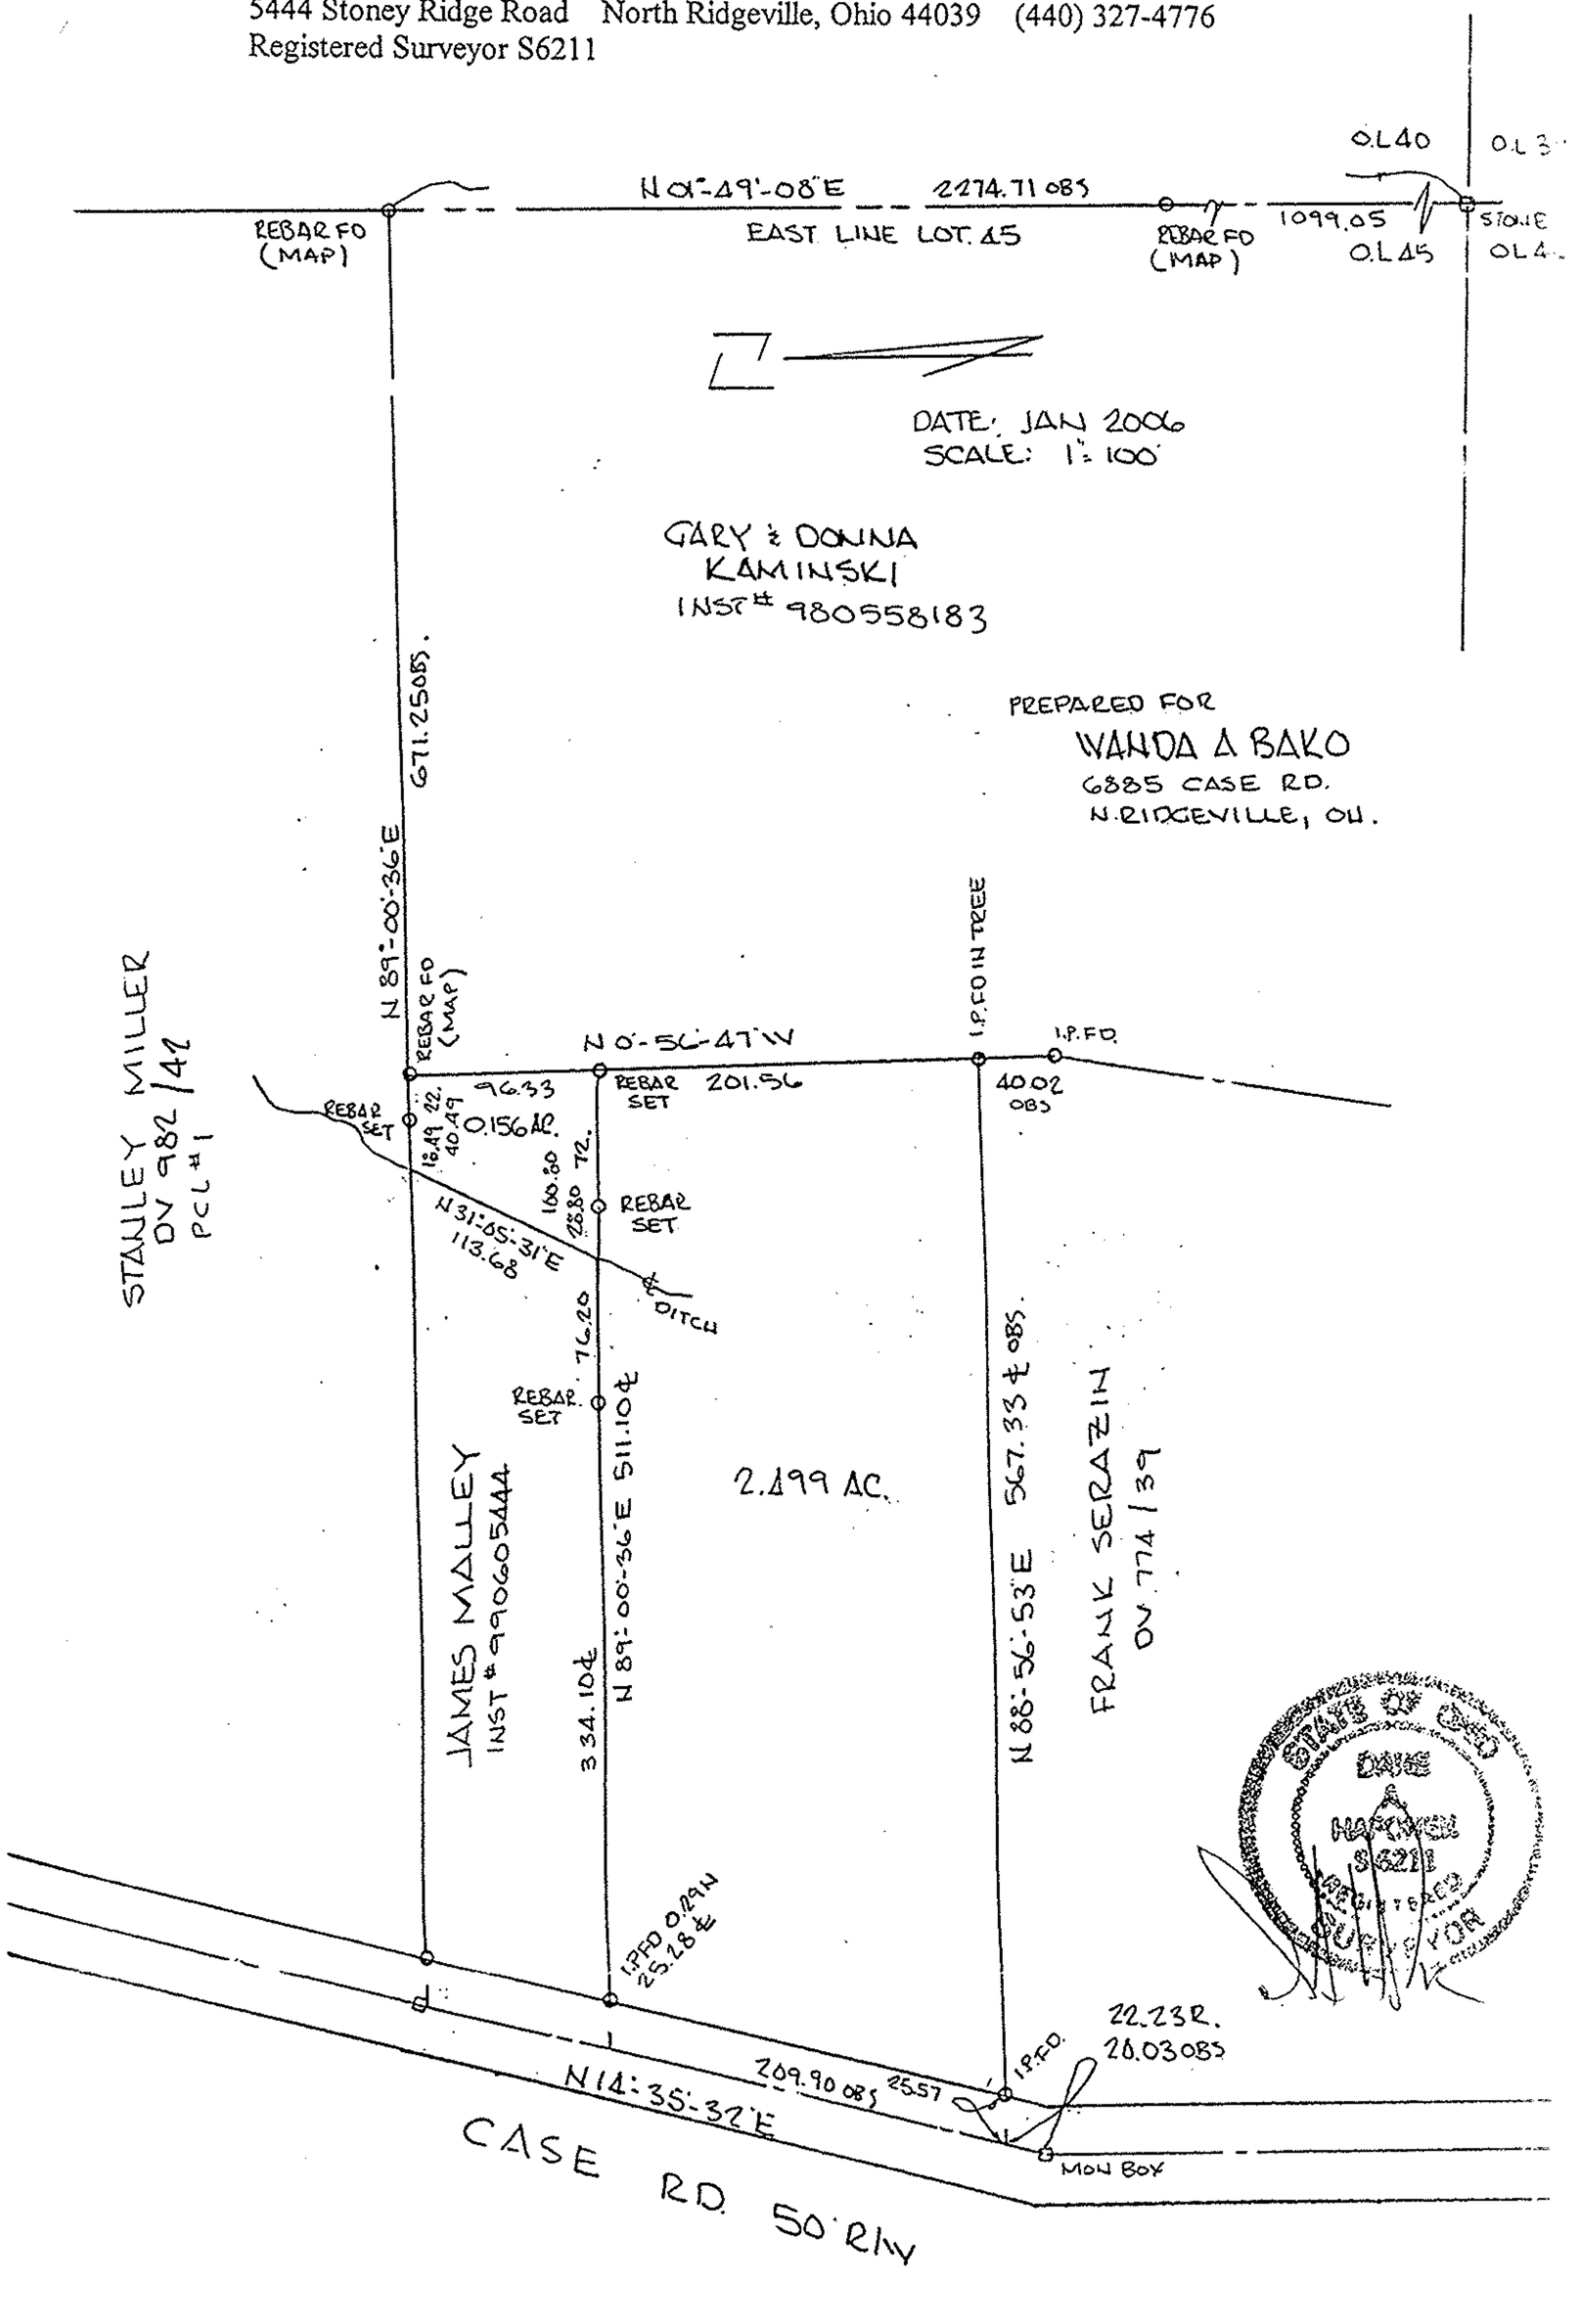
5444 Stoney Ridge Road North Ridgeville, Ohio 44039 (440) 327-4776
Registered Surveyor S6211