

NORTH

Assumed Bearing


Scale 1"=100'



Basis of bearings used centerline Bank Street N 24°53'00"W, deed of James Klein, Instrument of Transfer No. 1998-0565889.

LEGEND:

Iron Pipes, Rods shown as: o

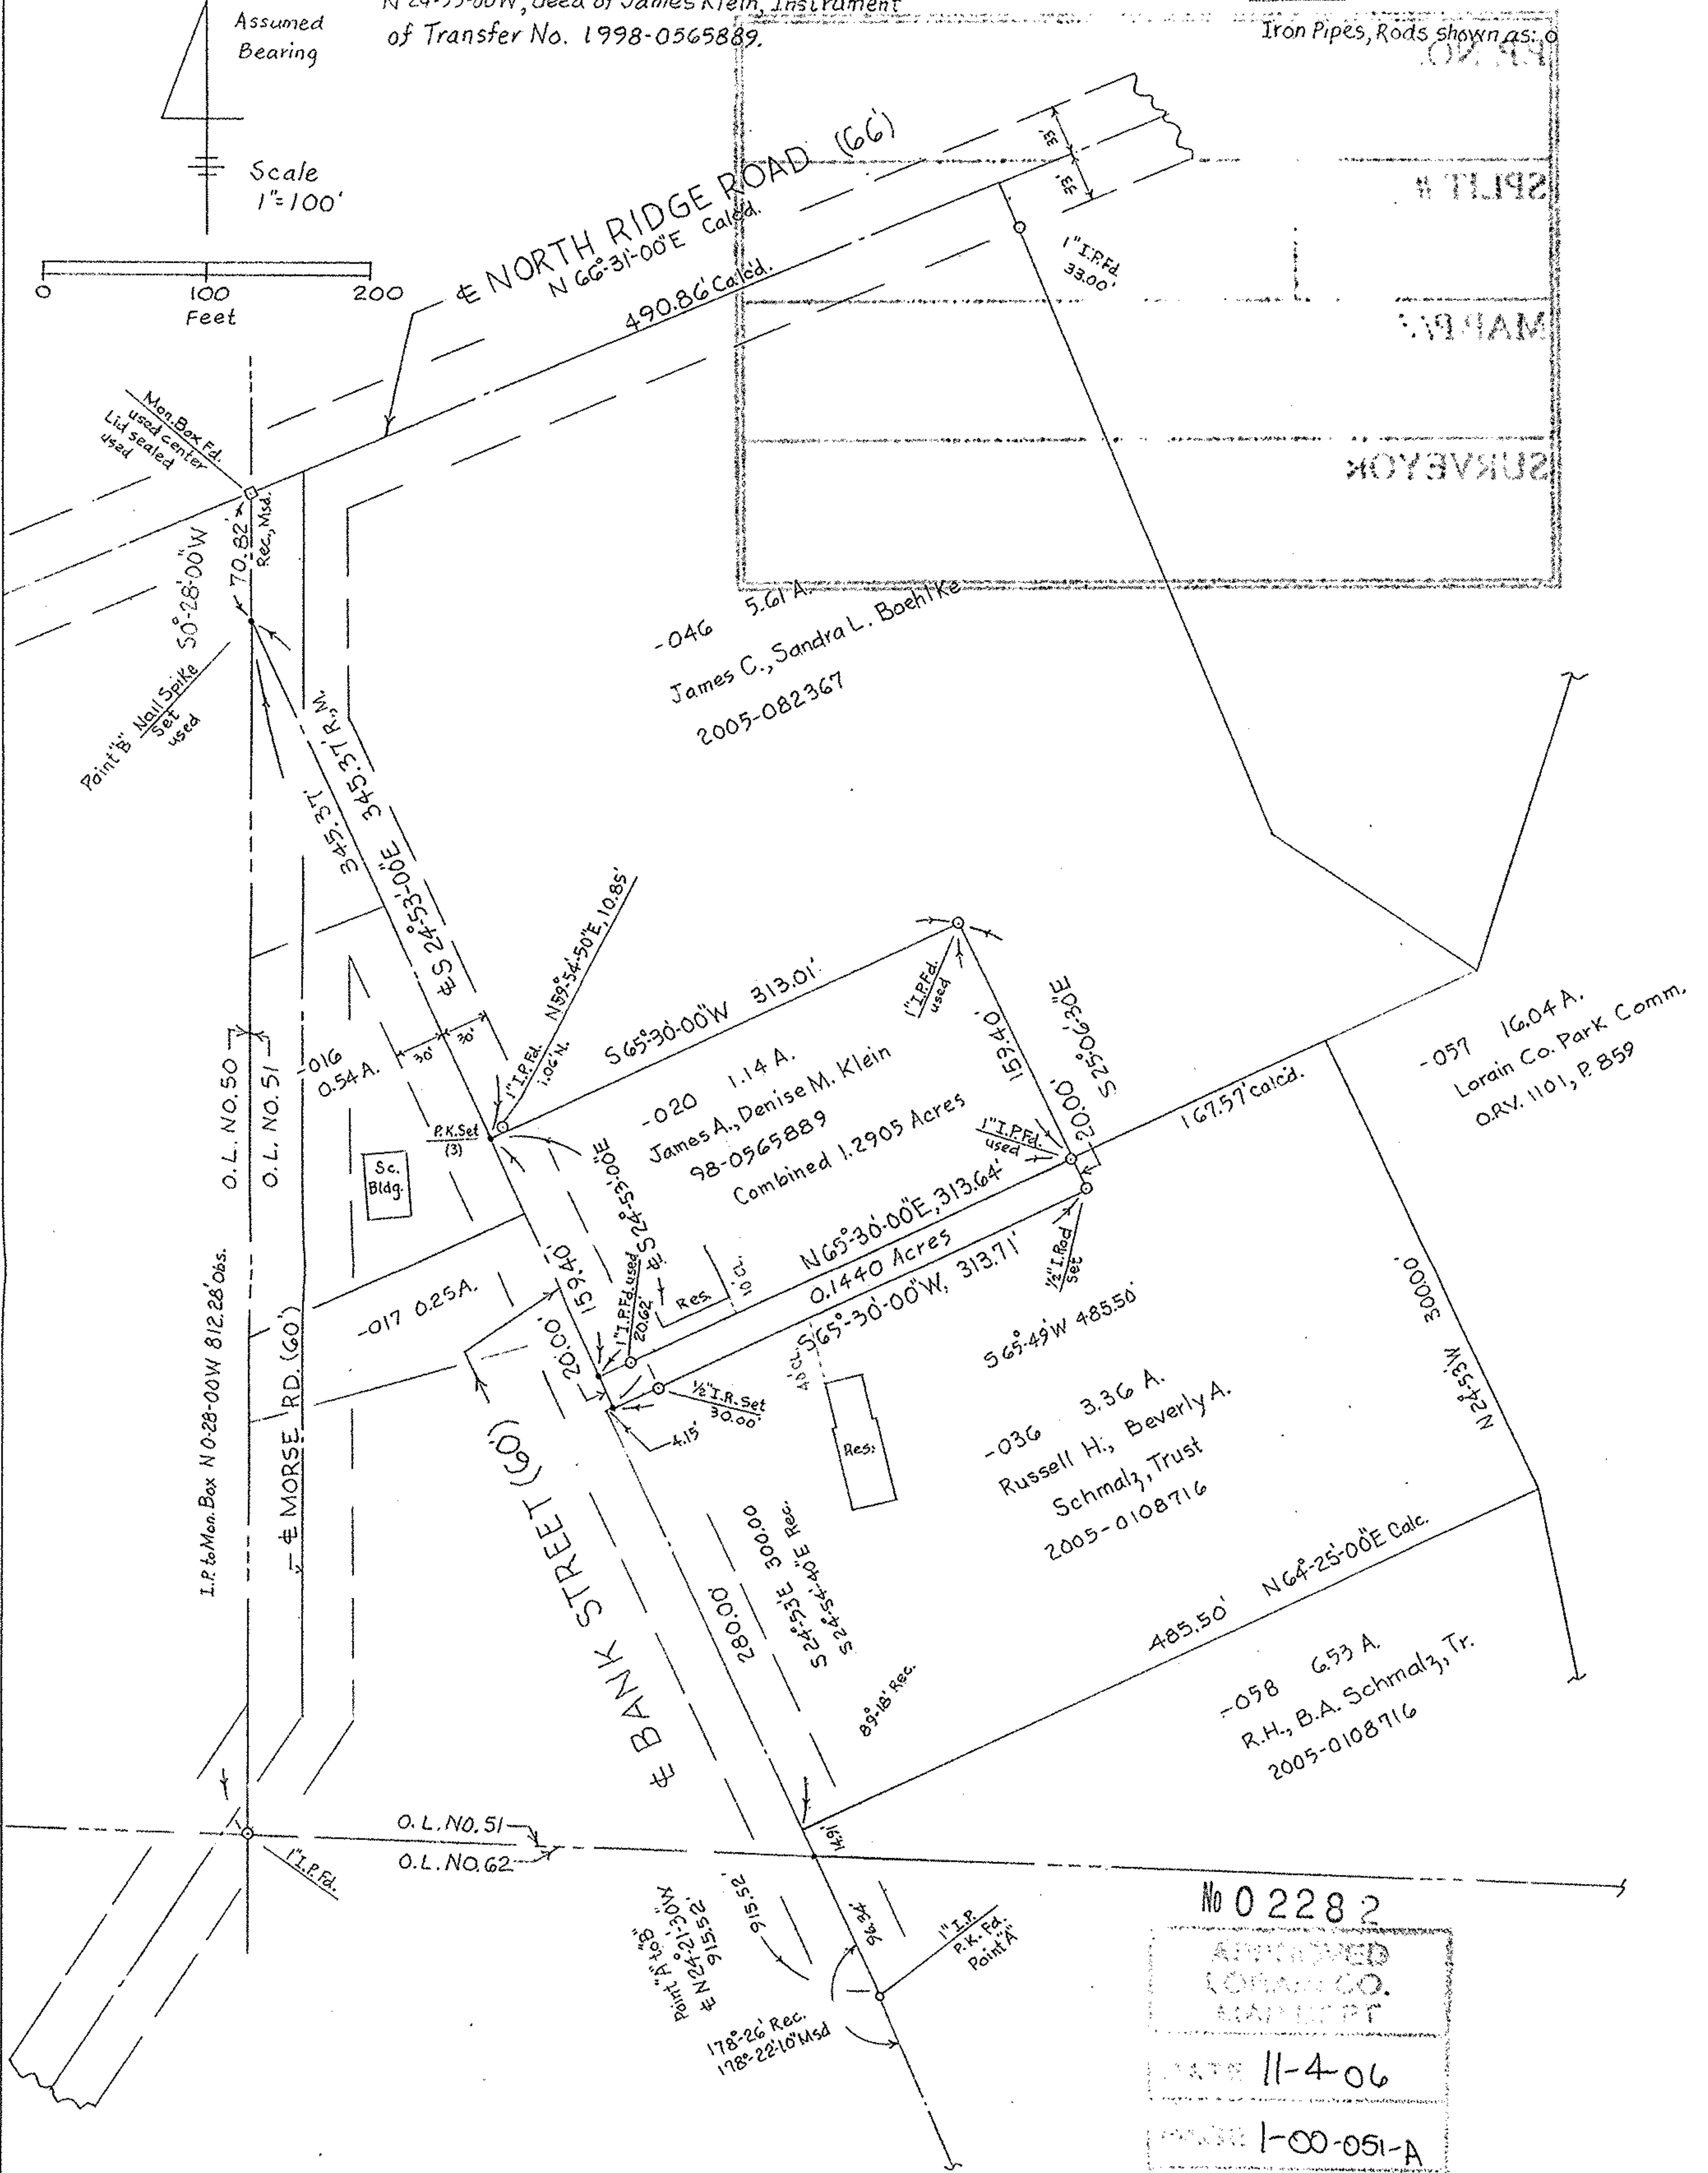

No 02282
APPROVED
DATE 11-4-06
BOOK 1-00-051-A
BY JHATFIELD
#06-02282

P.P.No. 01-00-051-000-036
01-00-051-000-020

Charles P. Waryu Sept 27, 2006
CHARLES P. WARYU,
Registered Surveyor No. 5029

MAP OF SURVEY MADE
SPLIT OF 0.1440 ACRES
PART OF ORIG. BROWNHELM
TWP. LOT 51, LORAIN CO., OHIO
For Russell Schmalz Sept. 2006