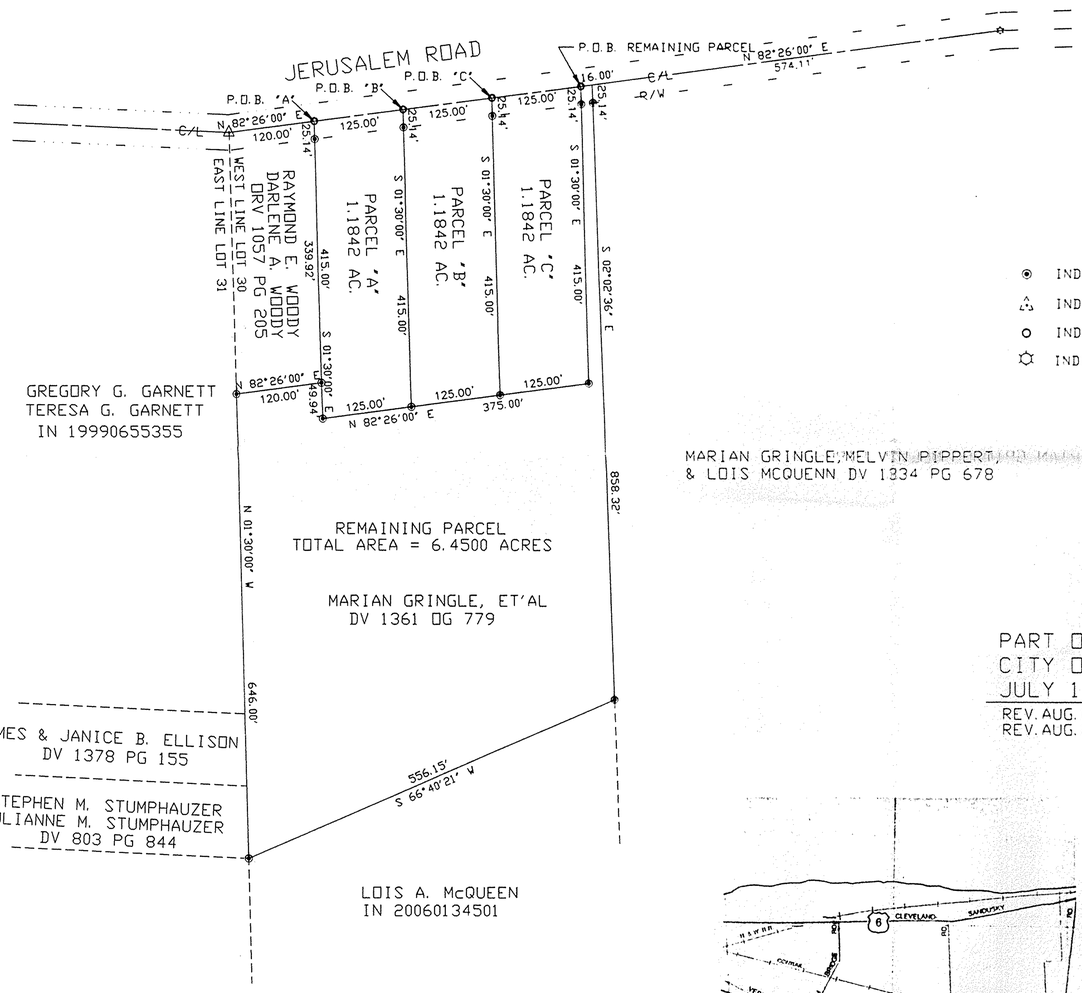

MARIAN GRINGLE, MELVIN PIPPERT, ET AL
& LOIS MCQUENN DV 1334 PG 678

LEGEND

- INDICATES 1/2" IRON PIN SET
- INDICATES RAILROAD SPIKE FOUND
- INDICATES PK NAIL SET
- INDICATES 1/2" IRON PIN FOUND

GRAPHIC SCALE

100 0 50 100 200 400

(IN FEET)
1 inch = 100 ft.

MAP OF SURVEY
FOR
MARIAN GRINGLE

PART ORIGINAL LOT 30 — BROWNHELM TOWNSHIP
CITY OF VERMILION — LORAIN COUNTY, OHIO
JULY 14, 2006 — SCALE 1"=100'

REV. AUG. 16, 2006
REV. AUG. 24, 2006

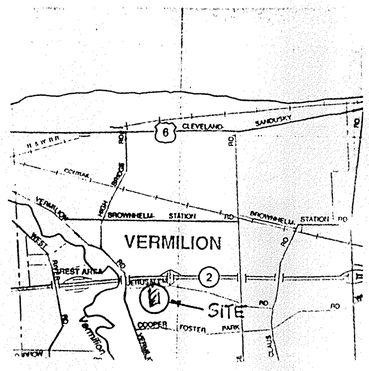

I HEREBY CERTIFY THE WITHIN TO BE A TRUE REPRESENTATION OF A SURVEY MADE BY ME. THE BEARINGS WERE BASED ON THE CENTERLINE OF JERUSALEM ROAD BEARING NORTH 82°26'00" EAST

Daniel E Hartung Jr.
DANIEL E. HARTUNG JR., PE, PS

STATE OF OHIO — DANIEL E. HARTUNG JR. — S-5667 — REGISTERED PROFESSIONAL LAND SURVEYOR

HARTUNG & ASSOCIATES
ENGINEERS & SURVEYORS
P.O. BOX 426, 421 WILLIAMS ST., HURON, OH 44839-0426
(419) 433-4321 FAX(419) 433-7879
DANIEL E. HARTUNG JR., PE, PS

#02269
11-20-06
1-00-030-A
JHatfield
#06-02269