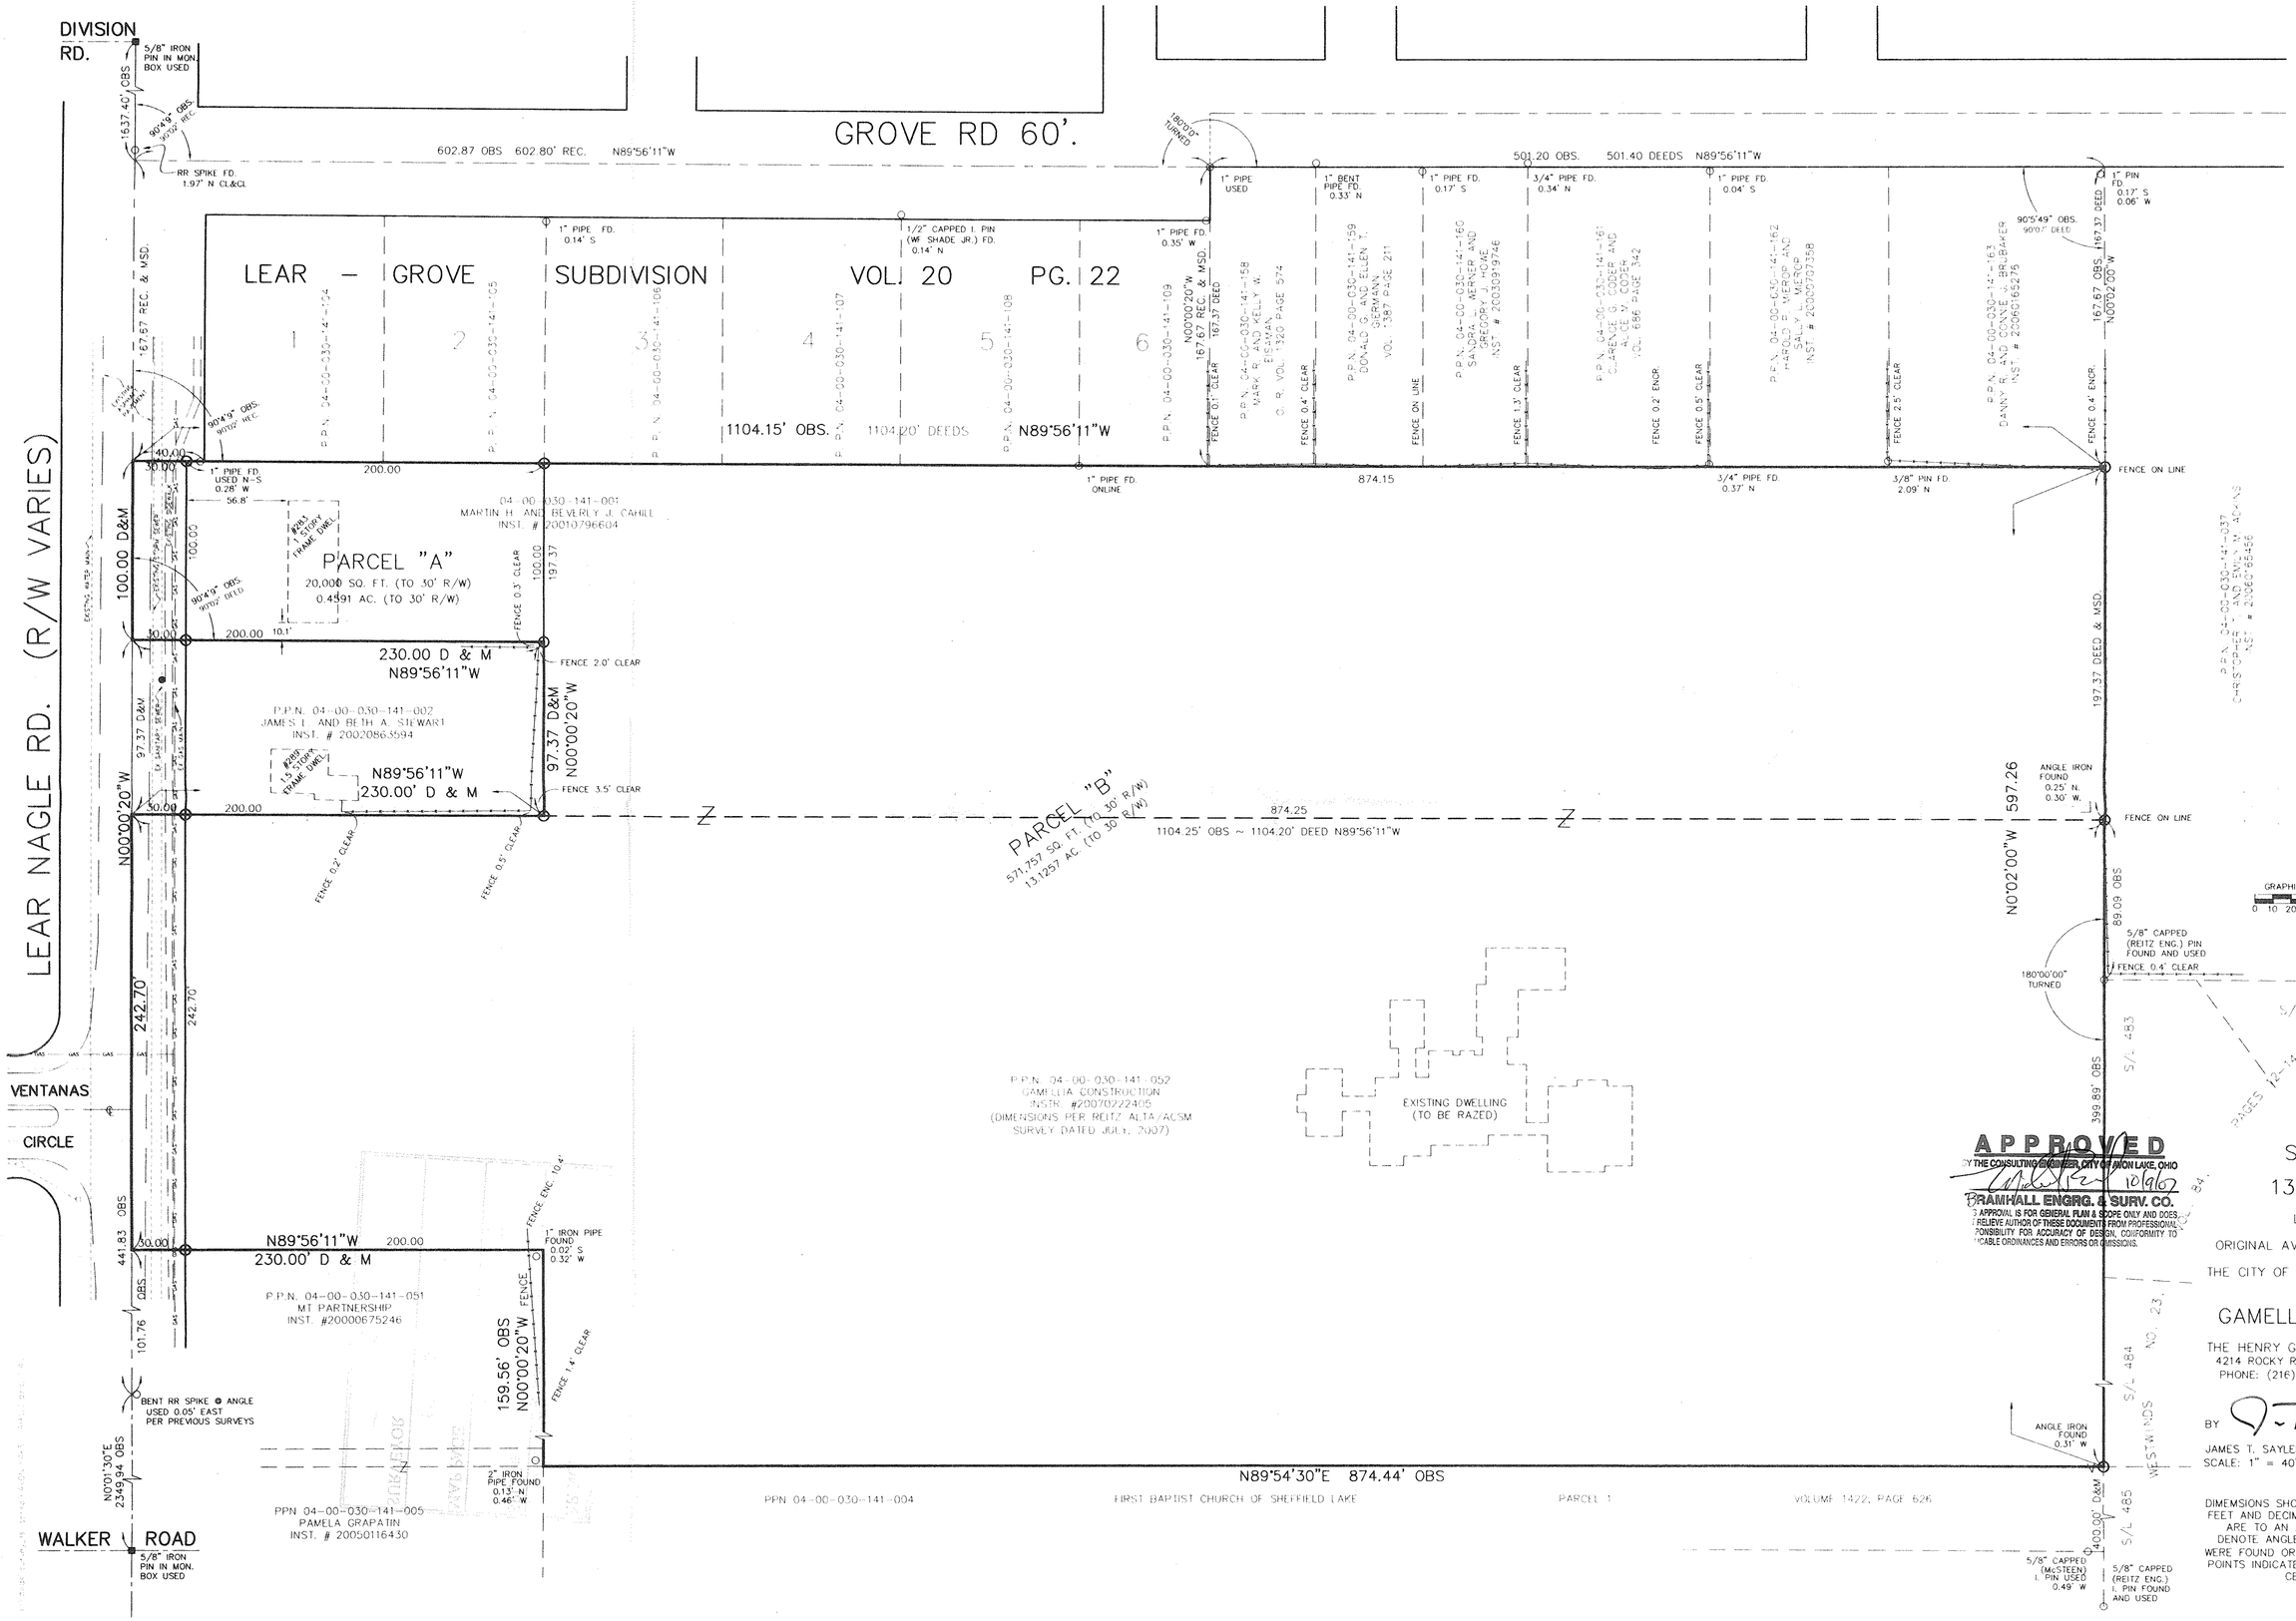

O DENOTES 5/8" CAPPED (REITZ ENG.) IRON PIN SET.

O MONUMENT FOUND AS NOTED.

SURVEY MAP

OF

13.8208 ACRES

ON

LEAR NAGLE ROAD

PART OF

ORIGINAL AVON TOWNSHIP SECTION NO. 30

NOW IN

THE CITY OF AVON LAKE, COUNTY OF LORAIN

STATE OF OHIO

FOR

GAMELLIA CONSTRUCTION

BY

THE HENRY G. REITZ ENGINEERING COMPANY
4214 ROCKY RIVER DRIVE, CLEVELAND, OH. 44135
PHONE: (216) 251-3033 FAX: (216) 251-5149

BY 10-5-07 V. PRES.

JAMES T. SAYLER, OHIO REG. SURVEYOR NO. S-7425

SCALE: 1" = 40'

AUGUST, 2007

REV. 9/14/2007

REV. 10/04/2007

DIMEMSIONS SHOWN ON THIS MAP ARE EXPRESSED IN FEET AND DECIMAL PARTS THEREOF. ALL BEARINGS ARE TO AN ASSUMED MERIDIAN AND USED TO DENOTE ANGLES ONLY. PERMANENT MONUMENTS WERE FOUND OR 5/8" CAPPED IRON PINS SET AT AT POINTS INDICATED ON THIS MAP, ALL OF WHICH WE CERTIFY TO BE CORRECT.

RECEIVED
OCT 0 8 2007
CITY OF AVON LAKE
ENG / PLAN DEPT.