
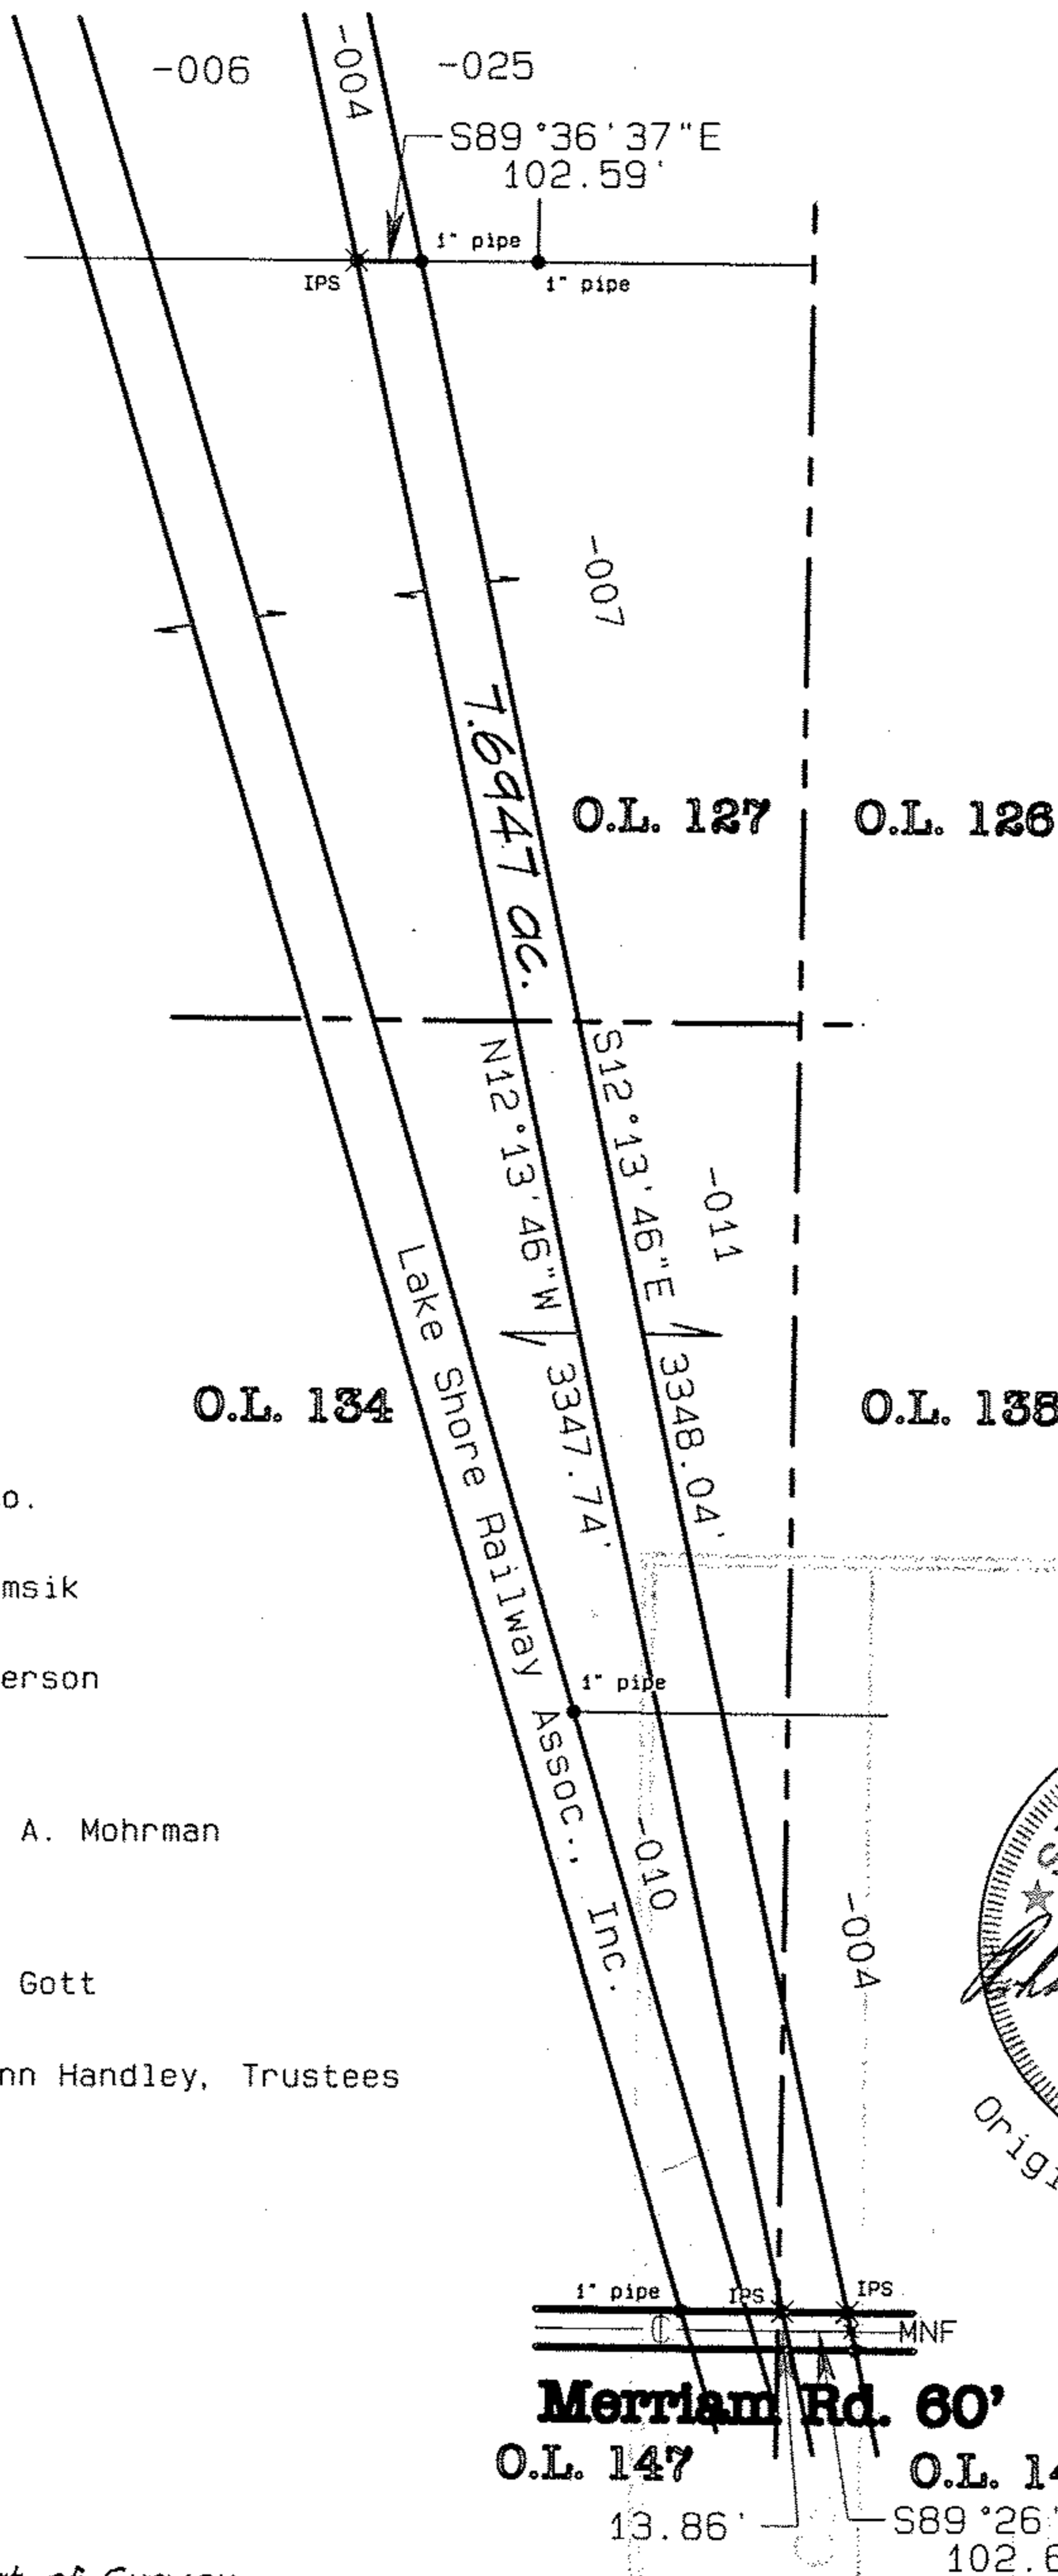


GRAPHIC SCALE 1"=400'

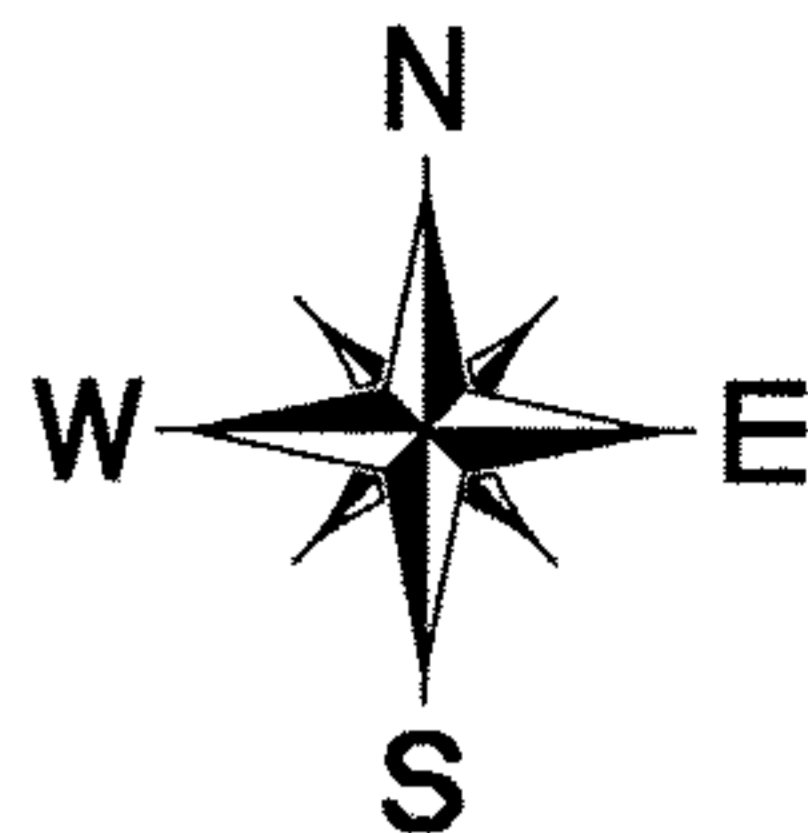

O.L. 114
 -004
 Babitt Investment Co.
 Doc. 20050057892
 -006
 Milton & Beverly Tomsik
 Doc. 20000676272
 -025
 Randall & Joyce Peterson
 O.R. 731 P. 561

O.L. 127
 -007
 Kenneth A. & Eloise A. Mohrman
 V. 1092 P. 506

O.L. 134
 -010
 David H. & Susan M. Gott
 Doc. 20010765168
 -011
 Ken W. & Kimberly Ann Handley, Trustees
 Doc. 20010796945



Pittsfield Twp. O.L. 127, 134, & 135
 Lorain Co. Ohio

O.L. 127: 2.8352 ac.
 O.L. 134: 4.1857 ac.
 O.L. 135: 0.6738 ac.