P.P. NO. (01-00-033-000-013, 002, 012)
(01-00-048-000-001, 002
01-00-033-000-057-060, 010016000006

SPLIT # 07-0360 JUL 4 2007

MAP PAGE 01-00-033-A

SURVEYOR Ronald Markhouse

39907

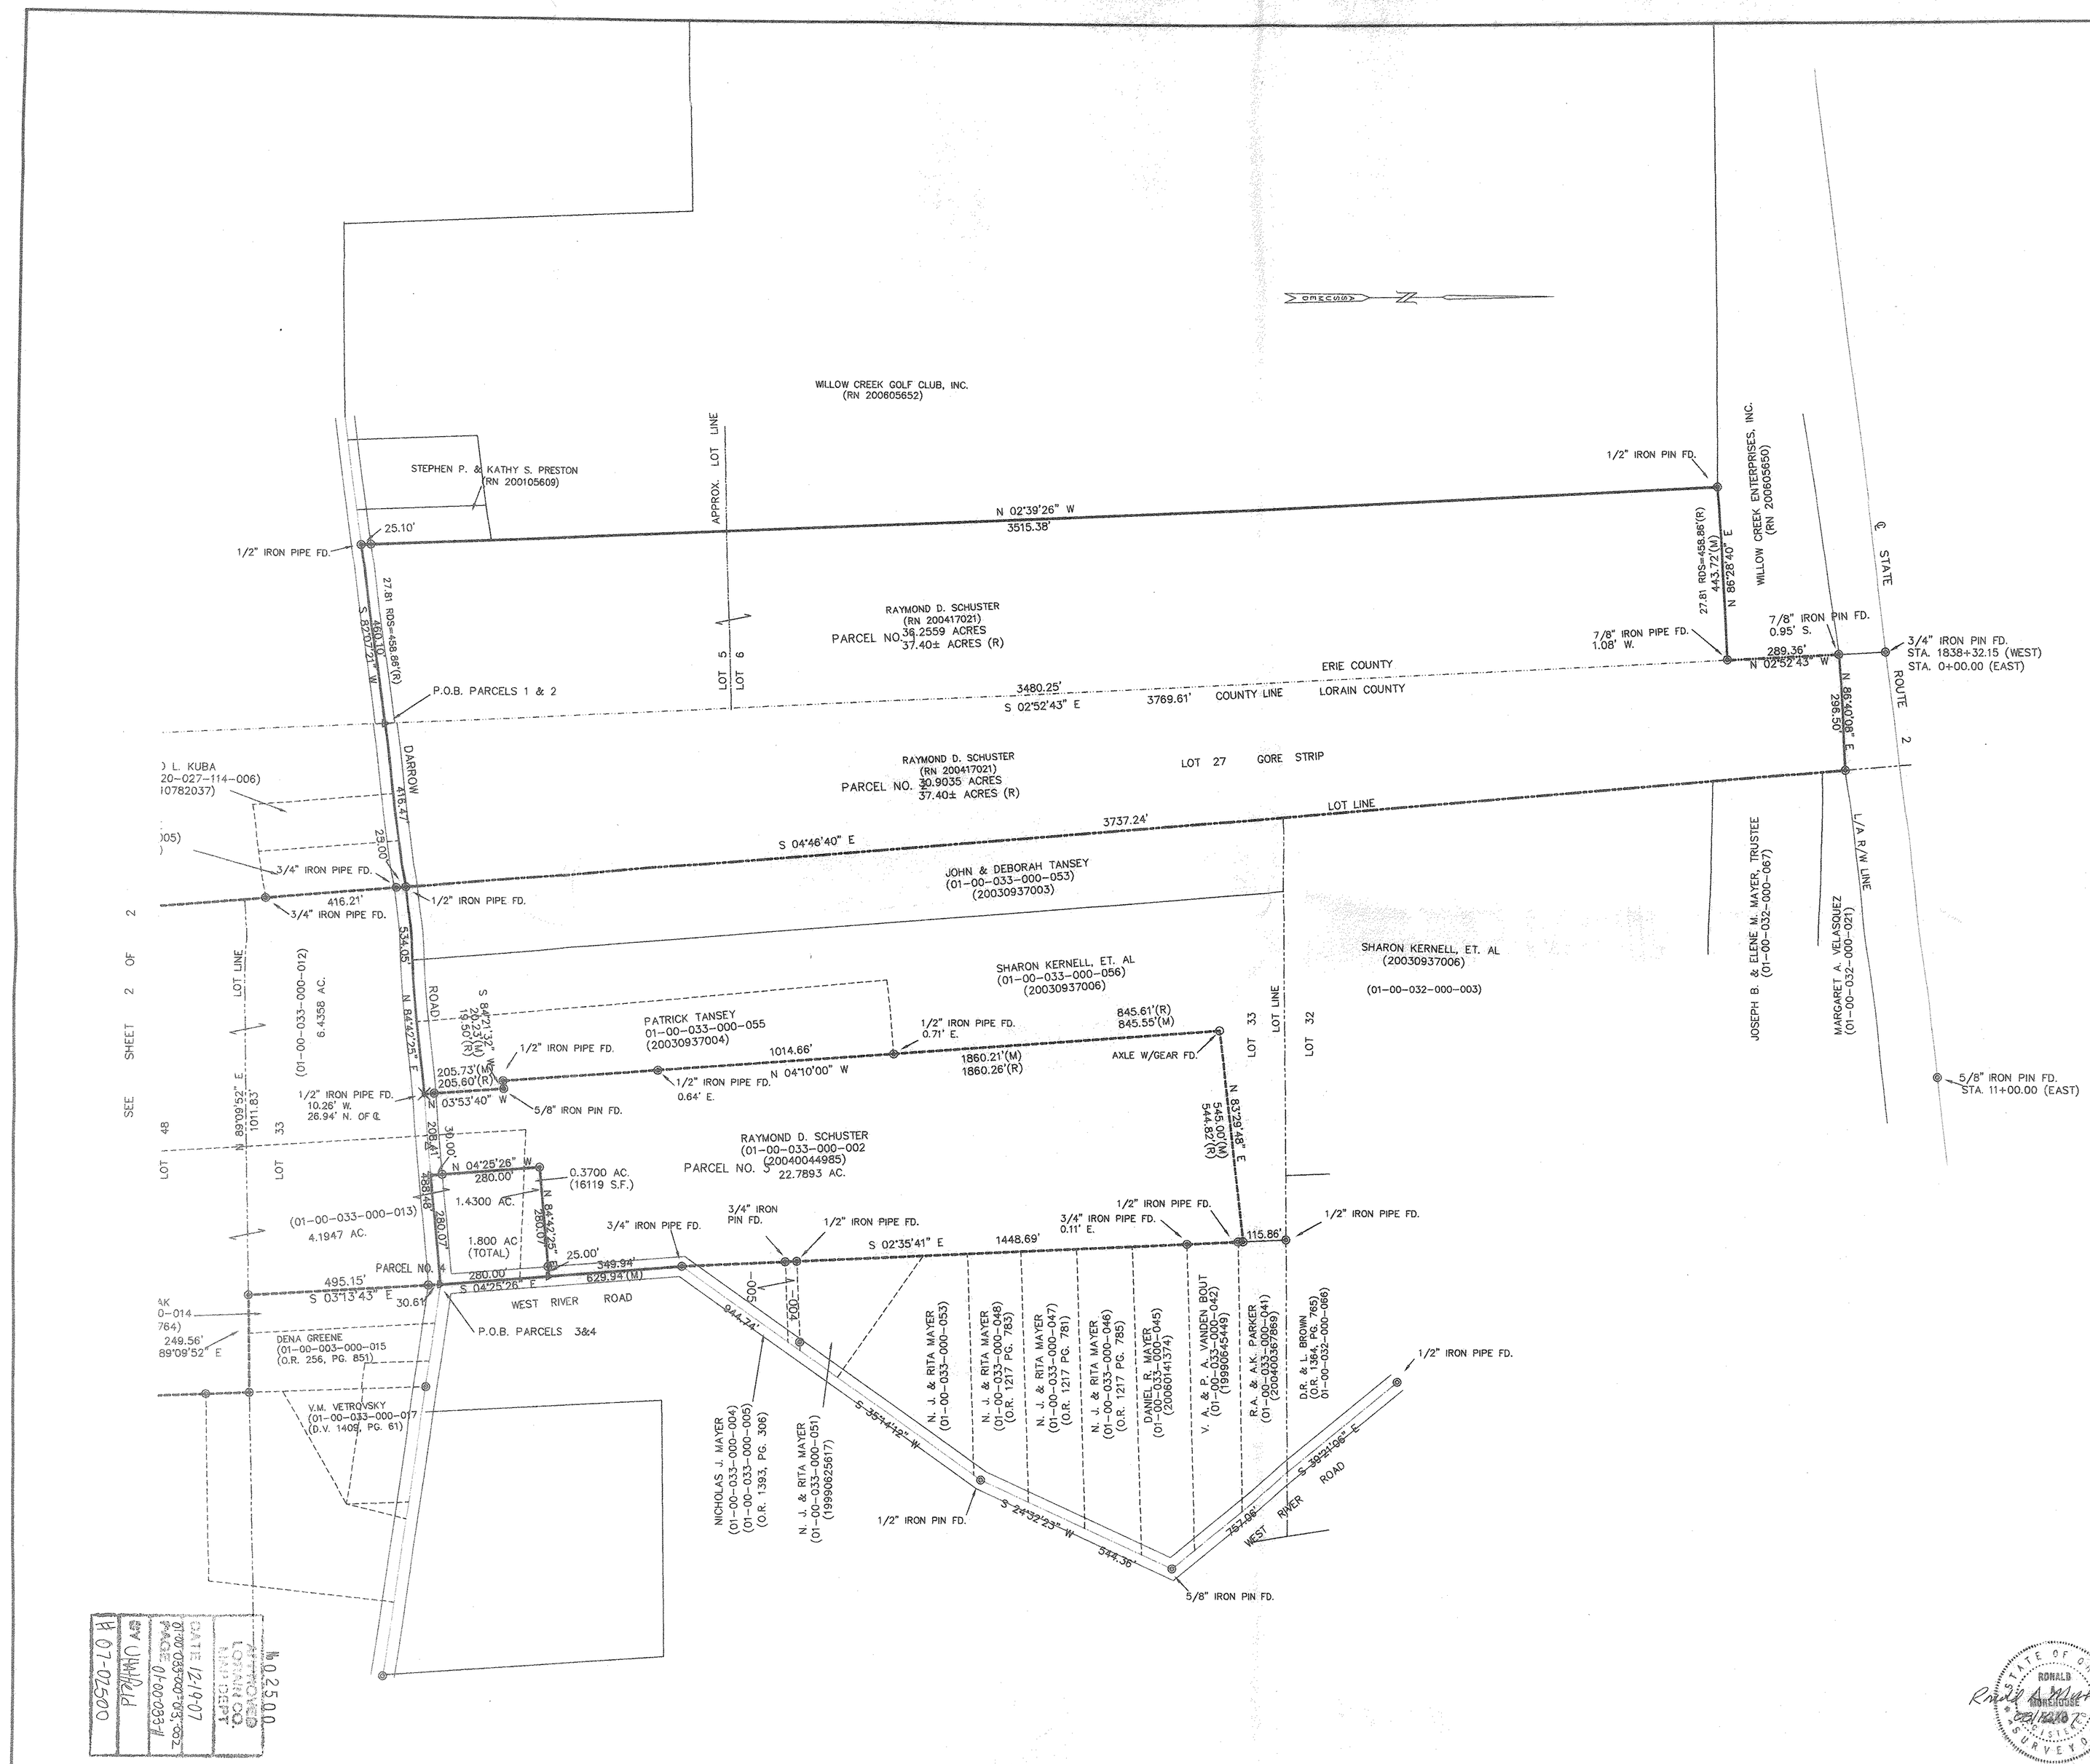

AREA SUMMARY

ERIE COUNTY (PTS. LOT 5 & 6)	36.2559 ACRES
LORAIN COUNTY (LOT 27 GORE)	30.9035 ACRES
LORAIN COUNTY (LOT 33 N. OF DARROW)	22.7891 ACRES
LORAIN COUNTY (LOT 33 COR. PARCEL)	1.8000 ACRES
LORAIN COUNTY (LOT 33 & LOT 48)	84.2579 ACRES
TOTAL AREA	176.0064 ACRES

ERIE COUNTY (PTS. LOT 5 & 6)	36.2559 ACRES
LORAIN COUNTY (LOT 27 GORE)	30.9035 ACRES
LORAIN COUNTY (LOT 33)	35.2197 ACRES
LORAIN COUNTY (LOT 48)	73.6273 ACRES
TOTAL AREA	176.0064 ACRES

LEGEND

- ◎ — IRON PIN/PIPE FOUND
- △ — P.K. NAIL FOUND
- ○ — R.R. SPIKE FOUND
- □ — MONUMENT BOX
- ✧ — DRILL HOLE FOUND
- ◉ — 5/8" IRON PIN W/ CAP SET
- ▲ — MAG. NAIL SET
- ● — R.R. SPIKE SET
- + — DRILL HOLE SET
- M — MEASURED
- R — RECORDED
- C — CALCULATED

Plat of Survey
For

Raymond Schuster, Estate

Being a Part of Lots 5 & 6,
Section 1, Vermilion Township,
Erie County, Ohio
&
Being a Part of Lot 27, Gore Strip,
& Part of Lots 33 and 48,
Brownhelm Township,
Lorain County, Ohio

July, 2007 *Scale: 1"=200'*

200 0 200 400

E.O.C. 1:10000

STATE OF OHIO RONALD MARKHOUSE REGISTERED PROFESSIONAL SURVEYOR

Ronald A. Markhouse 7/24/2007

(419) 663-0855

REV. AUG. 15, 2007 SHEET 1 OF 2

BAHAROGLU & ASSOCIATES, INC.
CONSULTING ENGINEERS & SURVEYORS
(419) 663-0855 NORWALK, OHIO

SCALE:	DATE:	CK'D. BY:	PROJECT NO.
1"=200'	JULY, 2007	RAM	34096
	DR. BY: RAM	REV'D BY:	