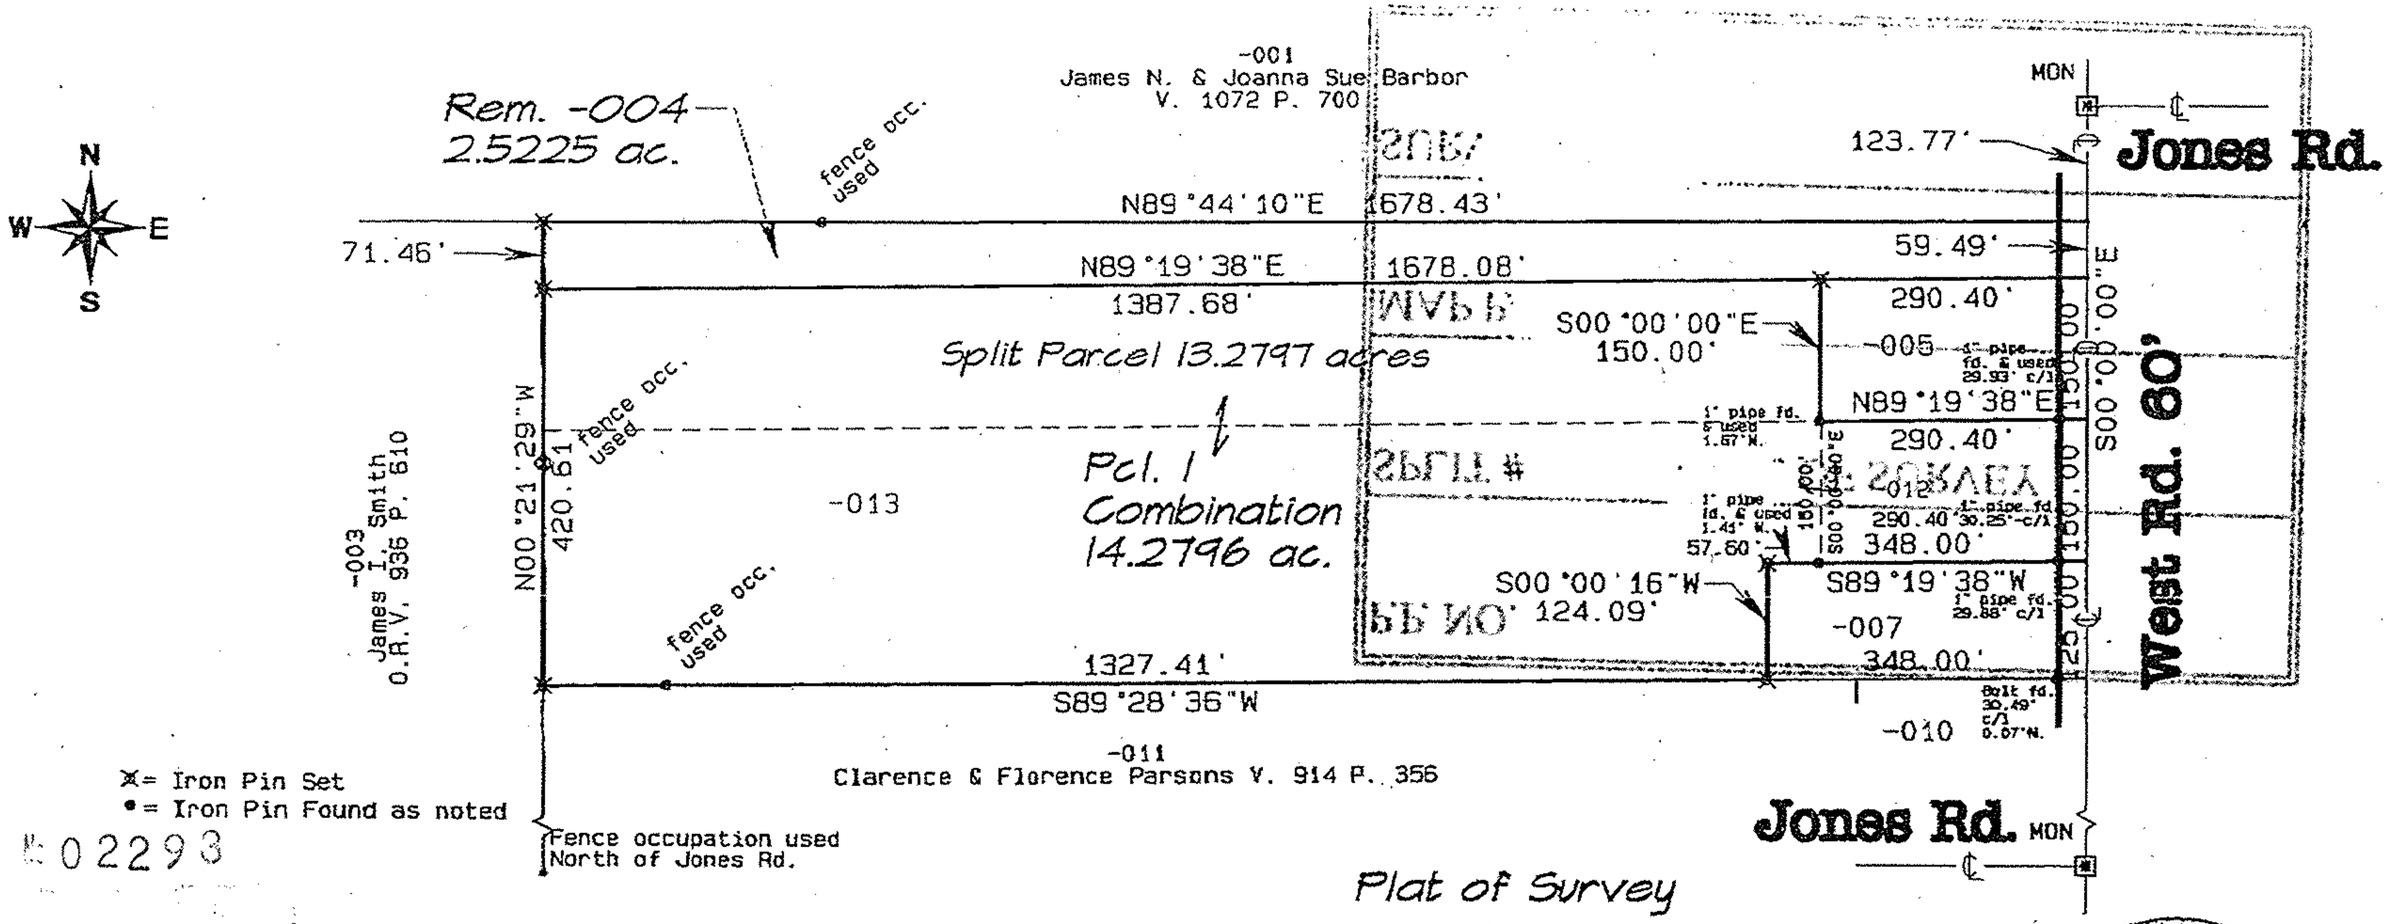

⊠= Iron Pin Set
•= Iron Pin Found as noted

Fence occupation used
North of Jones Rd.

K 02293

12-18-06

18-H

JHatfield

#06-02293

-005 Mary L. Barbor Doc. 20050070127

-007 Lisa M. Barbor Doc. 20010749537

-010 Paul H. & Phyliss J. Booth V. 993 P. 365

GRAPHIC SCALE 1"=200'

0 200 400 600

Plat of Survey

for

Dwight Rice

Wellington Twp. O.L. 2
Lorain Co. Ohio

Carlson Surveys October 2006

Job: 1801-30R

Rev. 12-13-06 Reginal Planning comments

STATE OF OHIO
RICHARD D CARLSON
7496
REGISTERED SURVEYOR
Richard D. Carlson PS

Original seal in red ink.
12-13-06