R:\04000\04087-B\LDDT\CONTROL\DWG\0-SPLIT02.dwg 1/14/2008 1:16:30 PM EST

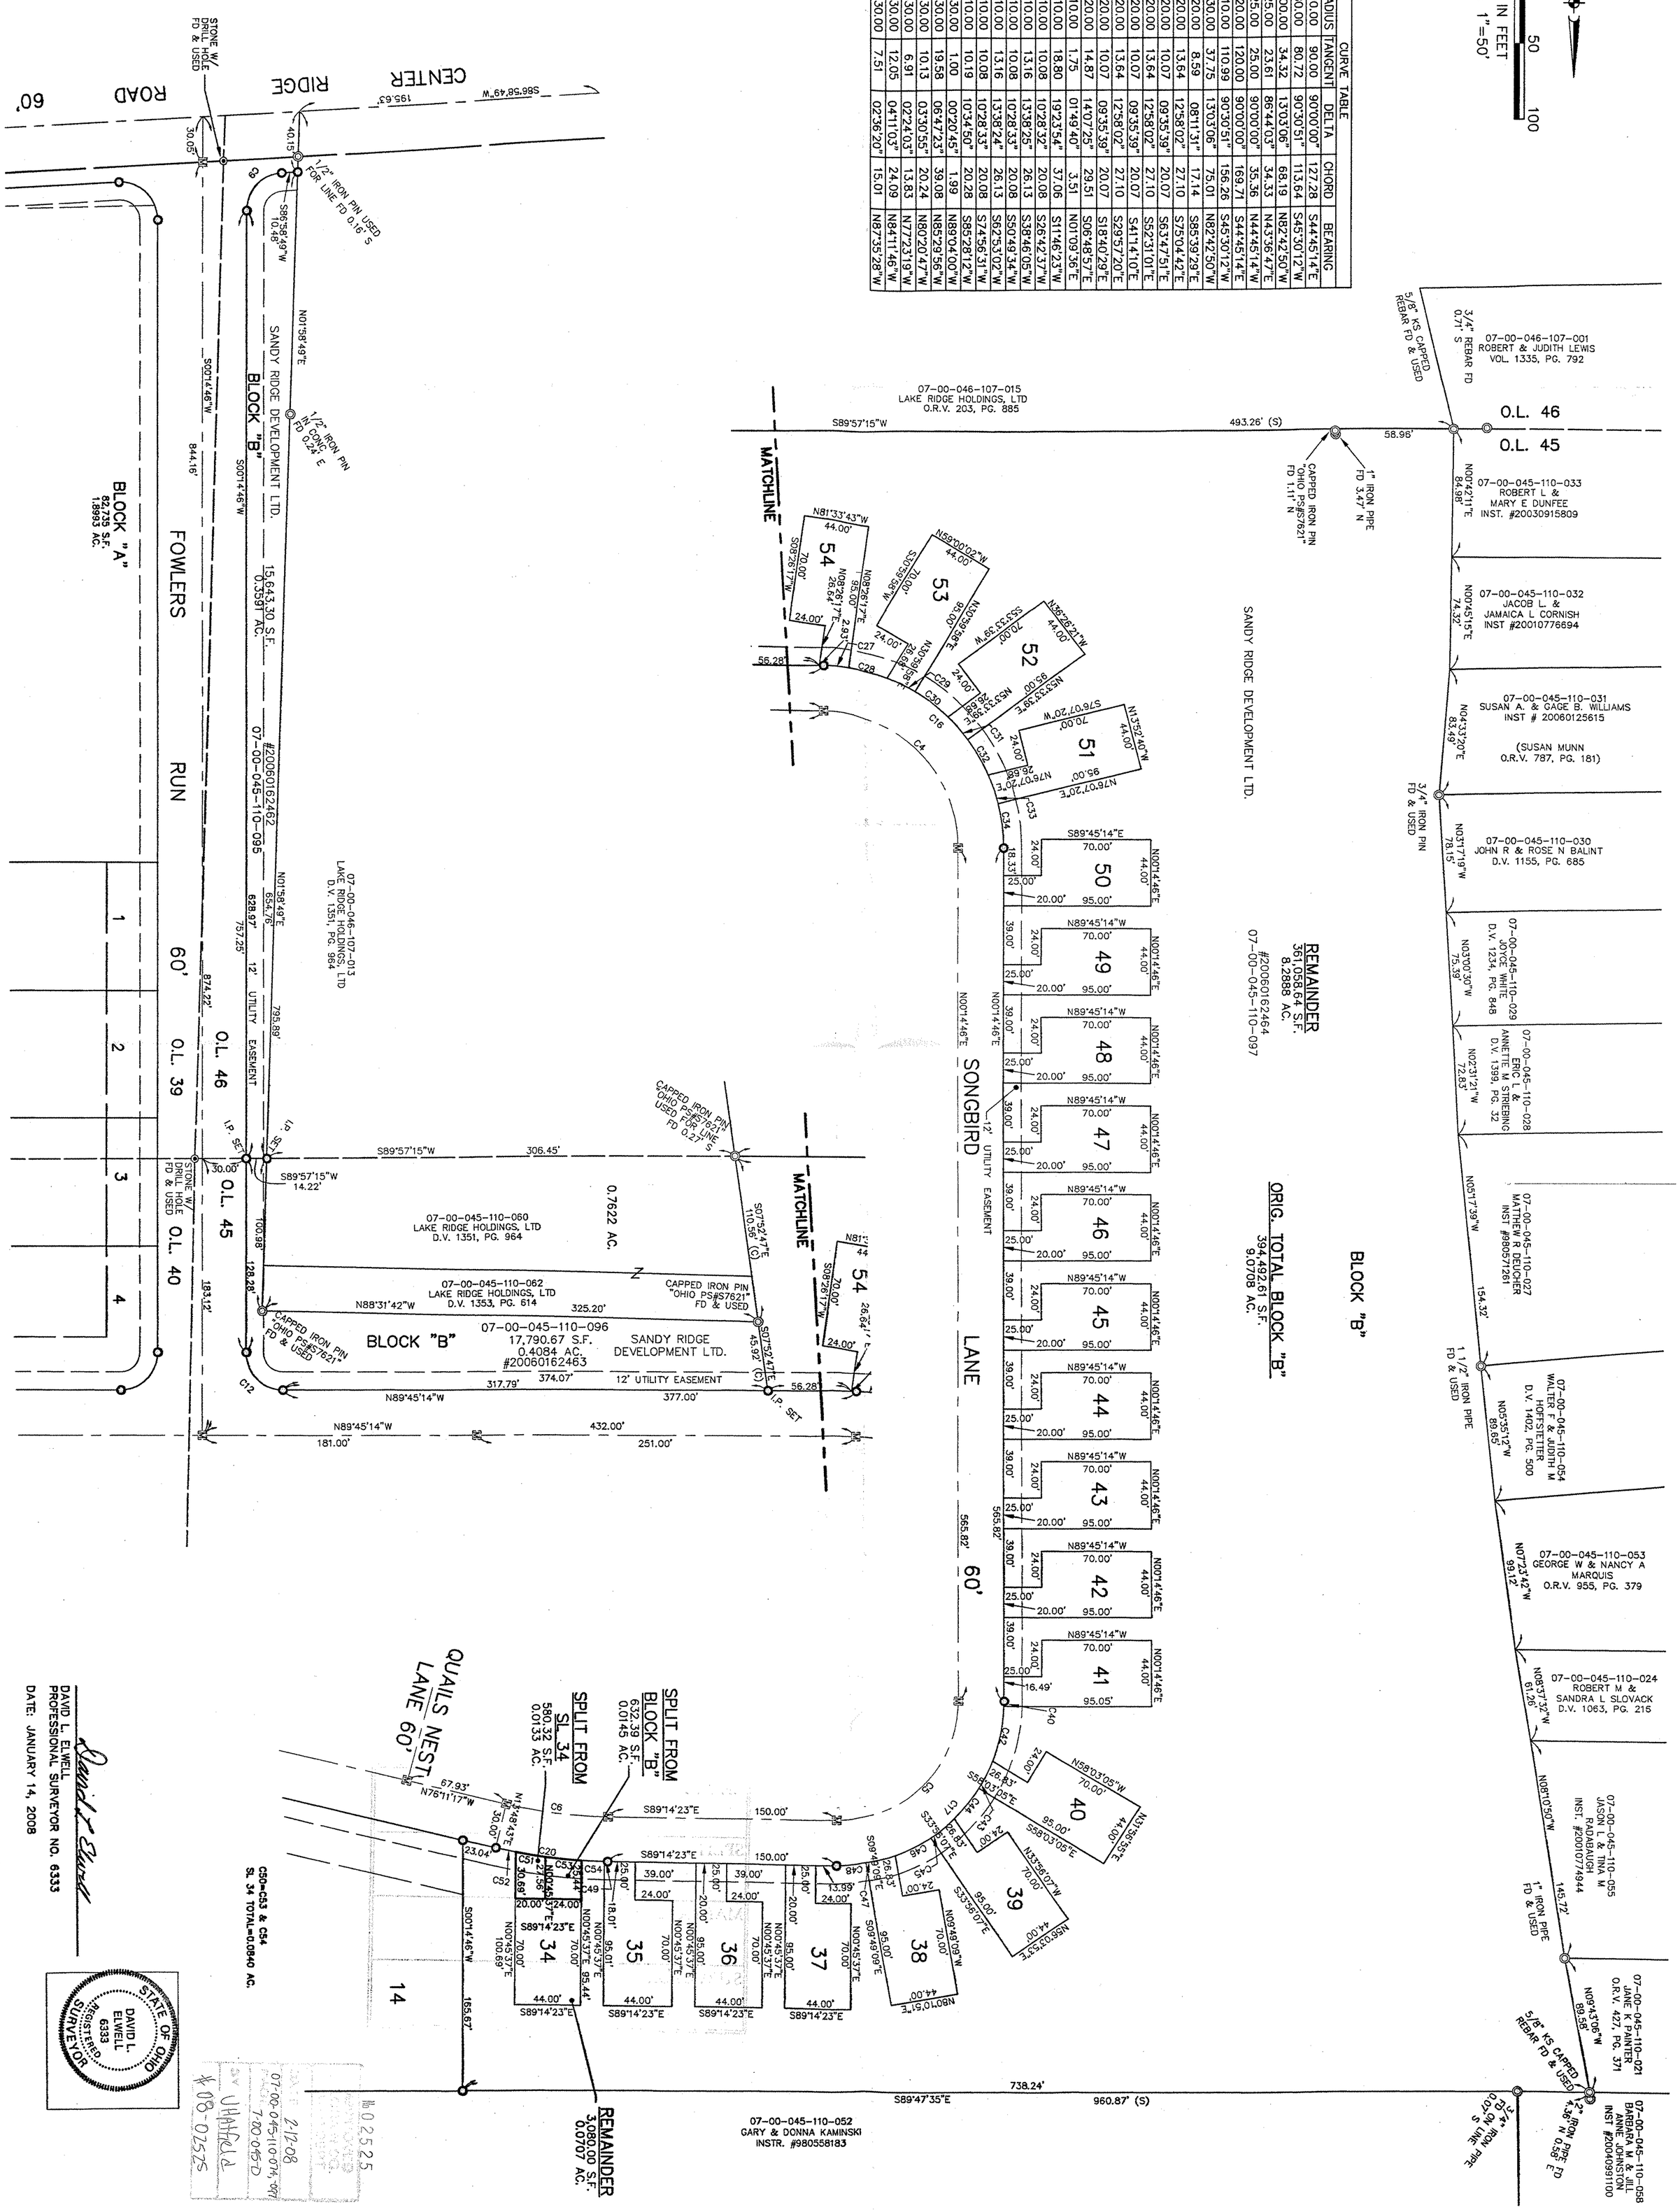

SHEET	OF	JOB NO.
1	1	04087-B2

BOUNDARY SURVEY AND SPLIT MAP
BLOCK "B" & SUBLOT 34
SANDY RIDGE SUBDIVISION NO. 1

P.V. 87 P. 1-4

PART OF ORIGINAL RIDGEVILLE TOWNSHIP LOT NOS. 45, 46

CITY OF NORTH RIDGEVILLE COUNTY OF LORAIN STATE OF OHIO

KS ASSOCIATES

KS Associates, Inc.
260 Burns Road, Suite 100
Elyria, OH 44035
P 440 365 4730
F 440 365 4790
www.ksassociates.com

DATE: 1-14-08
DRAWN BY: BAJ
CH'D BY:
DWG. NAME: 0-SPLIT02
PATH: R:\04087-B\LDDT\CONTROL
F.B.

REVISIONS

DATE	DESCRIPTION	BY
1-14-08	SPLIT OF BLOCK "B" AND SUBLOT 34	