Noonan Property

City of Elyria ~ County of Lorain ~ State of Ohio
Part of Original Elyria Township Lot No. 12 in the Brace Tract

Part of Sublot No's 1, 2, & 3 of Interurban Allotment

P.P.N.'s 06-23-012-105-022, -023
O.R. Volume 929 Page 758

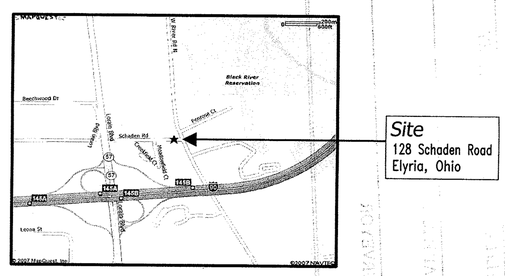

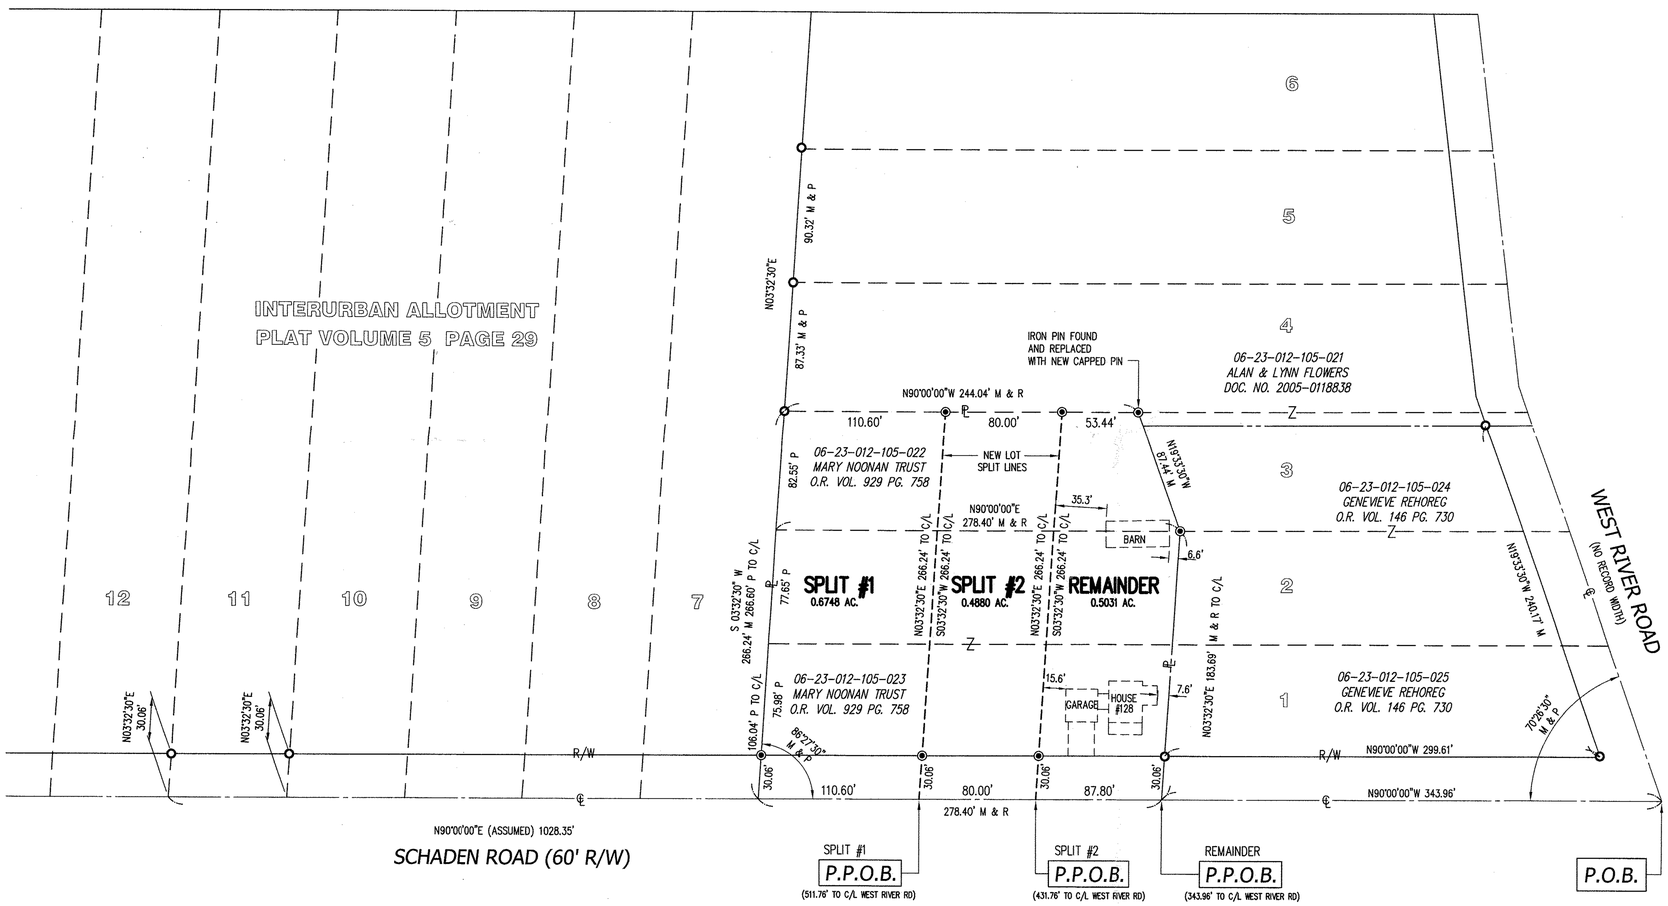

LEGEND OF SYMBOLS & LINETYPES

- EXISTING HYDRANT
- EXISTING WATER VALVE
- EXISTING STORM MANHOLE
- EXISTING SANITARY MANHOLE
- EXISTING CATCH BASIN
- EXISTING CURB INLET
- PROPOSED HYDRANT
- PROPOSED WATER VALVE
- PROPOSED STORM MANHOLE
- PROPOSED SANITARY MANHOLE
- PROPOSED CATCH BASIN
- PROPOSED CURB INLET
- TREE
- WATER METER
- SIGN
- CLEAN OUT
- MONITOR WELL
- UTILITY POLE
- LIGHT POLE
- WATER WELL
- EXISTING (PROPOSED) SPOT GRADE ELEVATION
- DIRECTION OF SURFACE WATER RUNOFF
- PROPERTY LINE
- CENTERLINE
- RIGHT-OF-WAY LINE
- EASEMENT LINE
- SETBACK LINE
- FENCE
- IRON PIN FOUND
- IRON PIN SET 30" LONG, 5/8" REBAR WITH CAP STAMPED "HAYWOOD 8284"
- IRON PIN FOUND IN MONUMENT BOX
- PK NAIL FOUND
- PROPERTY CORNER NOT MONUMENTED
- IRON PIN SET IN MONUMENT BOX
- PK NAIL & DISK SET

R., REC. = RECORD M., MEAS. = MEASURED P. = PLAT
P.O.B. = PLACE OF BEGINNING P.P.O.B. = PRINCIPAL PLACE OF BEGINNING

SURVEYOR'S CERTIFICATION

THIS IS TO CERTIFY THAT AT THE REQUEST OF RICHARD VOLK I HAVE PREPARED THIS PLAT OF BOUNDARY AND LOT SPLIT SURVEY.

DIMENSIONS ARE IN FEET AND DECIMAL PARTS THEREOF. BEARINGS ARE TO AN ASSUMED MERIDIAN AND INTENDED TO DESCRIBE ANGLES ONLY. THE BASIS OF BEARINGS IS N 90°00'00" E (ASSUMED) FOR SCHADEN ROAD.

THIS PLAT REPRESENTS A SURVEY IN WHICH THE TRAVERSE OF THE EXTERIOR BOUNDARIES OF THE TRACT WHEN COMPUTED FROM FIELD MEASUREMENTS CLOSED TO WITHIN A LIMIT OF ERROR OF ONE (1) FOOT TO TEN THOUSAND (10,000) FEET OF THE PERIMETER BEFORE BALANCING THE SURVEY.

THE SURVEY MEETS THE MINIMUM STANDARDS FOR LAND SURVEYS, IN SECTION 4733-37 OF THE OHIO ADMINISTRATIVE CODE. ADJACENT PROPERTY DESCRIPTIONS HAVE BEEN CONSIDERED IN PERFORMING THIS SURVEY. THIS SURVEY HAS NOT BEEN PERFORMED WITH THE BENEFIT OF A TITLE SEARCH AND THE LOCATION OF EASEMENTS THAT MAY AFFECT THE PROPERTY ARE NOT NOTED ON THE PLAT.

FIELD SURVEY DATE: JUNE 7, 2007

DRAWING REVISION DATE: JUNE 8, 2007

STATE OF OHIO
DALE R. HAYWOOD
S-8284
REGISTERED
PROFESSIONAL SURVEYOR

Dale Haywood

Dale R. Haywood, P.S.
Registered State of Ohio Surveyor No. 8284

ADDITIONS OR DELETIONS TO THIS PLAT BY OTHER THAN THE SIGNING PARTY ARE PROHIBITED WITHOUT WRITTEN CONSENT BY THE SIGNING PARTY.

THIS SURVEY PLAT IS NOT VALID WITHOUT AN ORIGINAL SIGNATURE AND SEAL OF THE SIGNING PARTY.

Boundary & Lot Split Survey

0 25 50 100 200
SCALE: 1 IN. = 50 FT.

BASIS OF BEARINGS
N 90°00'00" E
(ASSUMED)
SCHADEN ROAD

№ 02553
APPROVED
LORAIN CO.
MAP DEPT
DATE 4-18-08
06-23-012-105-022,023
PAGE 6-28
BY J.Hatfield
08-02553

APPROVED BY PLANNING COMMISSION
CITY of ELYRIA, OH
NO PLAT REQUIRED **DATE**
Phillip A. Lake 4-15-08

Prepared By

HAYWOOD
Civil Engineering & Land Surveying, Inc.

475 N. Abbe Road
Elyria, Ohio 44035
www.haywoodcivilengineering.com
(440) 365-9831 Office
(440) 365-3426 Fax

Prepared For

Richard Volk
128 Schaden Road
Elyria, Ohio 44035
(440) 965-4352

PROJECT #07-485